ABM INFO		SHIP	BILL OF MATERIAL						JOB NO.	DRAWING NO.	REV.
									498	205	
PAGE	LINE	MARK	QTY	MARK	MATERIAL	LENGTH FT	LENGTH INCHES	REMARKS	WT	PROCUREMENT NOTES	
		205S5	1		STRINGER				10134		
201	J		1	wa	W 36x150	66	$7\frac{3}{16}$	M270-50WT2			
202	B		1	x201a	PL $\frac{1}{2}$x5	2	10	M1E M270-50W			
202	C		5	x201c	PL $\frac{1}{2}$x5	2	10	M270-50W			

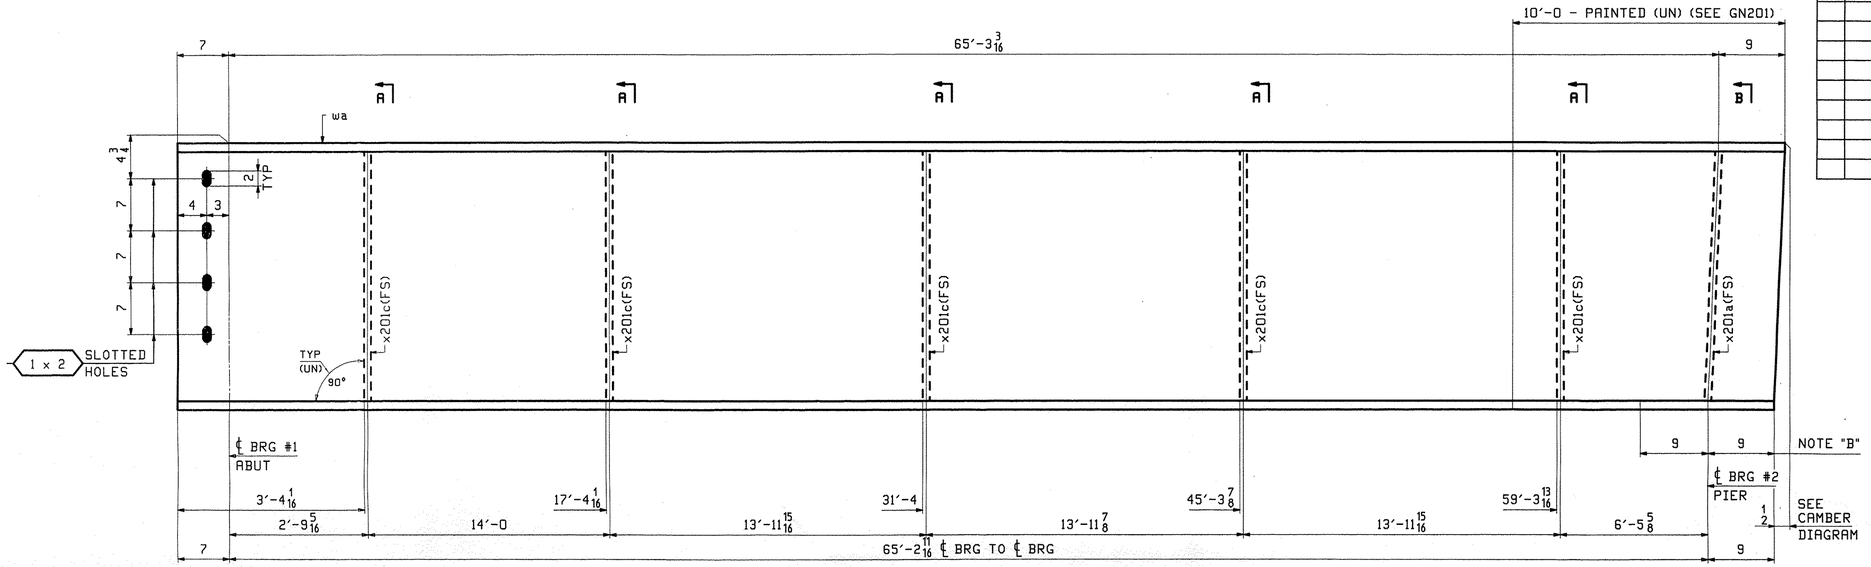

ONE - STRINGER - 205S5

FOR STANDARD DETAILS SEE DRAWING X201.
FOR CAMBER DIAGRAM SEE DRAWING C201.
FOR GENERAL NOTES SEE DRAWING GN201.
T2 DENOTES MATERIAL SUBJECT TO CHARPY V-NOTCH TESTING.

NOTE "B"
NO PAINT AREA AT EDGES AND BOTTOM OF BOTTOM FLANGE.
(FIELD WELDED SOLE PLATE).

VTrans Received NOV 14 2011 OK'D BY WBP

Resubmit BY ____ APPROVED DATE 11/16/11

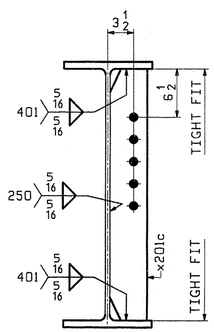

SECTION A

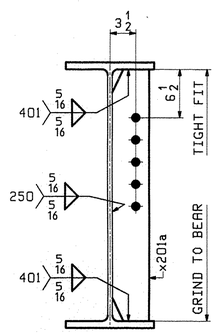

SECTION B

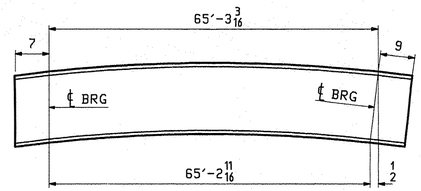

ORIENTATION DIAGRAM
FOR CAMBER SEE DWG C201

NOV 8 2011

REV.	DATE	REMARKS	DWN	CHK	APVL	SHOP
0						

MATERIAL:	SURFACE PREP. & PAINT:	HOLES:	SHOP BOLTS:
M270-50W	SEE DWG GN201	$\frac{15}{16}$"Ø	NONE

DESCRIPTION: STRINGER - 205S5

CASCO BAY STEEL STRUCTURES, INC.
1 WALLACE AVE. PHONE (207) 780-6722
SOUTH PORTLAND, ME 04106 FAX. (207) 780-6726
TENSOR 3073A

STRUCTURE: VT 107 (RIVER STREET) over WHITE RIVER APPROACH SPAN County of WINDSOR		DRAWN: JTB	DATE: 09/29
		CHKD: PCP	DATE: 10/4/11
LOCATION:	TOWN OF BETHEL, VERMONT	JOB NO.	DWG NO.
PROJ NO.	BRF 022-1(14)	498	205
CUSTOMER:	BECK & BELLUCCI		REV. △

JTB Tue, Oct 4, 2011 08:50:50 AM /users/jobs/20295/205 - Rev.0