


**PLAN VIEW**

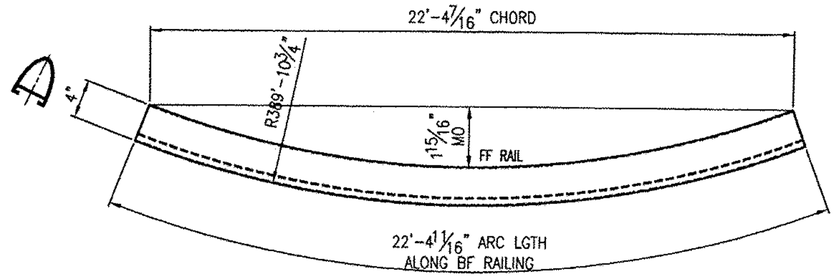


**REAR ELEVATION**

**ONE REQ'D ~ COMPOUND BENT TOP RAIL 'TA13'**
(22-4 11/16" LGTH ALONG LONGEST EDGE)




**PLAN VIEW**

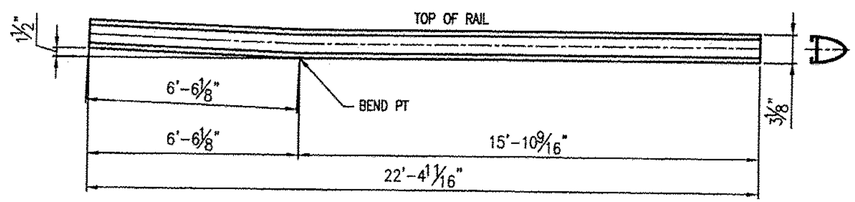


**REAR ELEVATION**

**ONE REQ'D ~ COMPOUND BENT MIDDLE RAIL 'MA13'**
(22'-4 15/16" LGTH ALONG LONGEST EDGE)

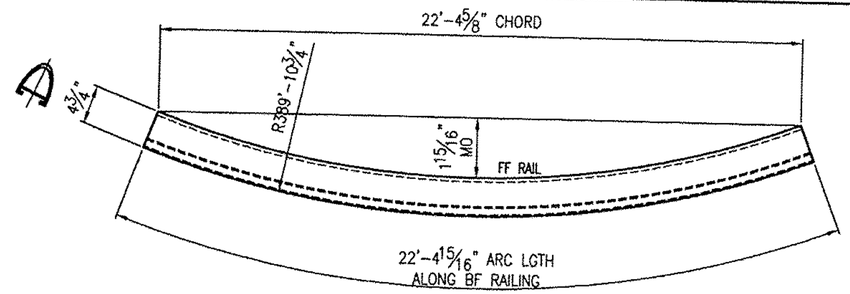


**PLAN VIEW**

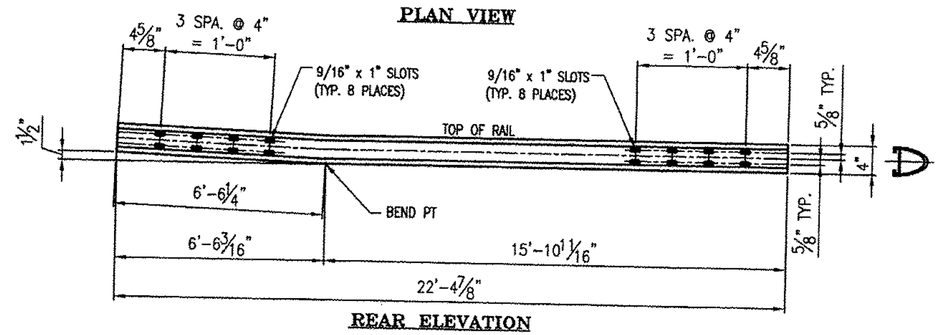


**REAR ELEVATION**

**ONE REQ'D ~ COMPOUND BENT BOTTOM RAIL 'BA13'**
(22'-5 1/8" LGTH ALONG LONGEST EDGE)

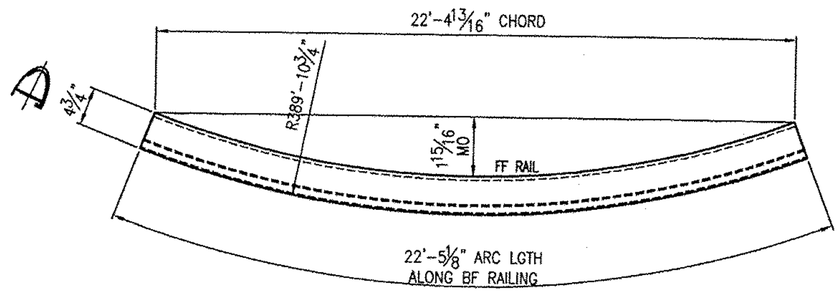


**TYPICAL WELD DETAIL**
**(OPTIONAL IF REQ'D.)**

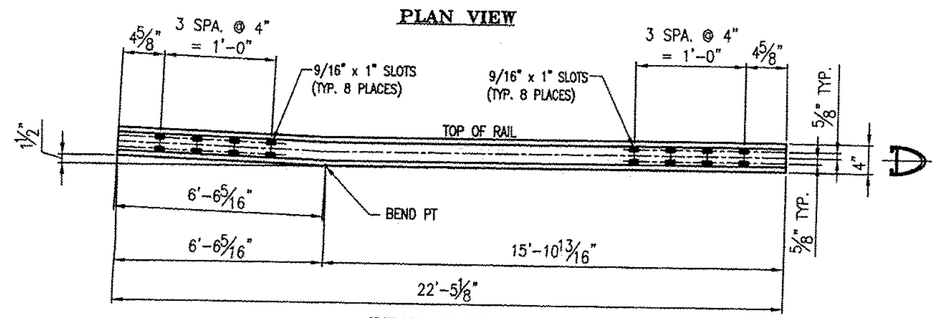RECEIVED
CK'D BY WRP OK'D BY SSS
OCT 24 2011
RESUBMIT _____ APPROVED ✓
BY DATE 11/1/2011

BRIDGE No. 15
PROJECT No. BRF 022-1 (14)
ITEM No: 525.23

| | |
|---|---|
| **LBFoster** Fabricated Bridge Products | L.B. FOSTER COMPANY 1016 GREENTREE RD. PITTSBURGH, PA 15220 |
| FOR: F. R. LAFAYETTE, INC. | |
| VERMONT AGENCY OF TRANSPORTATION | |
| TOWN OF BETHEL, WINDSOR COUNTY, VT | |
| 3-LINE ALUMINUM BRIDGE RAIL FOR VT ROUTE 7 | |
| (MINOR ARTERIAL)(SIDEWALK) – RAIL DETAILS | |
| MADE CMS DATE 09/20/11 JOB NO. AR0700 | |
| CHECK Dd DATE 10/12/11 DRAWING LB9 | REV. NO. |
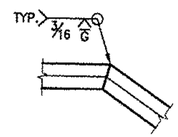
| REV. | DESCRIPTION | BY | DATE |
|---|---|---|---|
| | | | |