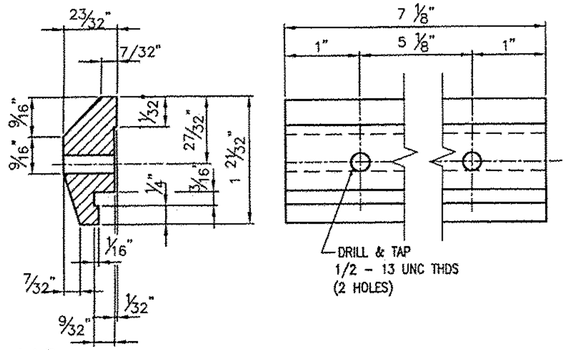

112 ~ REQ'D CLAMP
BAR CB-03-A
(BARRIER RAIL - 4 PER POST)
(#19447)

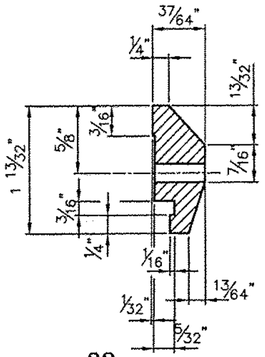

32 ~ REQ'D CLAMP
BAR CB-01-H
(HANDRAIL - 2 PER POST)
(#28596)

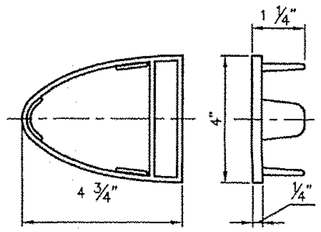

4 ~ REQ'D. ALUM
END CAPS EC2
#19345

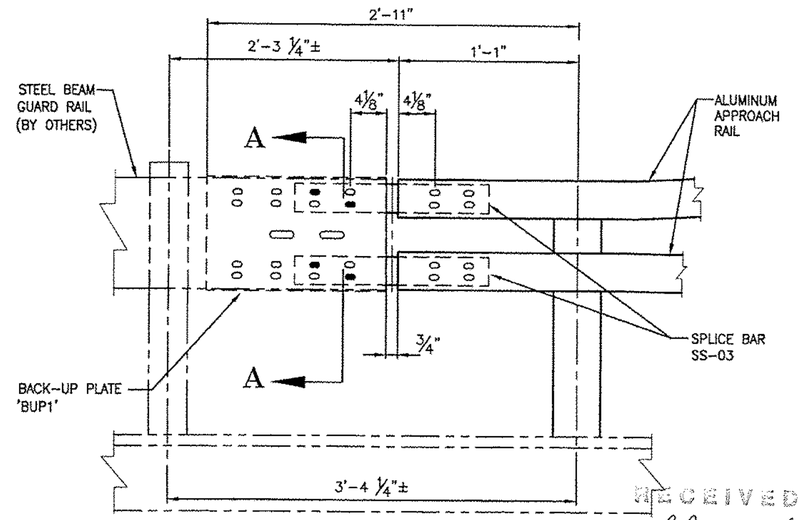

DETAIL "B"
(FRONT ELEVATION VIEW)

RECEIVED
CK'D BY MBP OK'D BY SSS
OCT 24 2011
RESUBMIT APPROVED
BY DATE 11/1/2011

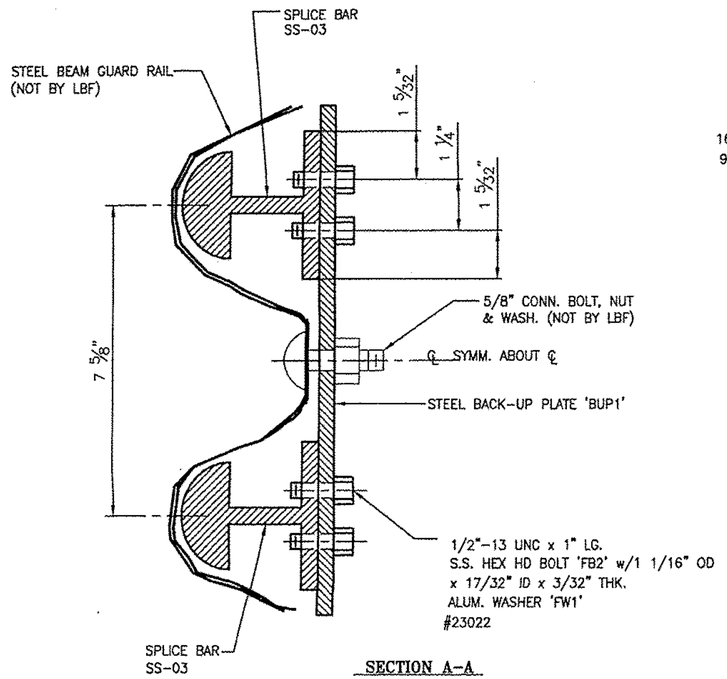

SECTION A-A

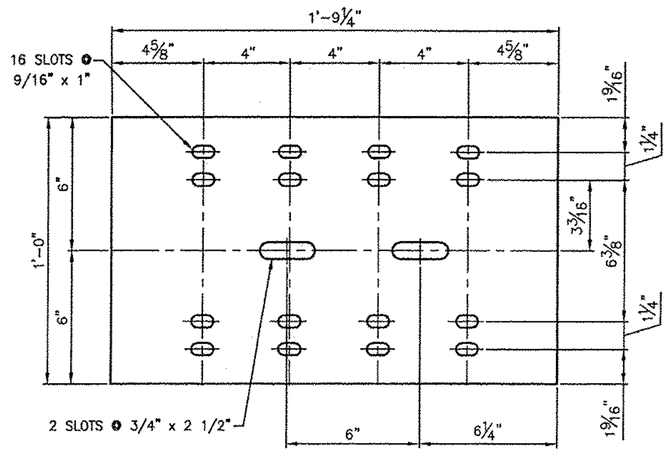

2 REQ'D. ~ BACK-UP PLATE BUP1
(1/4" THK. PLATE ~ A36 - GALV.)

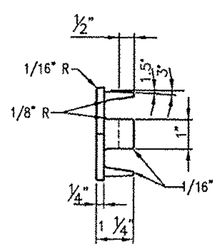

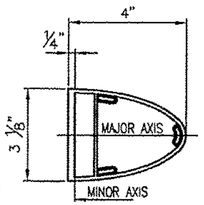

4 ~ REQ'D END CAPS (3 1/8" x 4") 'EC1'
#19344

BRIDGE No. 15
PROJECT No. BRF 022-1 (14) ITEM No: 621.74

LBFoster
Fabricated Bridge Products

L.B. FOSTER COMPANY
1016 GREENTREE RD.
PITTSBURGH, PA 15220

FOR: F. R. LAFAYETTE, INC.
VERMONT AGENCY OF TRANSPORTATION
TOWN OF BETHEL, WINDSOR COUNTY, VT
3-LINE ALUMINUM APPROACH RAIL FOR VT ROUTE 7
(MINOR ARTERIAL) - MISC DETAILS

MADE CMS DATE 09/22/11 JOB NO. AR0700
CHECK DD DATE 10/13/11 DRAWING LB25 (LAST) REV. NO.

REV.	DESCRIPTION	BY	DATE