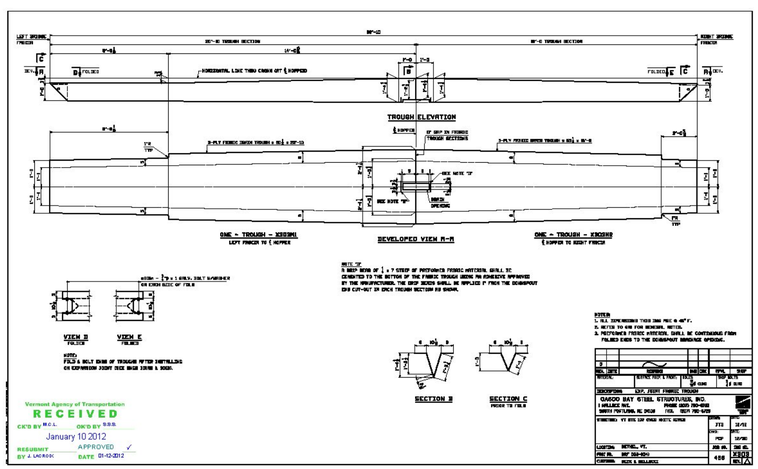
TROUGH ELEVATION
DEVELOPED VIEW A-A
ONE - TROUGH - XSSSMU
ONE - TROUGH - XSSSRS
VIEW B
VIEW E
SECTION B
SECTION C
NOTES
RECEIVED
January 10 2012
APPROVED
DATE: 01-12-2012