DETAIL B SHIPPING DEVICES

SCALE: 1/2" = 1'-0" WHEN ON 22X34

BILL OF MATERIAL																													
ITEM NO.	QUAN	UNIT	MAT	GRADE	DESCRIPTION																								

BILL OF MATERIAL																													
ITEM NO.	QUAN	UNIT	MAT	GRADE	DESCRIPTION																								
DTL	1				3/4 DIA																								
					1	6061T6	PIPE, 6X6X0																						
					1	6061T6	PIPE, 6X6X0																						

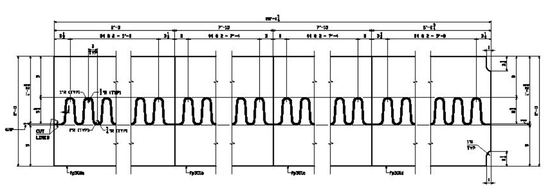

Vermont Agency of Transportation
RECEIVED
CK'D BY M.C.L. OK'D BY S.D.D.
January 10 2012
RESUBMIT BY A LACROIX APPROVED ✓
DATE 01-03-2012

NO.	DATE	REVISION	BY	CHK	APPR
2					
1					

DESIGN: 2009-20 GBI	DRAWN: 07-12-2 JPJ.A.	CHK'D: RS DATE: 8	APP DATE: RS DATE: 8

DESCRIPTION: COMPRESSOR FIELD & PILE CLEANING DR & DTL

QUADO BAY STEEL STRUCTURES, INC.
1 WALLACE RD. PHONE (207) 782-6150
SWEET PORTLAND, ME 04108 FAX: (207) 782-6172

STRUCTURE: VT RTE 100 OVER WHITE RIVER

DRN	FTJ	12/01
CHK	PCP	10/00
LOCATION: BETHEL, VT.	BRIDGE NO.	SHEET NO.
PROJ NO. BRF 2004-(29)	4.02	2006 SHT. 1
CONTRACT: DESIGN & DRAWINGS		