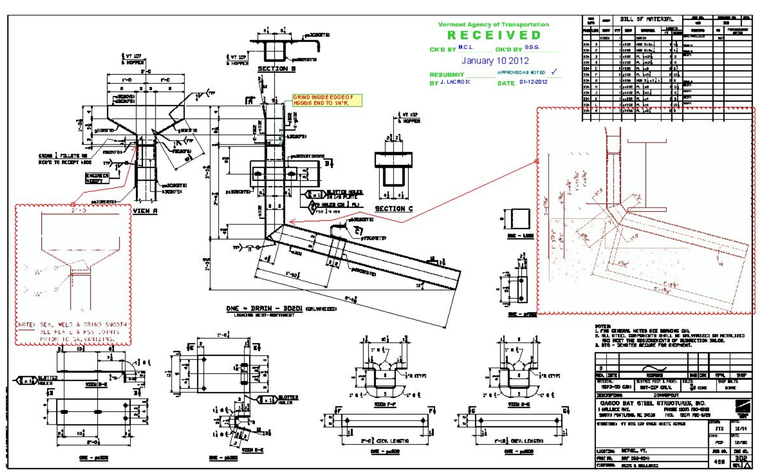
Vermont Agency of Transportation
RECEIVED
CK'D BY M.C.L.
OK'D BY S.S.S.
January 10 2012
RESUBMIT
BY J. LACROIX
APPROVED AS NOTED ✓
DATE 01-12-2012
BILL OF MATERIAL
SECTION B
SECTION C
VIEW A
ONE - 2000IN - 3D2D1
NOTES:
1. FOR GENERAL NOTES SEE DRAWING G01.
2. ALL STEEL COMPONENTS SHALL BE GALVANIZED OR METALIZED
AND MEET THE REQUIREMENTS OF SUBSECTION 708.05.
QUODDY BAY STEEL STRUCTURES, INC.
1 WALLACE RD.
SWITCH PORTLAND, ME 04038
PHONE (207) 741-0310
FAX (207) 741-4710
STRUCTURE: VT RTE 100 OVER WHITE RIVER
LOCATION: ROYAL, VT.
PROJ NO. BRF 2(6)+2(7)
CONTRACT: BRIDGE & ROADWAY
DATE 12/11
SCALE NTS
DRAWN MCP 10/98
DWG NO. 100
SHT. 1 OF 1