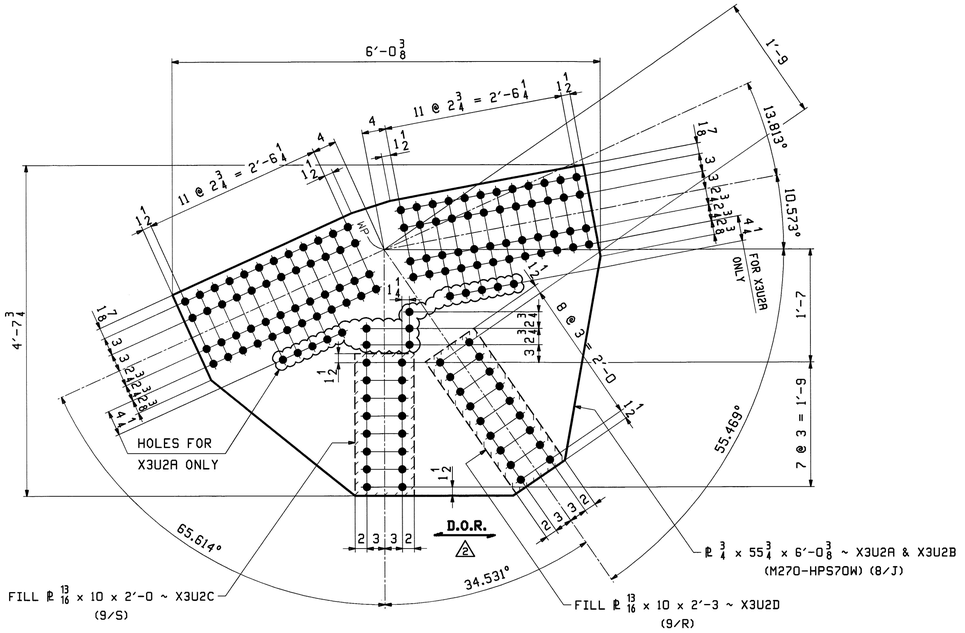

4 ~ GUSSET PLATE ~ X3U2A **8 ~ FILL PLATE ~ X3U2C**

INTERIOR GUSSET @ U2 & U8

4 ~ GUSSET PLATE ~ X3U2B **8 ~ FILL PLATE ~ X3U2D**

EXTERIOR GUSSET @ U2 & U8

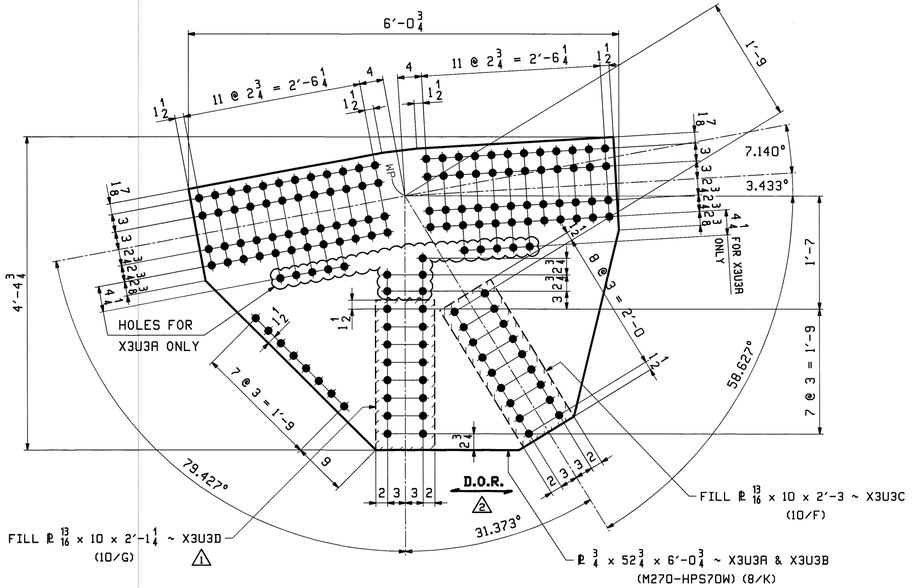

4 ~ GUSSET PLATE ~ X3U3A **8 ~ FILL PLATE ~ X3U3C**

INTERIOR GUSSET @ U3 & U7

4 ~ GUSSET PLATE ~ X3U3B **8 ~ FILL PLATE ~ X3U3D**

EXTERIOR GUSSET @ U3 & U7

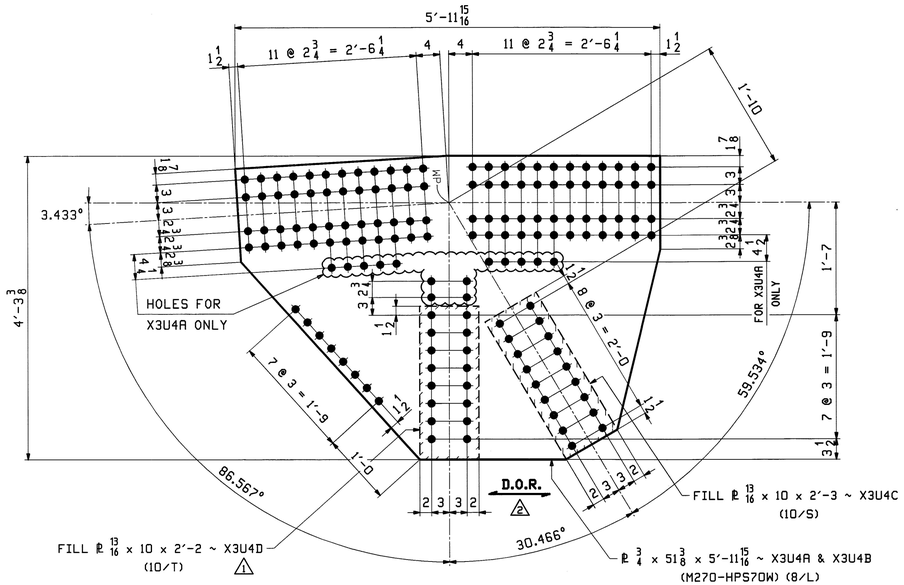

4 ~ GUSSET PLATE ~ X3U4A **8 ~ FILL PLATE ~ X3U4C**

INTERIOR GUSSET @ U4 & U6

4 ~ GUSSET PLATE ~ X3U4B **8 ~ FILL PLATE ~ X3U4D**

EXTERIOR GUSSET @ U4 & U6

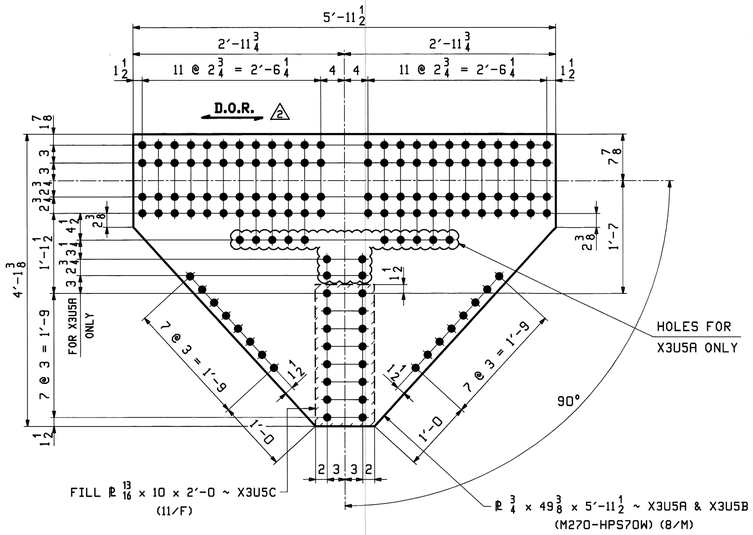

2 ~ GUSSET PLATE ~ X3U5A

INTERIOR GUSSET @ U5

2 ~ GUSSET PLATE ~ X3U5B

EXTERIOR GUSSET @ U5

4 ~ FILL PLATE ~ X3U5C

Vermont Agency of Transportation

RECEIVED

CK'D BY M.C.L. OK'D BY S.S.S.

January 10 2012

RESUBMIT APPROVED ✓

BY J. LACROIX DATE 01-12-2012

JAN 9 2012

DEC 2 2011

NOV 30 2011

NOV 18 2011

NOTES:

1. FOR GENERAL NOTES SEE SHEET GN1.
2. D.O.R. - DENOTES DIRECTION OF ROLLING.

REV.	DATE	REMARKS	DWN	CHK	APVL	SHOP
2	12/1/11	ADD D.O.R.	EEO	PCP		
1	11/22/11	REV'D MARKS	EEO	PCP		
0						

MATERIAL:	SURFACE PREP. & PAINT:	HOLES:	SHOP BOLTS:
M270-50 (UN)	HOT-DIP GALV.	15/16ø (UN)	NONE

DESCRIPTION: TRUSS STANDARDS

CASCO BAY STEEL STRUCTURES, INC.
1 WALLACE AVE. PHONE (207) 780-6722
SOUTH PORTLAND, ME 04106 FAX. (207) 780-6726

TENSOR 3073

STRUCTURE: VT RTE 107 OVER WHITE RIVER		DRAWN: EEO	DATE: 10/07
		CHK'D: PCP	DATE: 10/11
LOCATION: BETHEL, VT.		JOB NO.	DWG NO.
PROJ NO.	BRF 022-1(14)	498	X3
CUSTOMER:	BECK & BELLUCCI		REV. 2

RCP Thu, Dec 1, 2011 03:21:05 PM //users/pbw/3073/X3.dwg Rev2