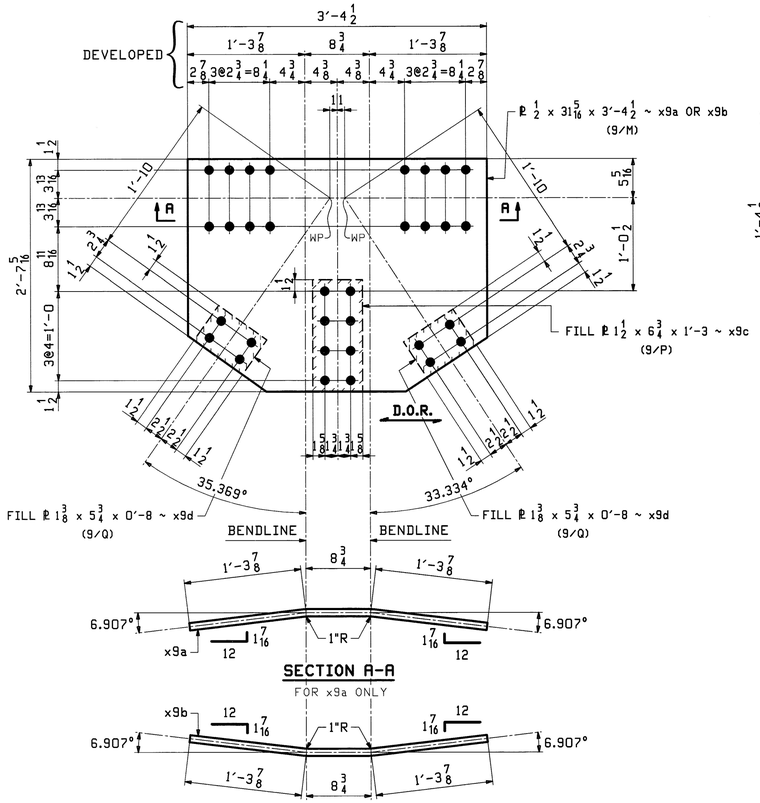





## 2 ~ GUSSET PLATE ~ x9a

TOP GUSSET @ U2 (WEST TRUSS) & U8 (EAST TRUSS)

## 2 ~ GUSSET PLATE ~ x9b

TOP GUSSET @ U2 (EAST TRUSS) & U8 (WEST TRUSS)

## 4 ~ FILL PLATE ~ x9c

## 8 ~ FILL PLATE ~ x9d

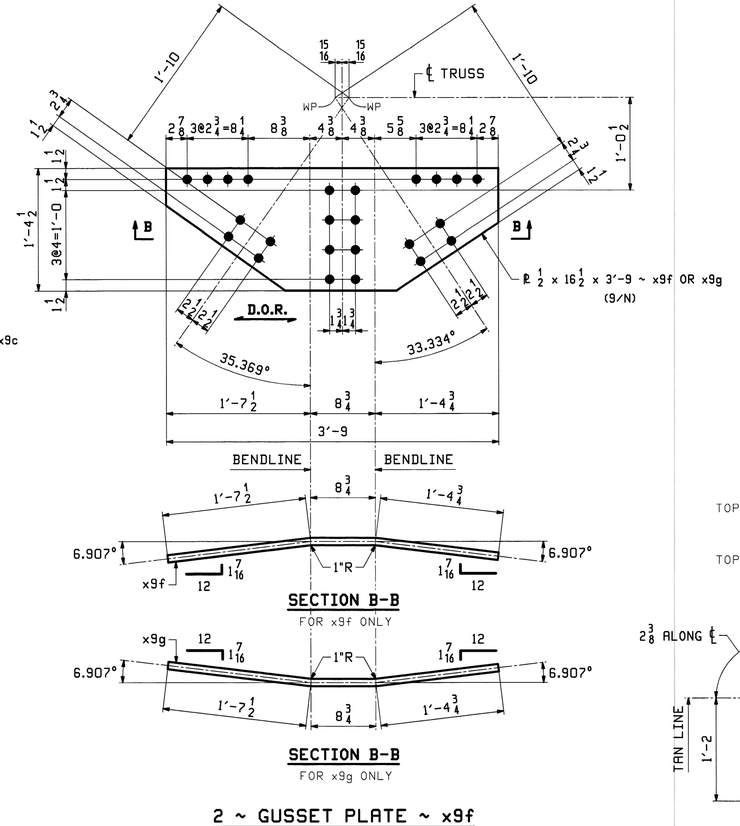





## 2 ~ GUSSET PLATE ~ x9f

TOP GUSSET @ U2 (WEST TRUSS) & U8 (EAST TRUSS)

## 2 ~ GUSSET PLATE ~ x9g

TOP GUSSET @ U2 (EAST TRUSS) & U8 (WEST TRUSS)

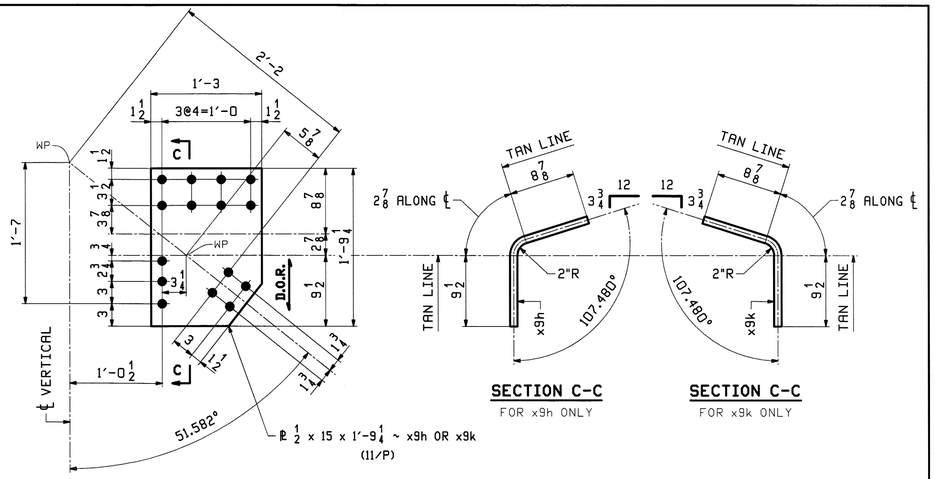


## 2 ~ GUSSET PLATE ~ x9h

TOP CORNER SWAY GUSSET @ U2 (WEST TRUSS) & U8 (EAST TRUSS)

## 2 ~ GUSSET PLATE ~ x9k

TOP CORNER SWAY GUSSET @ U2 (EAST TRUSS) & U8 (WEST TRUSS)

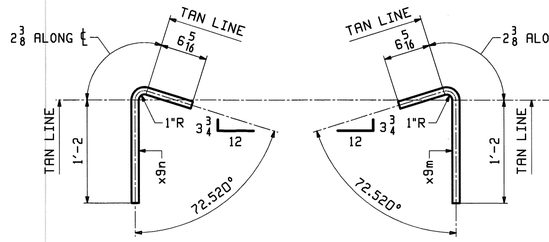


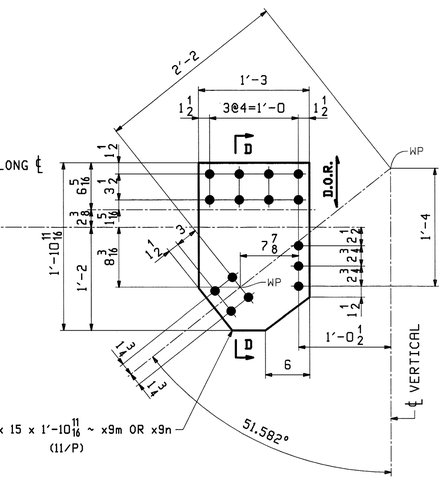


## 2 ~ GUSSET PLATE ~ x9m

TOP CORNER SWAY GUSSET @ U2 (WEST TRUSS) & U8 (EAST TRUSS)

## 2 ~ GUSSET PLATE ~ x9n

TOP CORNER SWAY GUSSET @ U2 (EAST TRUSS) & U8 (WEST TRUSS)

Vermont Agency of Transportation

**RECEIVED**

CK'D BY M.C.L. OK'D BY S.S.S.

January 10 2012

RESUBMIT APPROVED ✓

BY J. LACROIX DATE 01-12-2012

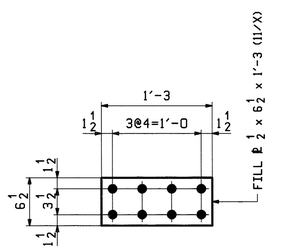


## 4 ~ FILL PLATE ~ x9p

TOP CORNER SWAY FILL PL @ U2 & U8

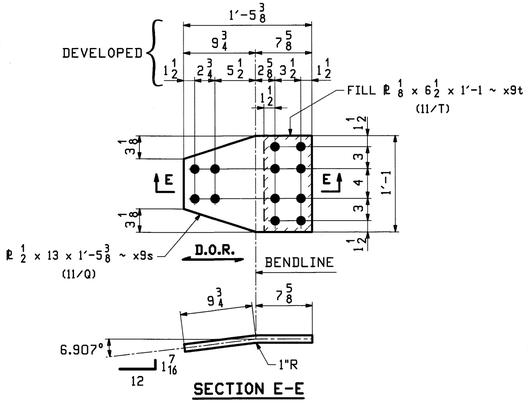


## 2 ~ GUSSET PLATE ~ x9s

TOP GUSSET @ LONG. STRUT (U2 & U8)

## 2 ~ FILL PLATE ~ x9t

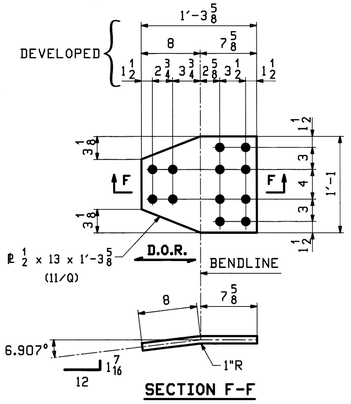


## 2 ~ GUSSET PLATE ~ x9v

BTM GUSSET @ LONG. STRUT (U2 & U8)

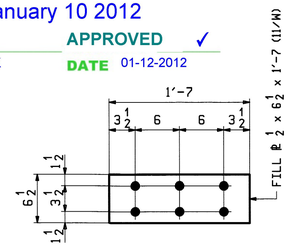


## 4 ~ FILL PLATE ~ x9w

FILL PL @ BTM OF TOP STRUT (U2 & U8)

NOTES:

1. FOR GENERAL NOTES SEE SHEET GN1.
2. D.O.R. - DENOTES DIRECTION OF ROLLING.

| REV. | DATE | REMARKS | DWN | CHK | APVL | SHOP |
|---|---|---|---|---|---|---|
| | | | | | JAN 9 2012 | |
| 0 | | | | | NOV 18 2011 | |

| MATERIAL: | SURFACE PREP. & PRINT: | HOLES: | SHOP BOLTS: |
|---|---|---|---|
| M270-50 (UN) | HOT-DIP GALV. | 15/16 Ø (UN) | 7/8 Ø (UN) |

DESCRIPTION: TOP STRUT STANDARDS


CASCO BAY STEEL STRUCTURES, INC.
1 WALLACE AVE. PHONE (207) 780-6722
SOUTH PORTLAND, ME 04106 FAX. (207) 780-6726


TENSOR 3073

| | | | |
|---|---|---|---|
| STRUCTURE: VT RTE 107 OVER WHITE RIVER | DRAWN: EEO | DATE: 10/17 | |
| | CHKD: PCP | DATE: 10/31 | |
| LOCATION: BETHEL, VT. | JOB NO. | DWG NO. | |
| PROJ NO. BRF 022-1(14) | 498 | X9 | |
| CUSTOMER: BECK & BELLUCCI | | REV. △ | |

ECO Thu, Nov 17, 2011 10:07:39 PM //users/jobs/3073/x9 - Rev0