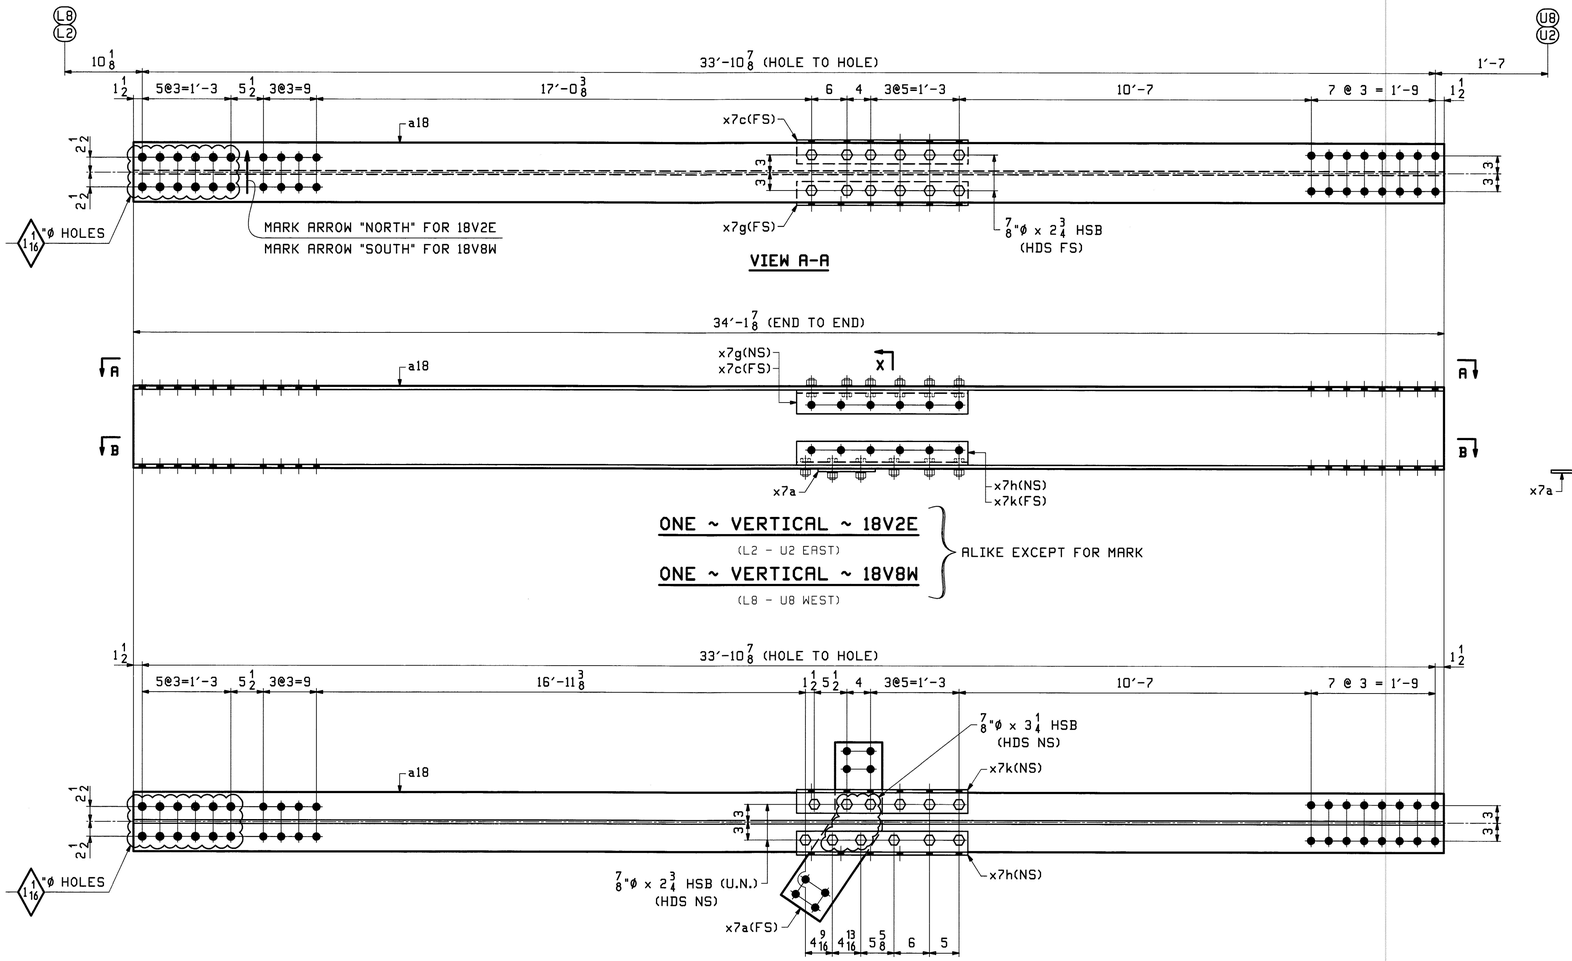

ABM INFO		SHIP	BILL OF MATERIAL			LENGTH		JOB NO. 498	DRAWING NO. 18	REV.
PAGE	LINE	MARK	QTY	MARK	MATERIAL	FT	INCHES	REMARKS	WT	PROCUREMENT NOTES
		18V2E	1		VERTICAL				2303	
6	J		1	a18	W 14x61	34	1 7/8	M270-50T2		
4	V		1	x7a	PL 1/2x17 1/8	2	6 1/4			
4	R		1	x7c	L 4x4x1/2	2	5	M270-36		
4	R		1	x7g	L 4x4x1/2	2	5	M270-36		
4	R		1	x7h	L 4x4x1/2	2	5	M270-36		
4	R		1	x7k	L 4x4x1/2	2	5	M270-36		
21	E		20		7/8 ø HSB	0	2 3/4	MECH. GALV. A325-1		
21	G		4		7/8 ø HSB	0	3 1/4	MECH. GALV. A325-1		
21	X		24		7/8 ø HSW			MECH. GALV. F436		
21	Y		24		LOAD IND. 7/8 ø HSB WASH FOR			MECH. GALV. F436		
		18V8W	1		VERTICAL				2303	
6	J		1	a18	W 14x61	34	1 7/8	M270-50T2		
4	V		1	x7a	PL 1/2x17 1/8	2	6 1/4			
4	R		1	x7c	L 4x4x1/2	2	5	M270-36		
4	R		1	x7g	L 4x4x1/2	2	5	M270-36		
4	R		1	x7h	L 4x4x1/2	2	5	M270-36		
4	R		1	x7k	L 4x4x1/2	2	5	M270-36		
21	E		20		7/8 ø HSB	0	2 3/4	MECH. GALV. A325-1		
21	G		4		7/8 ø HSB	0	3 1/4	MECH. GALV. A325-1		
21	X		24		7/8 ø HSW			MECH. GALV. F436		
21	Y		24		LOAD IND. 7/8 ø HSB WASH FOR			MECH. GALV. F436		

NOTES:
1. FOR GENERAL NOTES SEE SHEET GN1.

Vermont Agency of Transportation
RECEIVED
CK'D BY M.C.L. OK'D BY S.S.S.
January 10 2012
RESUBMIT APPROVED ✓
BY J. LACROIX DATE 01-12-2012

REV.	DATE	REMARKS	DWN	CHK	APVL	SHOP
					JAN 9 2012	
0					NOV 18 2011	

MATERIAL:	SURFACE PREP. & PAINT:	HOLES:	SHOP BOLTS:
M270-50 (UN)	HOT-DIP GALV.	15/16ø (UN)	7/8ø (UN)

DESCRIPTION: VERTICALS (L2-U2, L8-U8)

CASCO BAY STEEL STRUCTURES, INC.
1 WALLACE AVE. PHONE (207) 780-6722
SOUTH PORTLAND, ME 04106 FAX. (207) 780-6726
TENSOR 3073

STRUCTURE: VT RTE 107 OVER WHITE RIVER	DRAWN: EEO	DATE: 10/12
	CHKD: PCP	DATE: 10/14
LOCATION: BETHEL, VT.	JOB NO.	DWG NO.
PROJ NO. BRF 022-1(14)	498	18
CUSTOMER: BECK & BELLUCCI		REV. △

EEO Thu, Nov 17, 2011 08:57:18 PM //casc/jobs/3073/18.dwg