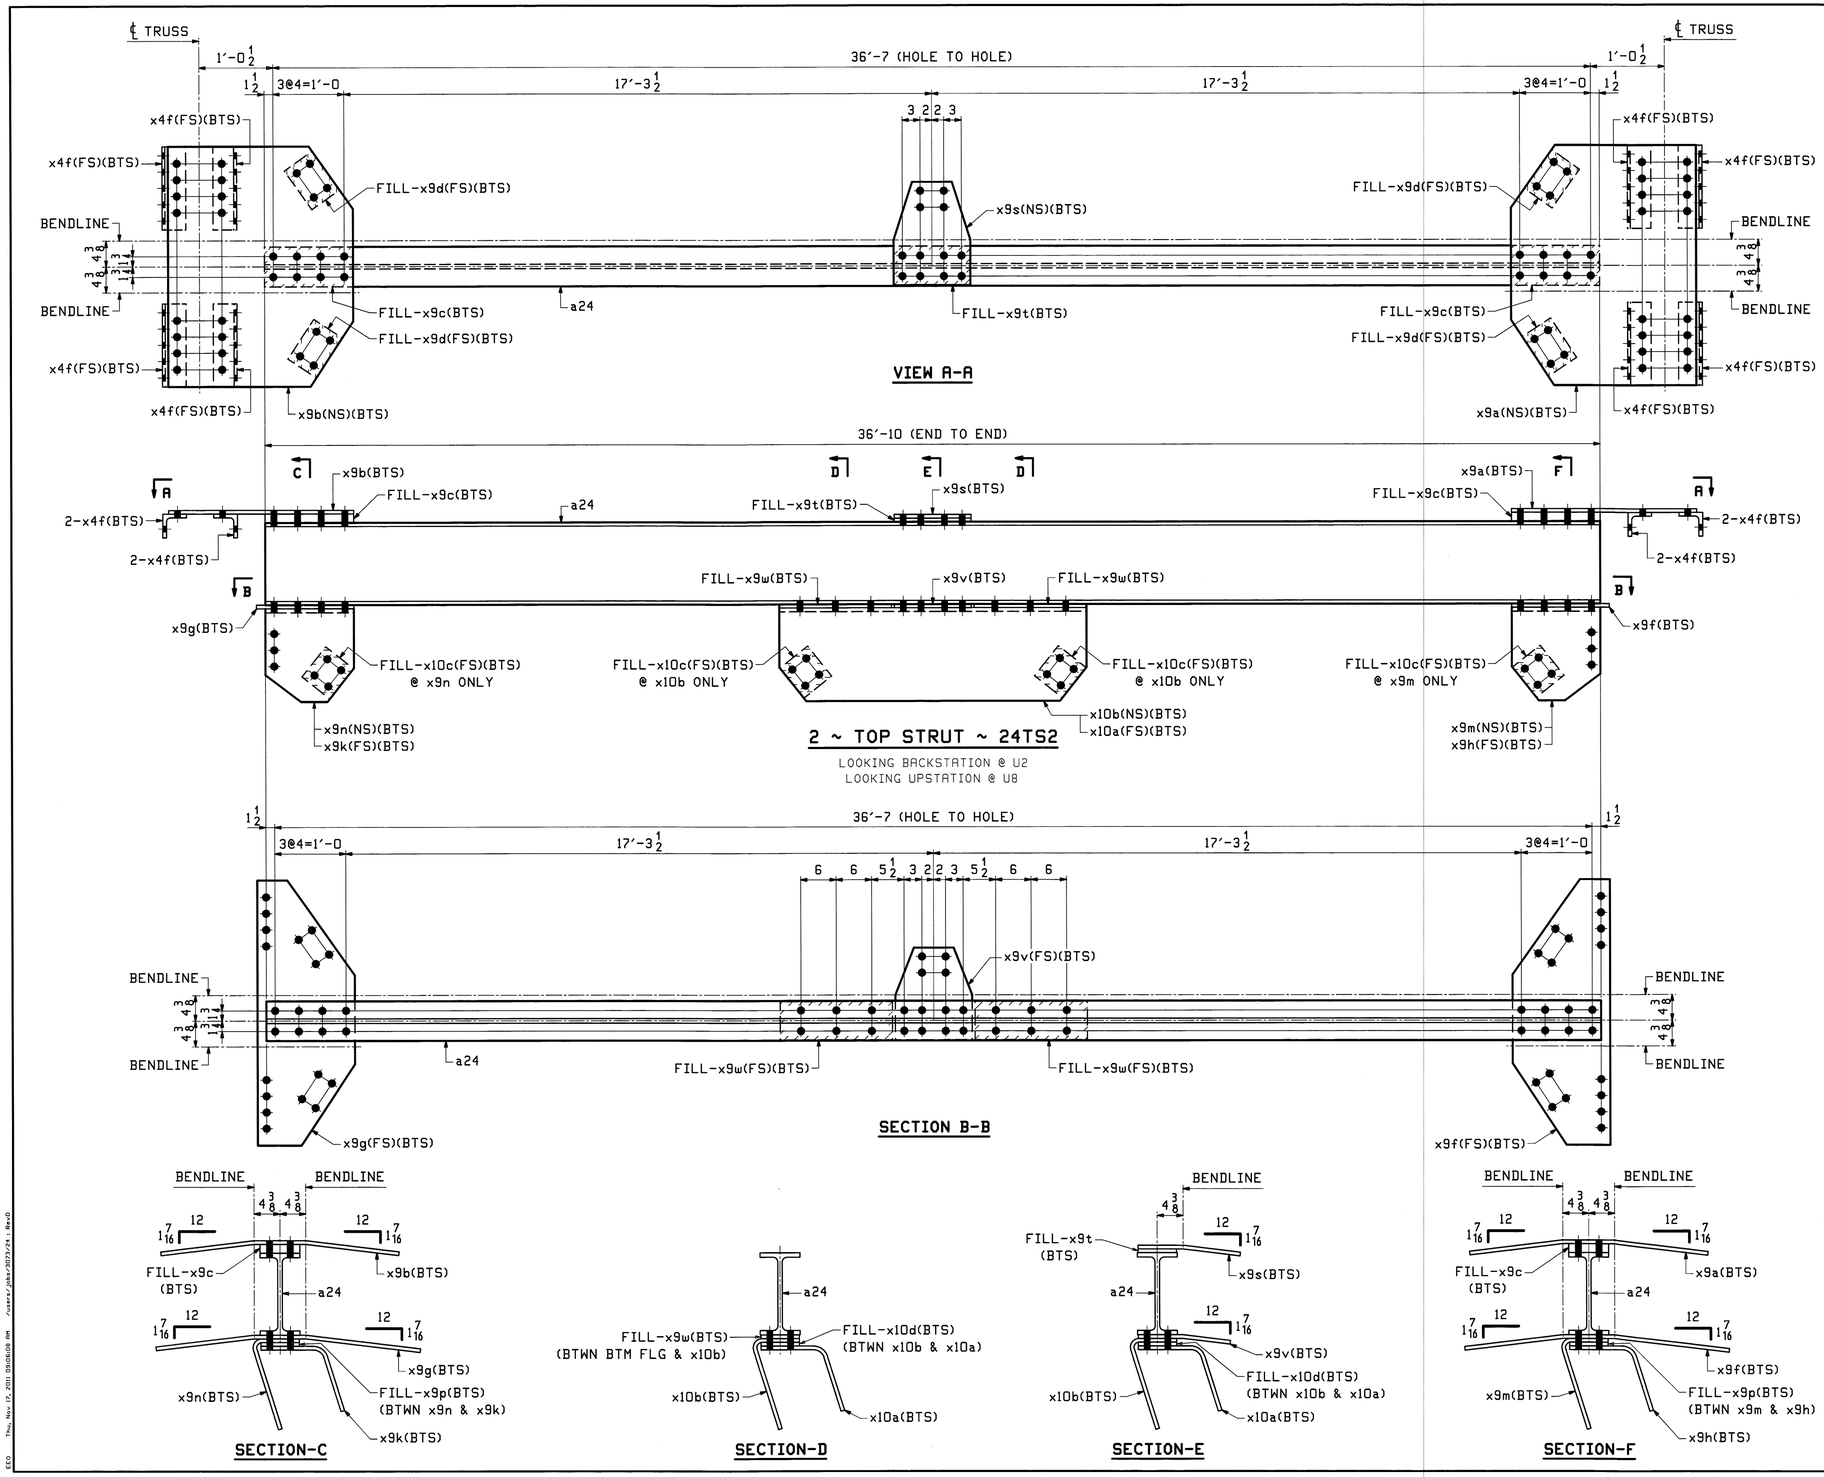

ABM INFO		SHIP	BILL OF MATERIAL						JOB NO. 498	DRAWING NO. 24	REV.
PAGE	LINE	MARK	QTY	MARK	MATERIAL	LENGTH FT	LENGTH INCHES	REMARKS	WT	PROCUREMENT NOTES	
		24TS2	2		TOP STRUT				2762		
6	X		2	a24	W 14x30	36	10				
9	U		16	x4f	L 4x4x$\frac{1}{2}$	1	2	M270-36			
9	M		2	x9a	PL $\frac{1}{2}$x31$\frac{5}{16}$	3	4$\frac{1}{2}$	BENT			
9	M		2	x9b	PL $\frac{1}{2}$x31$\frac{5}{16}$	3	4$\frac{1}{2}$	BENT			
9	P		4	x9c	PL 1$\frac{1}{2}$x6$\frac{3}{4}$	1	3	FILL			
9	Q		8	x9d	PL 1$\frac{3}{8}$x5$\frac{3}{4}$	0	8	FILL			
9	N		2	x9f	PL $\frac{1}{2}$x16$\frac{1}{2}$	3	9	BENT			
9	N		2	x9g	PL $\frac{1}{2}$x16$\frac{1}{2}$	3	9	BENT			
11	P		2	x9h	PL $\frac{1}{2}$x15	1	9$\frac{1}{4}$	BENT			
11	P		2	x9k	PL $\frac{1}{2}$x15	1	9$\frac{1}{4}$	BENT			
11	P		2	x9m	PL $\frac{1}{2}$x15	1	10$\frac{11}{16}$	BENT			
11	P		2	x9n	PL $\frac{1}{2}$x15	1	10$\frac{11}{16}$	BENT			
11	X		4	x9p	PL $\frac{1}{2}$x6$\frac{1}{2}$	1	3	FILL			
11	Q		2	x9s	PL $\frac{1}{2}$x13	1	5$\frac{3}{8}$	BENT			
11	T		2	x9t	PL $\frac{1}{8}$x6$\frac{1}{2}$	1	1	FILL			
11	Q		2	x9v	PL $\frac{1}{2}$x13	1	3$\frac{5}{8}$	BENT			
11	W		4	x9w	PL $\frac{1}{2}$x6$\frac{1}{2}$	1	7	FILL			
11	M		2	x10a	PL $\frac{1}{2}$x52	1	9$\frac{1}{4}$	BENT			
11	M		2	x10b	PL $\frac{1}{2}$x52	1	10$\frac{11}{16}$	BENT			
11	S		8	x10c	PL 2$\frac{13}{16}$x6	0	6$\frac{1}{2}$	FILL			
11	V		2	x10d	PL $\frac{1}{2}$x6$\frac{1}{2}$	4	4	FILL			

Vermont Agency of Transportation
RECEIVED
CK'D BY M.C.L. OK'D BY S.S.S.
January 10 2012
RESUBMIT APPROVED ✓
BY J. LACROIX DATE 01-12-2012

NOTES:
1. FOR GENERAL NOTES SEE SHEET GN1.

REV.	DATE	REMARKS	DWN	CHK	APVL	SHOP
					JAN 9 2012	
0					NOV 18 2011	

MATERIAL:	SURFACE PREP. & PAINT:	HOLES:	SHOP BOLTS:
M270-50 (UN)	HOT-DIP GALV.	$\frac{15}{16}$Ø (UN)	NONE

DESCRIPTION: TOP STRUT 24TS2

CASCO BAY STEEL STRUCTURES, INC.
1 WALLACE AVE. PHONE (207) 780-6722
SOUTH PORTLAND, ME 04106 FAX. (207) 780-6726
TENSOR 3073

STRUCTURE: VT RTE 107 OVER WHITE RIVER		DRAWN: EEO	DATE: 10/17
		CHKD: PCP	DATE: 10/31
LOCATION:	BETHEL, VT.	JOB NO.	DWG NO.
PROJ NO.	BRF 022-1(14)	498	24
CUSTOMER:	BECK & BELLUCCI		REV. △

EEO Thu, Nov 17, 2011 09:06:08 AM /users/jobs/2013/24/ Rev0