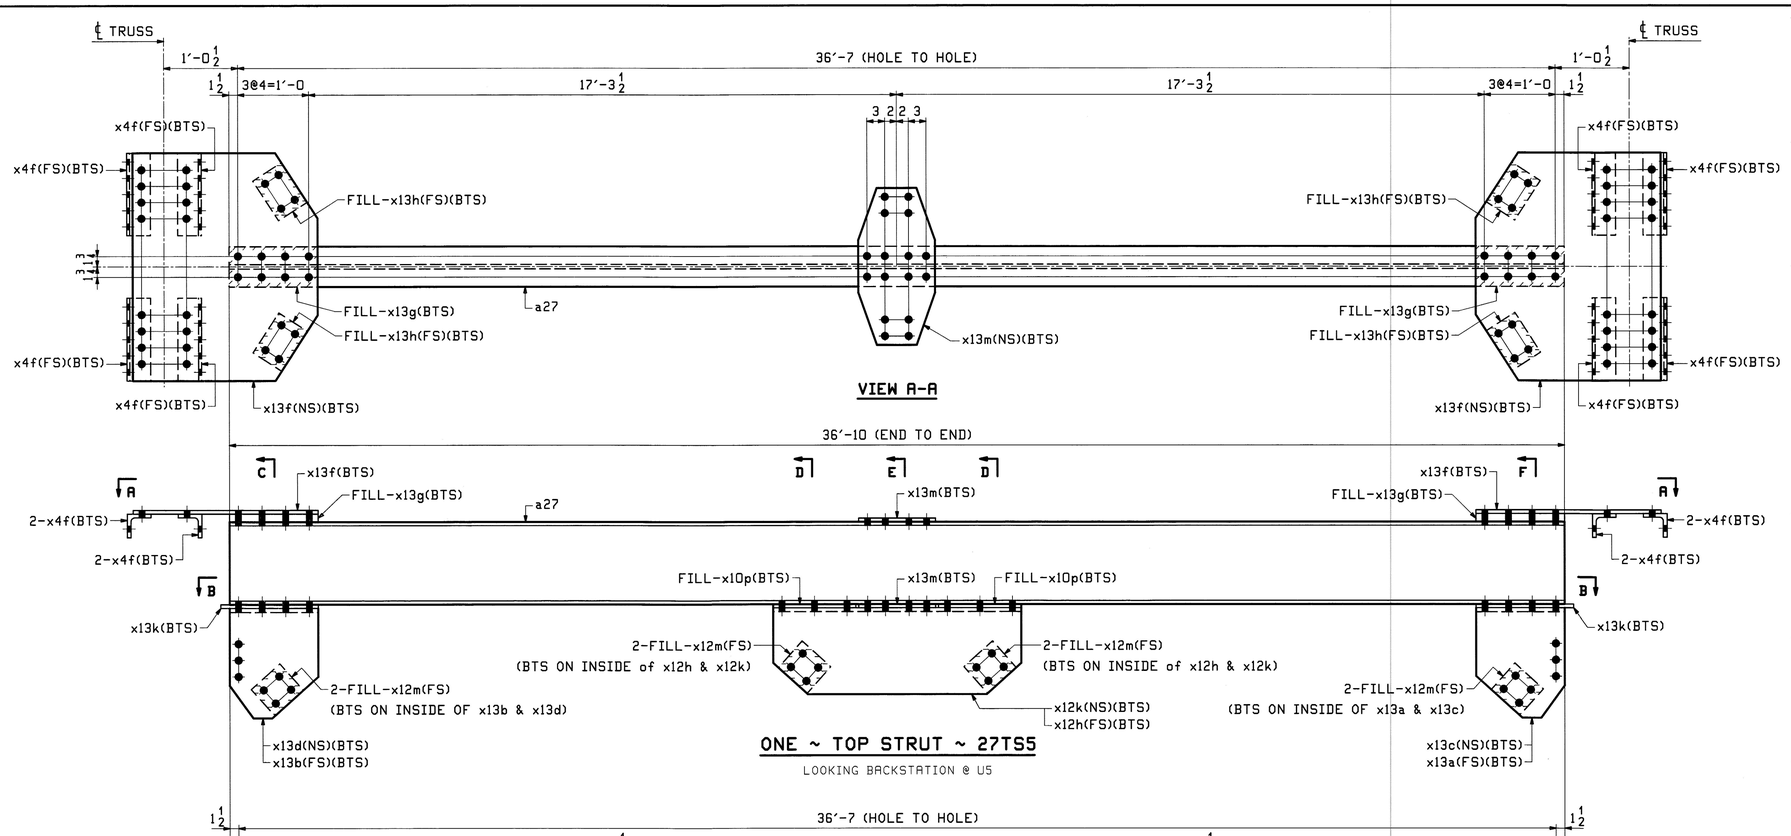

ABM INFO		SHIP	BILL OF MATERIAL					JOB NO.	DRAWING NO.	REV.
								498	27	
PAGE	LINE	MARK	QTY	MARK	MATERIAL	LENGTH FT	LENGTH INCHES	REMARKS	WT	PROCUREMENT NOTES
		27TS5	1		TOP STRUT				2501	
6	X		1	a27	W 14x30	36	10			
11	H		8	x4f	L 4x4x 1/2	1	2	M270-36		
13	J		2	x10p	PL 1/2x6 1/2	1	2	FILL		
13	B		1	x12h	PL 1/2x42	1	8 13/16	BENT		
13	B		1	x12k	PL 1/2x42	1	9 5/16	BENT		
13	K		8	x12m	PL 3/16x6	0	6 1/2	FILL		
13	D		1	x13a	PL 1/2x15	2	0 13/16	BENT		
13	D		1	x13b	PL 1/2x15	2	0 13/16	BENT		
13	D		1	x13c	PL 1/2x15	2	1 5/16	BENT		
13	D		1	x13d	PL 1/2x15	2	1 5/16	BENT		
11	B		2	x13f	PL 1/2x31 5/16	3	2 1/2			
11	D		2	x13g	PL 1 3/8x6 3/4	1	3	FILL		
11	E		4	x13h	PL 1 3/8x5 3/4	0	8	FILL		
11	C		2	x13k	PL 1/2x16 1/2	3	2 1/2			
13	E		2	x13m	PL 1/2x13	2	2 1/2			

Vermont Agency of Transportation
RECEIVED
CK'D BY M.C.L. OK'D BY S.S.S.
January 10 2012
RESUBMIT APPROVED ✓
BY J. LACROIX DATE 01-12-2012

NOTES:
1. FOR GENERAL NOTES SEE SHEET GN1.

REV.	DATE	REMARKS	DWN	CHK	APVL	SHOP
					JAN 9 2012	
0					NOV 18 2011	

MATERIAL:	SURFACE PREP. & PAINT:	HOLES:	SHOP BOLTS:
M270-50 (UN)	HOT-DIP GALV.	15/16ø (UN)	7/8ø (UN)

DESCRIPTION: TOP STRUT 27TS5

CASCO BAY STEEL STRUCTURES, INC.
1 WALLACE AVE. PHONE (207) 780-6722
SOUTH PORTLAND, ME 04106 FAX. (207) 780-6726
TENSOR 3073

STRUCTURE: VT RTE 107 OVER WHITE RIVER	DRAWN: EEO	DATE: 10/24	
	CHKD: PCP	DATE: 10/24	
LOCATION: BETHEL, VT.	JOB NO.	DWG NO.	
PROJ NO. BRF 022-1(14)	498	27	
CUSTOMER: BECK & BELLUCCI		REV.	

EEO Thu, Nov 17, 2011 09:24:28 AM /users/jobs/2012/27 Rev0