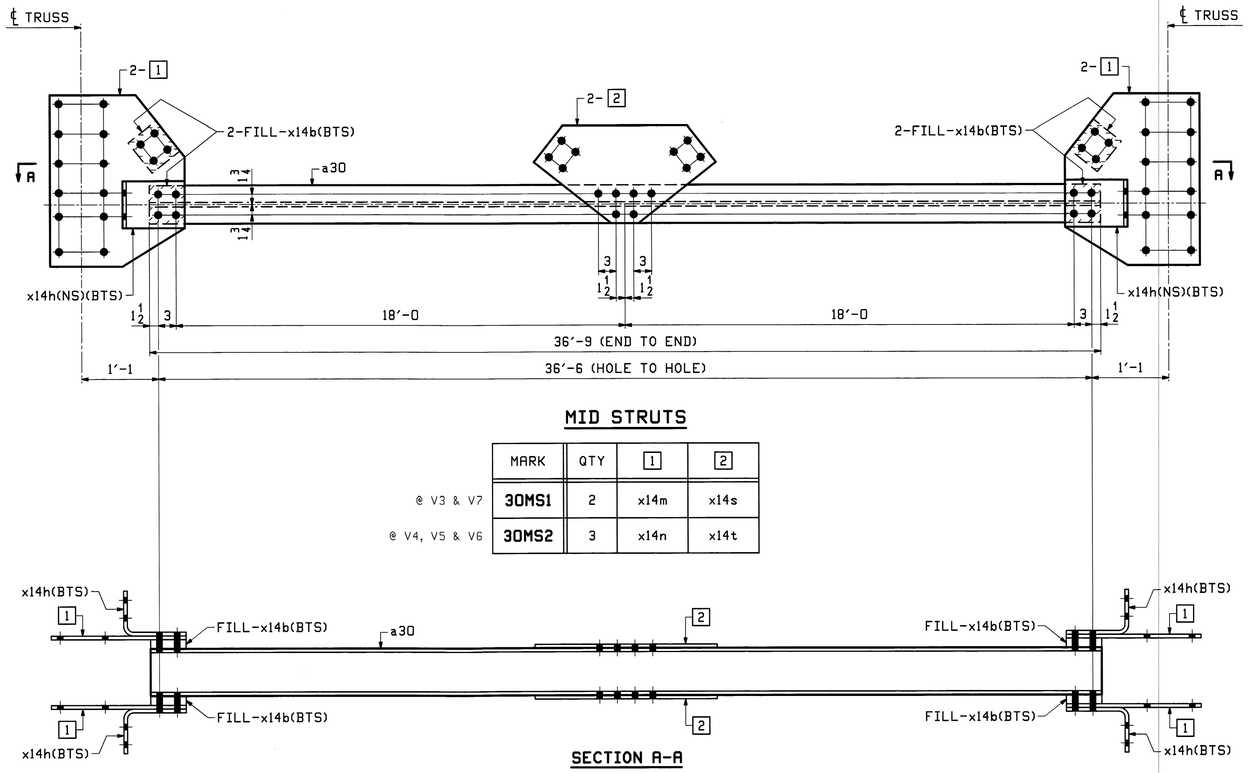

MID STRUTS

	MARK	QTY	1	2
@ V3 & V7	30MS1	2	x14m	x14s
@ V4, V5 & V6	30MS2	3	x14n	x14t

SECTION A-A

ABM INFO PAGE	ABM INFO LINE	SHIP MARK	QTY	MARK	MATERIAL	LENGTH FT	LENGTH INCHES	REMARKS	WT	PROCUREMENT NOTES
		30MS1	2		MID STRUT				1593	
7	Q		2	a30	W 8x24	36	9			
5	F		8	x14m	PL 1/2x22 13/16	2	3			
5	H		16	x14b	PL 1 9/16x6	0	6 1/2	FILL		
5	G		8	x14h	PL 1/2x8	1	5	BENT		
12	C		4	x14s	PL 1/2x18	2	4 3/4			
		30MS2	3		MID STRUT				1590	
7	Q		3	a30	W 8x24	36	9			
5	F		12	x14n	PL 1/2x22 13/16	2	3			
5	H		24	x14b	PL 1 9/16x6	0	6 1/2	FILL		
5	G		12	x14h	PL 1/2x8	1	5	BENT		
12	Q		6	x14t	PL 1/2x18	2	4	ALSO ORDERED ON 13/C		

JOB NO. 498 | DRAWING NO. 30 | REV.

Vermont Agency of Transportation

RECEIVED

CK'D BY M.C.L. OK'D BY S.S.S.

January 10 2012

RESUBMIT APPROVED ✓

BY J. LACROIX DATE 01-12-2012

NOTES:

1. FOR GENERAL NOTES SEE SHEET GN1.

REV.	DATE	REMARKS	DWN	CHK	APVL	SHOP
					JAN 9 2012	
0					NOV 18 2011	

MATERIAL:	SURFACE PREP. & PAINT:	HOLES:	SHOP BOLTS:
M270-50 (UN)	HOT-DIP GALV.	15/16ø (UN)	NONE

DESCRIPTION: MID SWAY FRAME STRUT 30MS1 & 30MS2

CASCO BAY STEEL STRUCTURES, INC.
1 WALLACE AVE. PHONE (207) 780-6722
SOUTH PORTLAND, ME 04106 FAX. (207) 780-6726
TENSOR 3073

STRUCTURE: VT RTE 107 OVER WHITE RIVER	DRAWN: EEO	DATE: 10/28
	CHKD: PCP	DATE: 10/28
LOCATION: BETHEL, VT.	JOB NO.	DWG NO.
PROJ NO. BRF 022-1(14)	498	30
CUSTOMER: BECK & BELLUCCI		REV. △

EEO Thu, Nov 17, 2011 09:30:49 AM /users/jobs/2073/30.1.dwg