ABM INFO		SHIP	BILL OF MATERIAL					JOB NO.	DRAWING NO.	REV.
								498	32	
PAGE	LINE	MARK	QTY	MARK	MATERIAL	LENGTH FT	LENGTH INCHES	REMARKS	WT	PROCUREMENT NOTES
7	X	32DG1	6		W 8x24	25	11		622	
		32DG2	6		SWAY DIAGONAL				354	
7	Y		6	a32	W 8x24	12	8			
12	T		12	x14y	PL $\frac{1}{2}$x7	2	1	ALSO ORDERED ON 13/F		
7	Z	32DG3	6		W 8x24	12	$2\frac{1}{2}$		293	

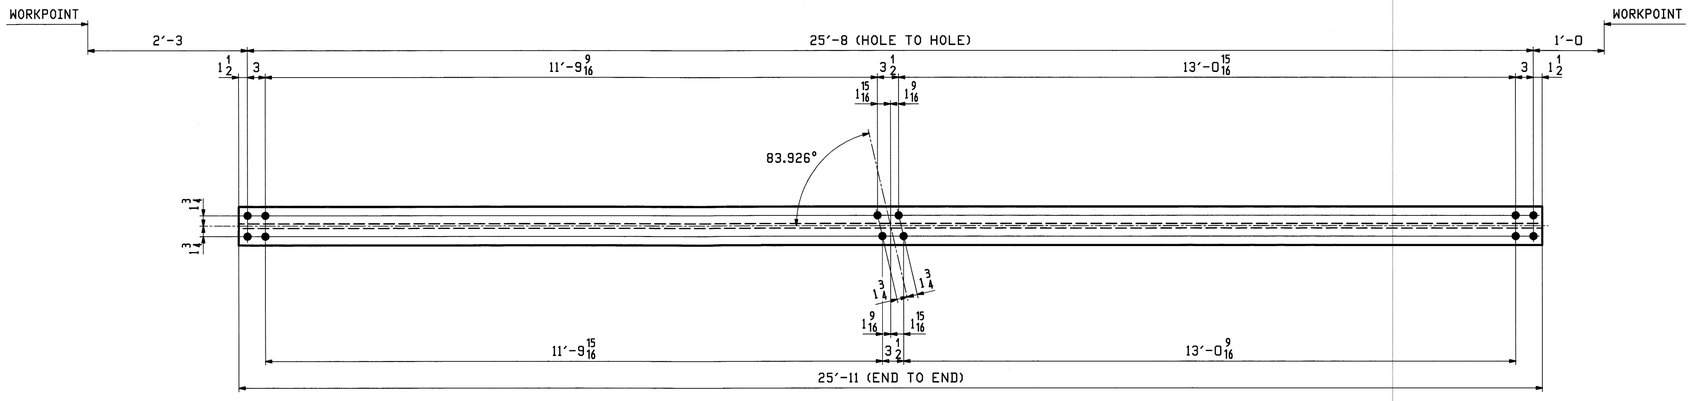

6 ~ SWAY FRAME DIAGONAL ~ 32DG1

(V4, V5 & V6)

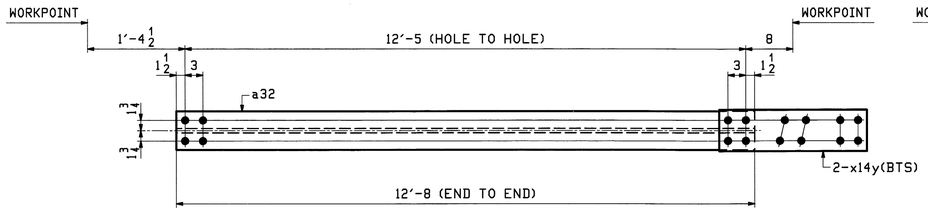

6 ~ SWAY FRAME DIAGONAL ~ 32DG2

(V4, V5 & V6)

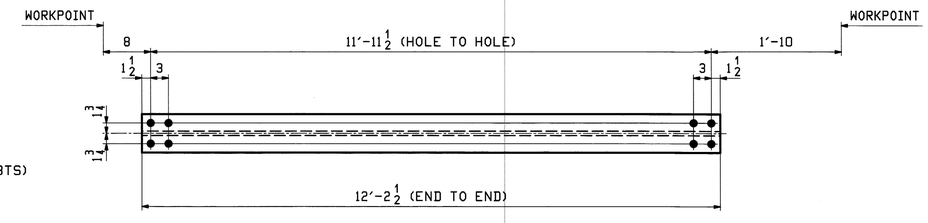

6 ~ SWAY FRAME DIAGONAL ~ 32DG3

(V4, V5 & V6)

NOTES:
1. FOR GENERAL NOTES SEE SHEET GN1.
2. HOLES IN BOTH FLANGES ARE ALIKE.

Vermont Agency of Transportation
RECEIVED
CK'D BY M.C.L. OK'D BY S.S.S.
January 10 2012
RESUBMIT APPROVED ✓
BY J. LACROIX DATE 01-12-2012

REV.	DATE	REMARKS	DWN	CHK	APVL	SHOP
					JAN 9 2012	
0					NOV 18 2011	

MATERIAL:	SURFACE PREP. & PAINT:	HOLES:	SHOP BOLTS:
M270-50 (UN)	HOT-DIP GALV.	$\frac{15}{16}\phi$ (UN)	NONE

DESCRIPTION: SWAY FRAME DIAGONALS

CASCO BAY STEEL STRUCTURES, INC.
1 WALLACE AVE. PHONE (207) 780-6722
SOUTH PORTLAND, ME 04106 FAX. (207) 780-6726
TENSOR 3073

STRUCTURE: VT RTE 107 OVER WHITE RIVER	DRAWN: EEO	DATE: 11/01
	CHKD: PCP	DATE: 11/11
LOCATION: BETHEL, VT.	JOB NO. 498	DWG NO. 32
PROJ NO. BRF 022-1(14)		
CUSTOMER: BECK & BELLUCCI		REV. △

EEO Thu, Nov 17, 2011 02:12:24 PM //users/jobs/2073/32 - Rev0