ABM INFO		SHIP	BILL OF MATERIAL					JOB NO.	DRAWING NO.		REV.
								498	34		
PAGE	LINE	MARK	QTY	MARK	MATERIAL	LENGTH FT	LENGTH INCHES	REMARKS	WT	PROCUREMENT NOTES	
		34LB1	2		TOP LATERAL BRACING				2540		
7	B		2	a34	W 14x53	44	0				
7	H		4	x6c	PL $\frac{1}{2}$x26$\frac{1}{4}$	2	4				
7	C	34LB2	4		W 14x53	21	4		1131		
		34LB3	2		TOP LATERAL BRACING				2480		
7	D		2	b34	W 14x53	42	10$\frac{3}{8}$				
7	H		4	x6d	PL $\frac{1}{2}$x26$\frac{1}{4}$	2	4				
7	E	34LB4	4		W 14x53	20	9$\frac{3}{16}$		1101		

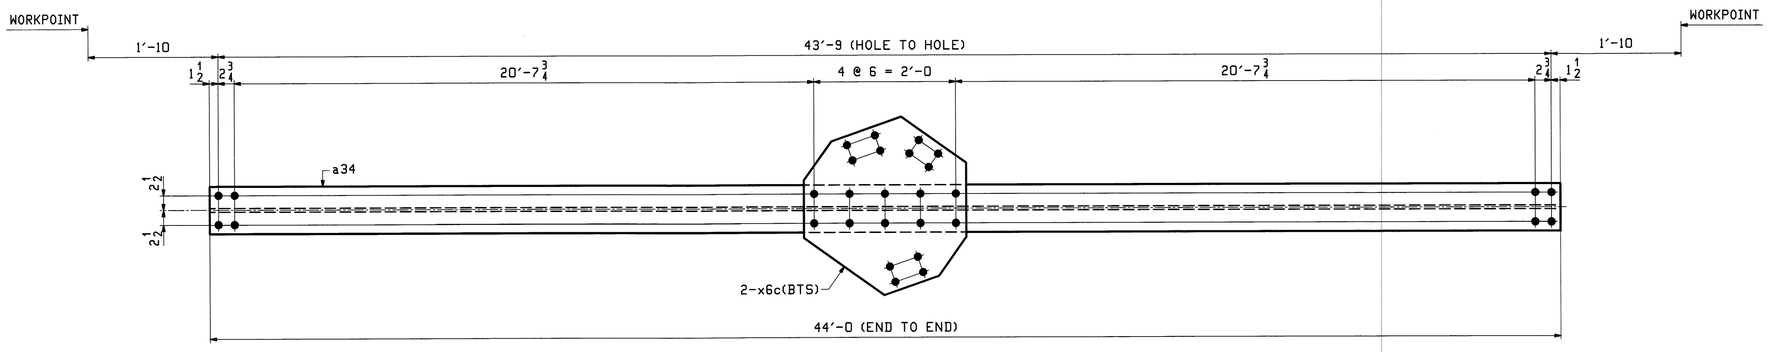

2 ~ TOP LATERAL BRACING ~ 34LB1

(U1 - U2 & U9 - U8)

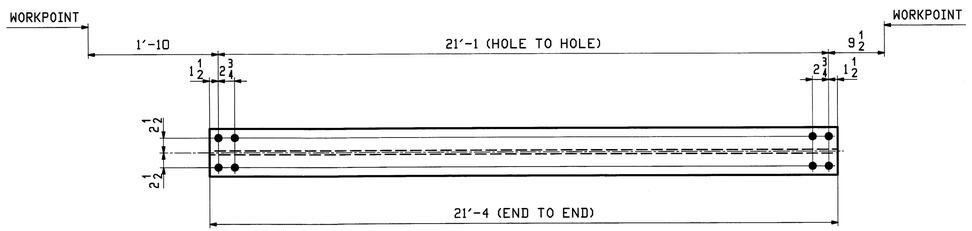

4 ~ TOP LATERAL BRACING ~ 34LB2

(U1 - U2 & U9 - U8)

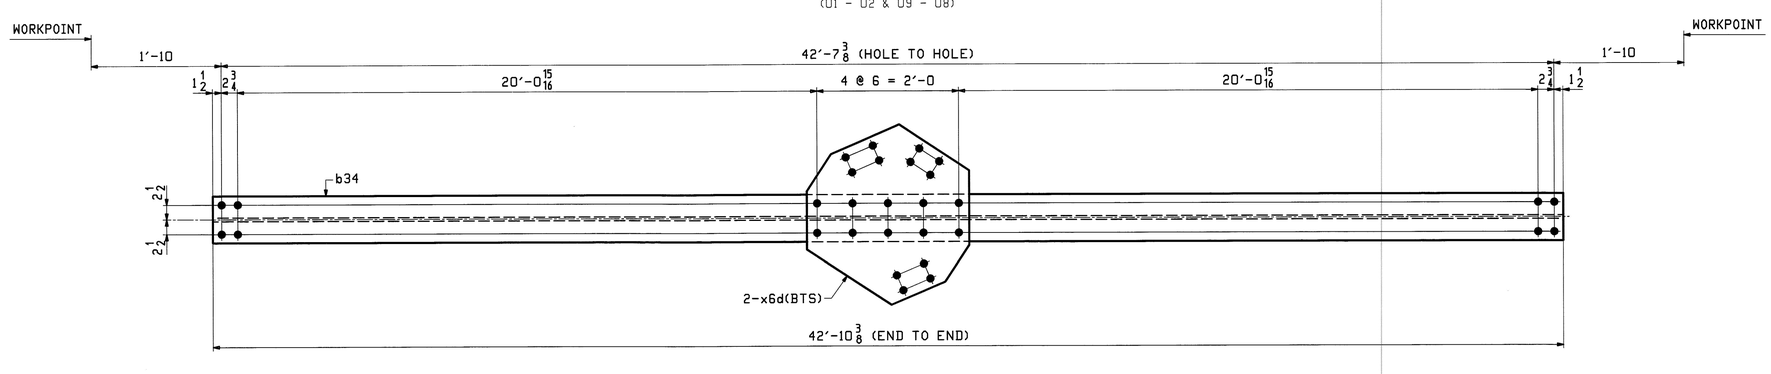

2 ~ TOP LATERAL BRACING ~ 34LB3

(U2 - U3 & U8 - U7)

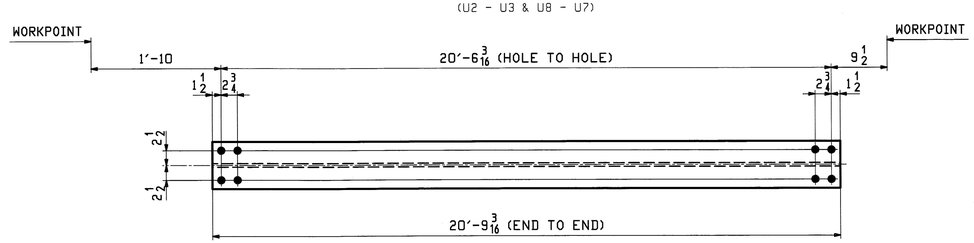

4 ~ TOP LATERAL BRACING ~ 34LB4

(U2 - U3 & U8 - U7)

NOTES:
1. FOR GENERAL NOTES SEE SHEET GN1.
2. HOLES IN BOTH FLANGES ARE ALIKE.

Vermont Agency of Transportation
RECEIVED
CK'D BY M.C.L. OK'D BY S.S.S.
January 10 2012
RESUBMIT APPROVED ✓
BY J. LACROIX DATE 01-12-2012

REV.	DATE	REMARKS	DWN	CHK	APVL	SHOP
					JAN 9 2012	
0					NOV 18 2011	

MATERIAL:	SURFACE PREP. & PAINT:	HOLES:	SHOP BOLTS:
M270-50 (UN)	HOT-DIP GALV.	$\frac{15}{16}$ø (UN)	NONE

DESCRIPTION: TOP LATERAL BRACING

CASCO BAY STEEL STRUCTURES, INC.
1 WALLACE AVE. PHONE (207) 780-6722
SOUTH PORTLAND, ME 04106 FAX. (207) 780-6726
TENSOR 3073

STRUCTURE: VT RTE 107 OVER WHITE RIVER	DRAWN: EEO	DATE: 11/01	
	CHK'D: PCP	DATE: 11/11	
LOCATION: BETHEL, VT.	JOB NO. 498	DWG NO. 34	
PROJ NO. BRF 022-1(14)			
CUSTOMER: BECK & BELLUCCI		REV. △	

RCP Wed, Nov 2, 2011 03:17:49 PM /users/jobs/3073-34 - Rev0