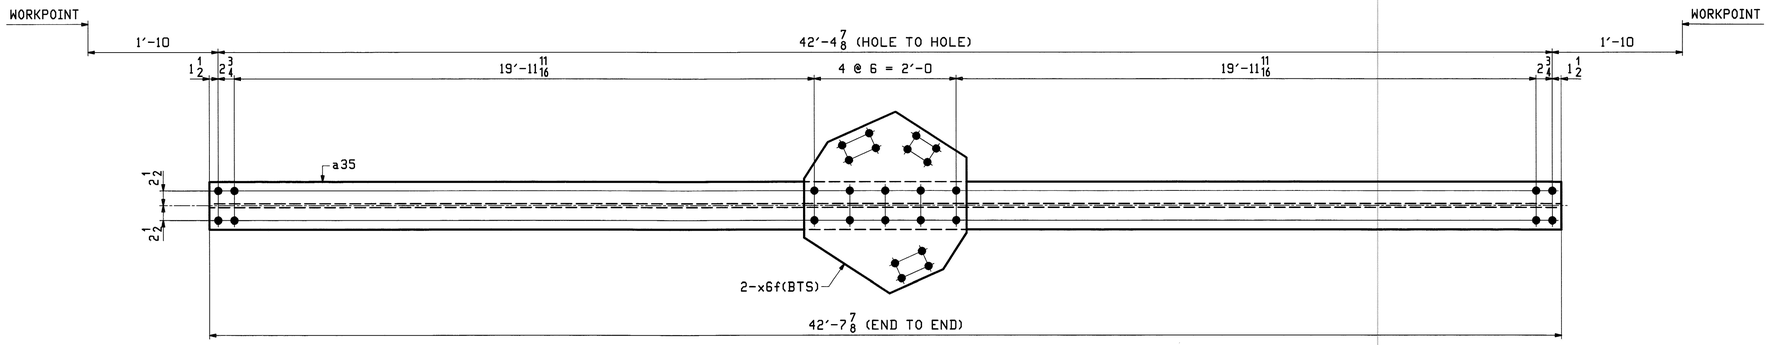

2 ~ TOP LATERAL BRACING ~ 35LB1

(U3 - U4 & U7 - U6)

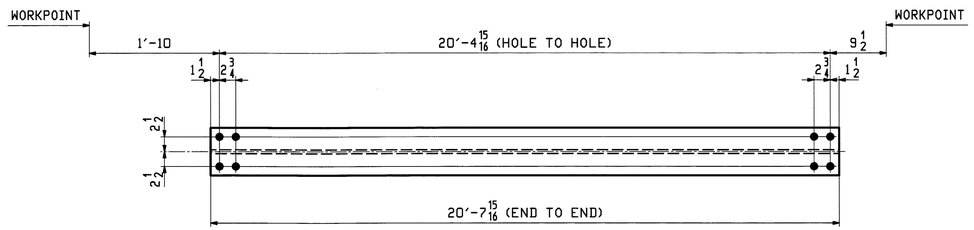

4 ~ TOP LATERAL BRACING ~ 35LB2

(U3 - U4 & U7 - U6)

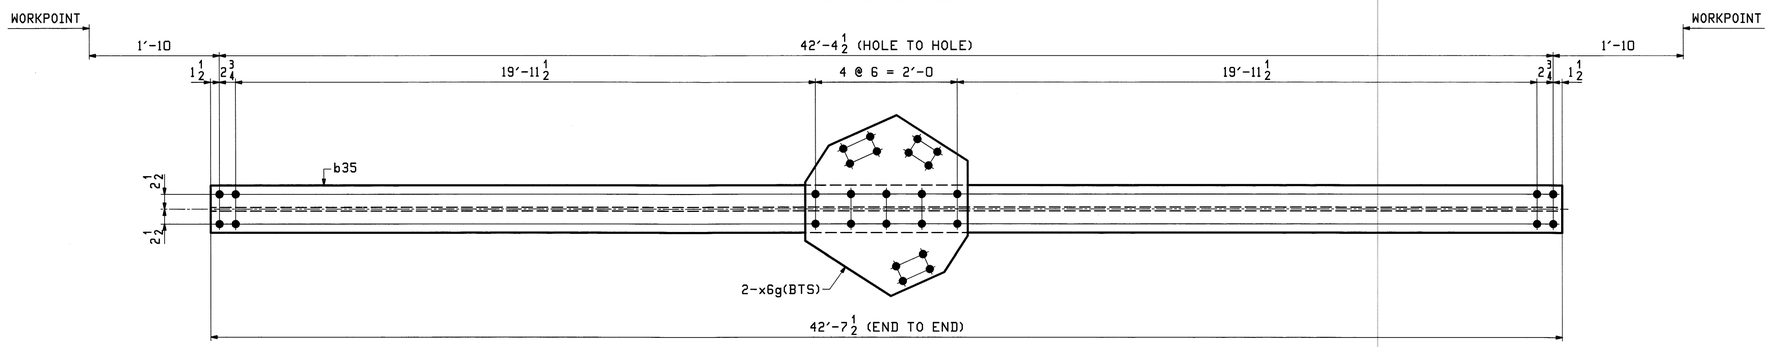

2 ~ TOP LATERAL BRACING ~ 35LB3

(U4 - U5 & U6 - U5)

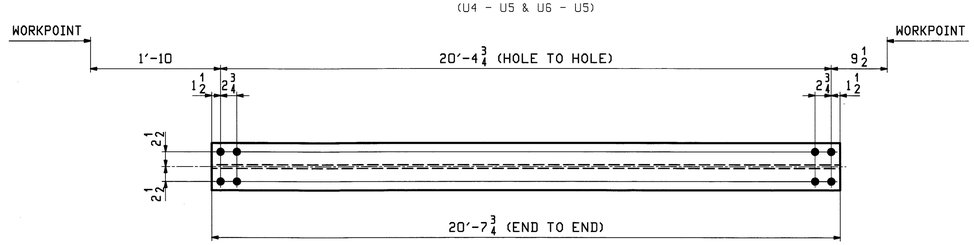

4 ~ TOP LATERAL BRACING ~ 35LB4

(U4 - U5 & U6 - U5)

RBM INFO		SHIP	BILL OF MATERIAL					JOB NO. 498	DRAWING NO. 35	REV.
PAGE	LINE	MARK	QTY	MARK	MATERIAL	LENGTH FT	LENGTH INCHES	REMARKS	WT	PROCUREMENT NOTES
		35LB1	2		TOP LATERAL BRACING				2469	
7	F		2	a35	W 14x53	42	7 7/8			
7	H		4	x6f	PL 1/2x26 1/4	2	4			
7	G	35LB2	4		W 14x53	20	7 15/16		1095	
		35LB3	2		TOP LATERAL BRACING				2468	
7	F		2	b35	W 14x53	42	7 1/2			
7	H		4	x6g	PL 1/2x26 1/4	2	4			
7	G	35LB4	4		W 14x53	20	7 3/4		1094	

NOTES:
1. FOR GENERAL NOTES SEE SHEET GN1.
2. HOLES IN BOTH FLANGES ARE ALIKE.

Vermont Agency of Transportation
RECEIVED
CK'D BY M.C.L. OK'D BY S.S.S.
January 10 2012
RESUBMIT APPROVED ✓
BY J. LACROIX DATE 01-12-2012

REV.	DATE	REMARKS	DWN	CHK	APVL	SHOP
0					JAN 9 2012 / NOV 18 2011	

MATERIAL:	SURFACE PREP. & PAINT:	HOLES:	SHOP BOLTS:
M270-50 (UN)	HOT-DIP GALV.	15/16ø (UN)	NONE

DESCRIPTION: TOP LATERAL BRACING

CASCO BAY STEEL STRUCTURES, INC.
1 WALLACE AVE. PHONE (207) 780-6722
SOUTH PORTLAND, ME 04106 FAX. (207) 780-6726
TENSOR 3073

STRUCTURE: VT RTE 107 OVER WHITE RIVER		DRAWN: EEO	DATE: 11/01
		CHKD: PCP	DATE: 11/11
LOCATION:	BETHEL, VT.	JOB NO.	DWG NO.
PROJ NO.	BRF 022-1(14)	498	35
CUSTOMER:	BECK & BELLUCCI		REV. △

PCP Wed, Nov 2, 2011 03:18:05 PM /users/jim/2072/35, Rev0