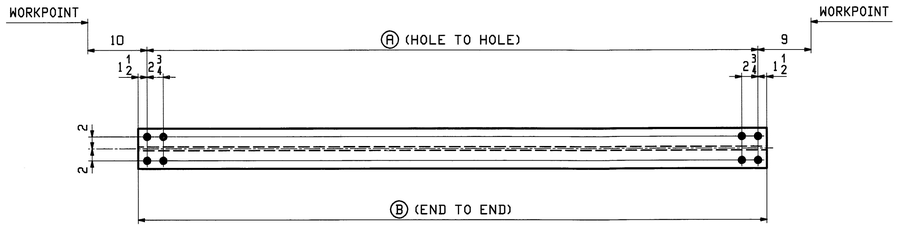


## TOP CENTER STRUTS

| | MARK | QTY | Ⓐ | Ⓑ |
|---|---|---|---|---|
| U2 & U8 | **36CS1** | 2 | 12′-1 11/16 | 12′-4 11/16 |
| U3 & U7 | **36CS2** | 2 | 11′-1 5/8 | 11′-4 5/8 |
| U4 & U6 | **36CS3** | 2 | 10′-11 5/16 | 11′-2 5/16 |
| U5 | **36CS4** | 2 | 10′-11 | 11′-2 |

| ABM INFO | | SHIP | BILL OF MATERIAL | | | | | JOB NO. | DRAWING NO. | REV. |
|---|---|---|---|---|---|---|---|---|---|---|
| | | | | | | | | 498 | 36 | |
| PAGE | LINE | MARK | QTY | MARK | MATERIAL | LENGTH FT | LENGTH INCHES | REMARKS | WT | PROCUREMENT NOTES |
| 7 | L | 36CS1 | 2 | | W 14x30 | 12 | 4 11/16 | | 372 | |
| 7 | M | 36CS2 | 2 | | W 14x30 | 11 | 4 5/8 | | 342 | |
| 7 | M | 36CS3 | 2 | | W 14x30 | 11 | 2 5/16 | | 336 | |
| 7 | M | 36CS4 | 2 | | W 14x30 | 11 | 2 | | 335 | |

NOTES:
1. FOR GENERAL NOTES SEE SHEET GN1.
2. HOLES IN BOTH FLANGES ARE ALIKE.

Vermont Agency of Transportation
**RECEIVED**
CK'D BY M.C.L. OK'D BY S.S.S.
January 10 2012
RESUBMIT ____ APPROVED ✓
BY J. LACROIX DATE 01-12-2012

| REV. | DATE | REMARKS | DWN | CHK | APVL | SHOP |
|---|---|---|---|---|---|---|
| | | | | | JAN 9 2012 | |
| 0 | | | | | NOV 18 2011 | |

| MATERIAL: | SURFACE PREP. & PAINT: | HOLES: | SHOP BOLTS: |
|---|---|---|---|
| M270-50 (UN) | HOT-DIP GALV. | 15/16 Ø (UN) | NONE |

DESCRIPTION: TOP CENTER STRUTS

CASCO BAY STEEL STRUCTURES, INC.
1 WALLACE AVE. PHONE (207) 780-6722
SOUTH PORTLAND, ME 04106 FAX. (207) 780-6726
TENSOR 3073

| STRUCTURE: VT RTE 107 OVER WHITE RIVER | DRAWN: EEO | DATE: 11/02 |
|---|---|---|
| | CHKD: PCP | DATE: 11/11 |
| LOCATION: BETHEL, VT. | JOB NO. | DWG NO. |
| PROJ NO. BRF 022-1(14) | 498 | 36 |
| CUSTOMER: BECK & BELLUCCI | | REV. △ |

PCP Wed, Nov 2, 2011 09:03:31 PM c:\users\john\2073\36_Rev0