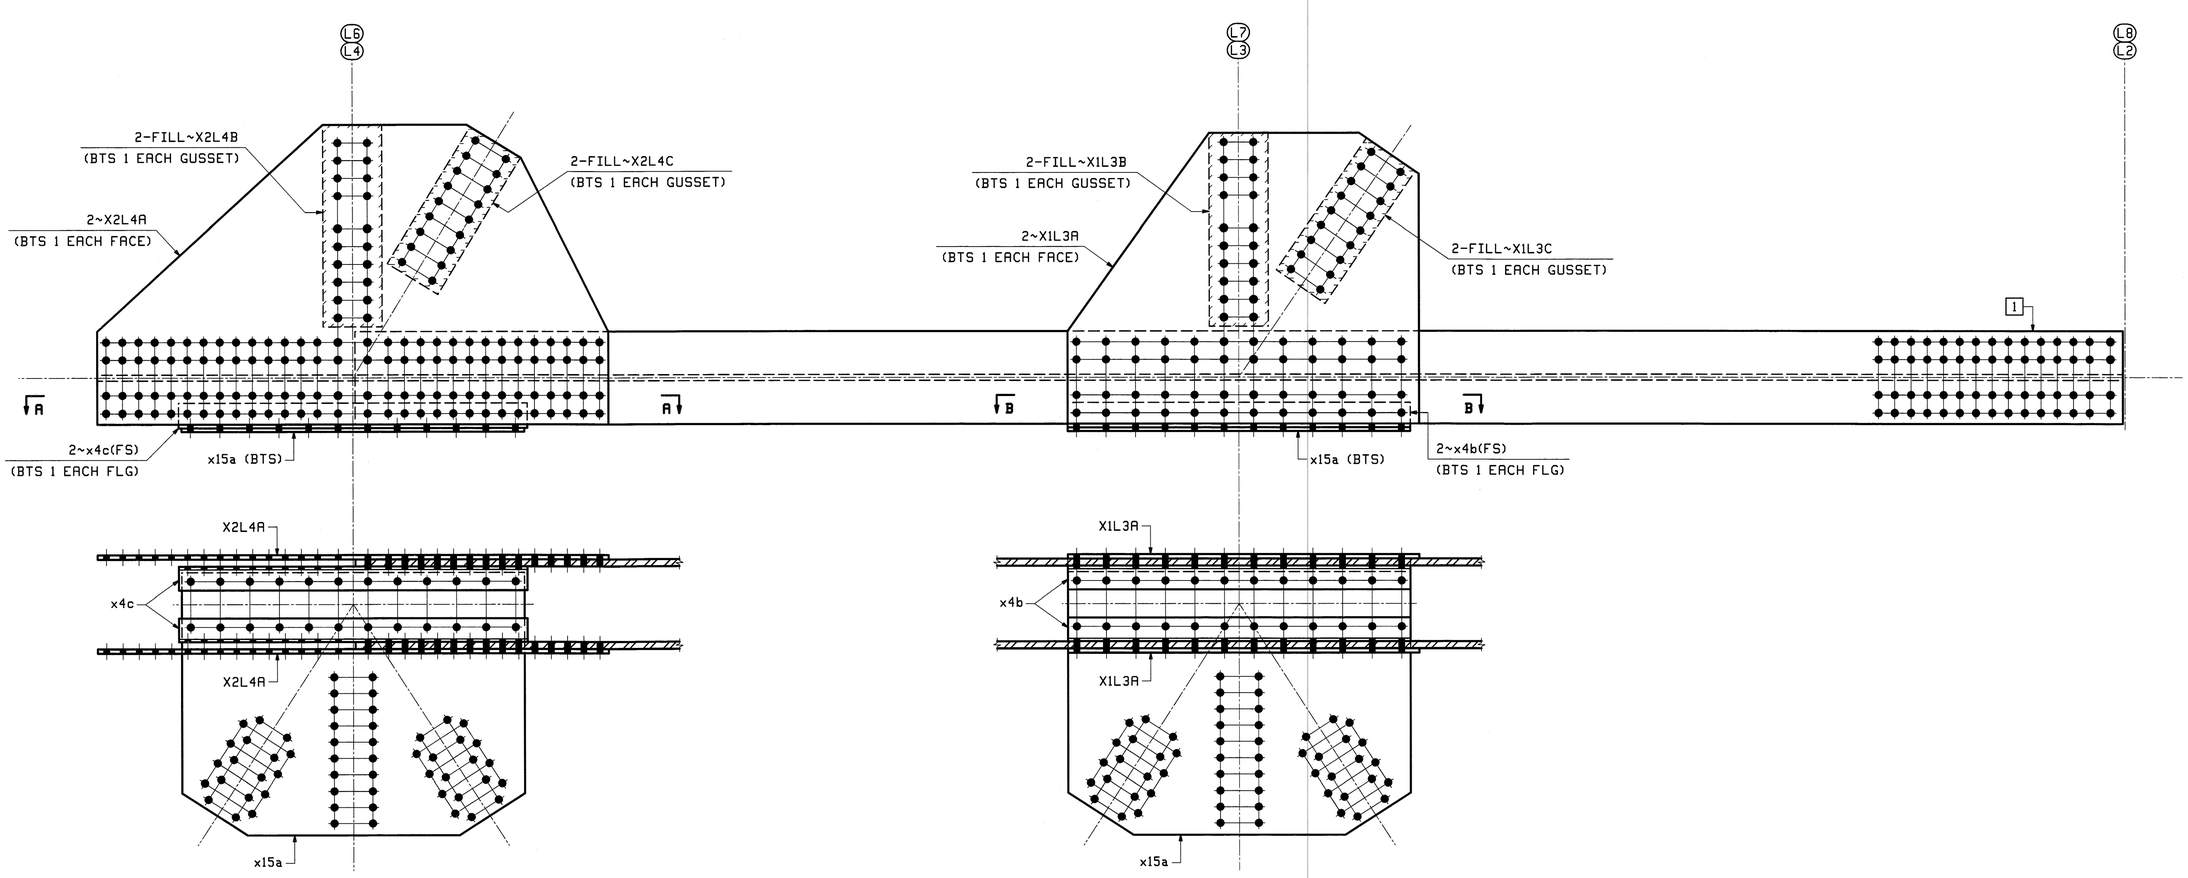

SECTION A-A

SECTION B-B

SHIPPING ASSEMBLY ~ MARK

(BOTTOM CHORDS)

	MARK	QTY	1
(L6 - L8 WEST TRUSS, LOOKING WEST)	40L6L8W	ONE	11BC4W
(L4 - L2 EAST TRUSS, LOOKING EAST)	40L4L2E	ONE	11BC2E

BILL OF MATERIAL — JOB NO. 498 — DRAWING NO. 40 — REV.

ABM INFO PAGE	ABM INFO LINE	SHIP MARK	QTY	MARK	MATERIAL	LENGTH FT	LENGTH INCHES	REMARKS	WT	PROCUREMENT NOTES
		40L6L8W	1		BTM CHORD SHIPPING ASS'Y				12587	
			1	11BC4W	BOTTOM CHORD					
1	P		2	X1L3A	PL $\frac{3}{4}$x49	4	$11\frac{1}{2}$	M270-50F2 (FCM)		
3	K		2	X1L3B	PL $\frac{9}{16}$x10	2	$8\frac{9}{16}$	FILL M270-50		
3	P		2	X1L3C	PL $\frac{9}{16}$x10	2	3	FILL M270-50		
1	Q		2	X2L4A	PL $\frac{3}{4}$x50$\frac{1}{2}$	7	$2\frac{1}{2}$	M270-50F2 (FCM)		
3	L		2	X2L4B	PL $\frac{9}{16}$x10	2	$10\frac{1}{16}$	FILL M270-50		
3	P		2	X2L4C	PL $\frac{9}{16}$x10	2	3	FILL M270-50		
3	C		2	x4b	L 4x4x$\frac{1}{2}$	4	10	M270-36		
3	C		2	x4c	L 4x4x$\frac{1}{2}$	4	11	M270-36		
2	K		2	x15a	PL $\frac{5}{8}$x44$\frac{5}{16}$	4	10	M270-50		

BILL OF MATERIAL — JOB NO. 498 — DRAWING NO. 40 — REV.

ABM INFO PAGE	ABM INFO LINE	SHIP MARK	QTY	MARK	MATERIAL	LENGTH FT	LENGTH INCHES	REMARKS	WT	PROCUREMENT NOTES
		40L4L2E	1		BTM CHORD SHIPPING ASS'Y				12587	
			1	11BC2E	BOTTOM CHORD					
1	P		2	X1L3A	PL $\frac{3}{4}$x49	4	$11\frac{1}{2}$	M270-50F2 (FCM)		
3	K		2	X1L3B	PL $\frac{9}{16}$x10	2	$8\frac{9}{16}$	FILL M270-50		
3	P		2	X1L3C	PL $\frac{9}{16}$x10	2	3	FILL M270-50		
1	Q		2	X2L4A	PL $\frac{3}{4}$x50$\frac{1}{2}$	7	$2\frac{1}{2}$	M270-50F2 (FCM)		
3	L		2	X2L4B	PL $\frac{9}{16}$x10	2	$10\frac{1}{16}$	FILL M270-50		
3	P		2	X2L4C	PL $\frac{9}{16}$x10	2	3	FILL M270-50		
3	C		2	x4b	L 4x4x$\frac{1}{2}$	4	10	M270-36		
3	C		2	x4c	L 4x4x$\frac{1}{2}$	4	11	M270-36		
3	K		2	x15a	PL $\frac{5}{8}$x44$\frac{5}{16}$	4	10	M270-50		

Vermont Agency of Transportation
RECEIVED
CK'D BY M.C.L. OK'D BY S.S.S.
January 10 2012
RESUBMIT APPROVED ✓
BY J. LACROIX DATE 01-12-2012

REV.	DATE	REMARKS	DWN	CHK	APVL	SHOP
					JAN 9 2012	
0					NOV 30 2011	

MATERIAL: M270-50 (UN) | SURFACE PREP. & PAINT: HOT-DIP GALV. | HOLES: $\frac{15}{16}$Ø (UN) | SHOP BOLTS: NONE

DESCRIPTION: SHIPPING ASSEMBLY (L6-L8 WEST & L4-L2 EAST)

CASCO BAY STEEL STRUCTURES, INC.
1 WALLACE AVE. PHONE (207) 780-6722
SOUTH PORTLAND, ME 04106 FAX. (207) 780-6726
TENSOR 3073

STRUCTURE: VT RTE 107 OVER WHITE RIVER

DRAWN: EEO	DATE: 11/21	
CHKD: PCP	DATE: 11/23	
LOCATION: BETHEL, VT.	JOB NO. 498	DWG NO. 40
PROJ NO. BRF 022-1(14)		REV. △
CUSTOMER: BECK & BELLUCCI		

EEO Tue, Nov 29, 2011 03:38:05 PM /users/jobs/3073/40 - Rev.0