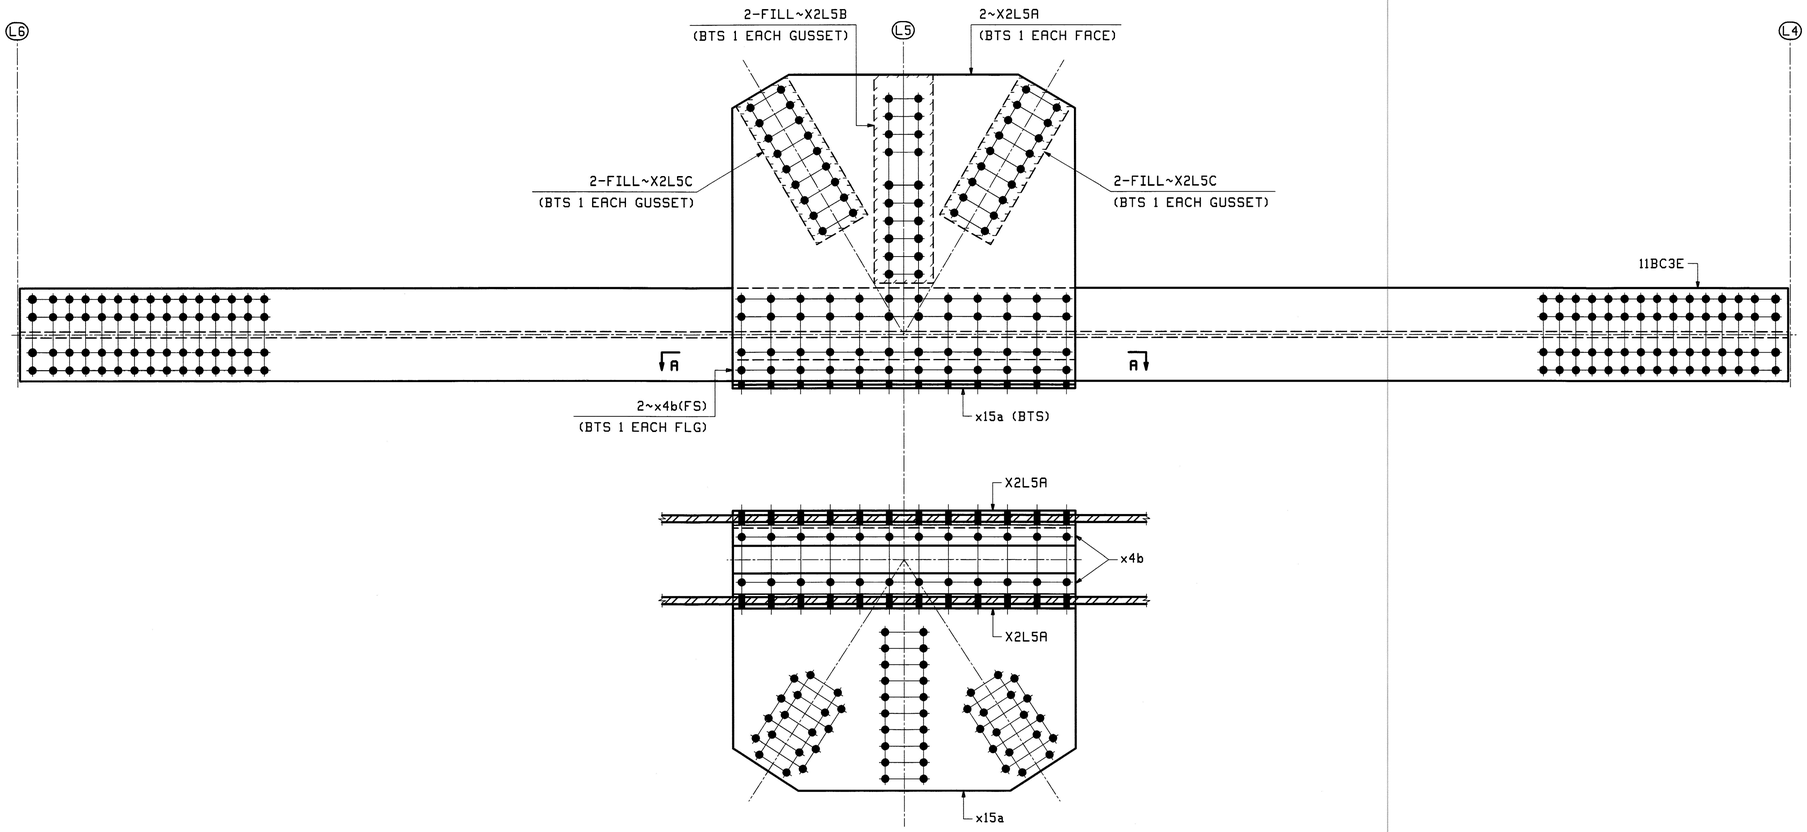

SECTION A-A

ONE ~ SHIPPING ASSEMBLY ~ 42L6L4E

(BOTTOM CHORD) (L6 - L4 EAST TRUSS, LOOKING EAST)

ABM INFO		SHIP	BILL OF MATERIAL					JOB NO.	DRAWING NO.	REV.
								498	42	
PAGE	LINE	MARK	QTY	MARK	MATERIAL	LENGTH FT	LENGTH INCHES	REMARKS	WT	PROCUREMENT NOTES
		42L6L4E	1		BTM CHORD SHIPPING ASSY				100726	
			1	11BC3E	BOTTOM CHORD					
1	R		2	X2L5A	PL $\frac{3}{4}$x51 $\frac{1}{2}$	4	10	M270-50F2 (FCM)		
3	L		2	X2L5B	PL $\frac{9}{16}$x10	2	11 $\frac{1}{16}$	FILL M270-50		
3	P		4	X2L5C	PL $\frac{9}{16}$x10	2	3	FILL M270-50		
3	C		2	x4b	L 4x4x $\frac{1}{2}$	4	10	M270-36		
2	K		1	x15a	PL $\frac{5}{8}$x44 $\frac{5}{16}$	4	10	M270-50		

Vermont Agency of Transportation
RECEIVED
CK'D BY M.C.L. OK'D BY S.S.S.
January 10 2012
RESUBMIT APPROVED ✓
BY J. LACROIX DATE 01-12-2012

REV.	DATE	REMARKS	DWN	CHK	APVL	SHOP
					JAN 9 2012	
0					NOV 30 2011	

MATERIAL:	SURFACE PREP. & PAINT:	HOLES:	SHOP BOLTS:
M270-50 (UN)	HOT-DIP GALV.	$\frac{15}{16}$Ø (UN)	NONE

DESCRIPTION: SHIPPING ASSEMBLY (L6-L4 EAST)

CASCO BAY STEEL STRUCTURES, INC.
1 WALLACE AVE. PHONE (207) 780-6722
SOUTH PORTLAND, ME 04106 FAX. (207) 780-6726
TENSOR 3073

STRUCTURE: VT RTE 107 OVER WHITE RIVER	DRAWN: EEO	DATE: 11/21
	CHKD: PCP	DATE: 11/23
LOCATION: BETHEL, VT.	JOB NO.	DWG NO.
PROJ NO. BRF 022-1(14)	498	42
CUSTOMER: BECK & BELLUCCI		REV. △

EEO Tue, Nov 29, 2011 03:43:06 PM /users/jobs/3073/42 | Rev0