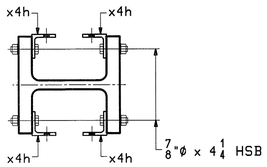

SECTION-X

SHOP NOTE:
INSTALL BOLT HEADS AS SHOWN.

ABM INFO PAGE	ABM INFO LINE	SHIP MARK	QTY	MARK	MATERIAL	LENGTH FT	LENGTH INCHES	REMARKS	WT	PROCUREMENT NOTES
		43U1L0E	1		END POST SHIPPING		ASS'Y		1356D	
			1	12EP1E	END POST					
8	H		1	X2U1A	PL 3/4x51 5/8	8	1 3/4	M270-HPS70W		
8	H		1	X2U1B	PL 3/4x51 5/8	8	1 3/4	M270-HPS70W		
9	E		2	X2U1C	PL 1 5/8x10	2	0	FILL		
9	D		2	X2U1D	PL 1 5/8x10	2	3	FILL		
9	G		2	X2U1F	PL 13/16x15 3/4	4	4 1/2	FILL		
9	H		1	x4f	L 4x4x1/2	1	2	M270-36		
9	H		1	x4g	L 4x4x1/2	1	5	M270-36		
8	W		4	x4h	L 4x4x1/2	1	4 1/2	M270-36		
9	J		2	x4s	L 3x3x3/8	2	0	M270-36		
21	E		10		7/8 Ø HSB	0	2 3/4	MECH. GALV. A325-1		
21	L		20		7/8 Ø HSB	0	4 1/4	MECH. GALV. A325-1		
21	X		30		7/8 Ø HSW			MECH. GALV. F436		
21	Y		30		LOAD IND. WASH FOR 7/8 Ø HSB			MECH. GALV. F436		

JOB NO. 498 — DRAWING NO. 43 — REV.

ABM INFO PAGE	ABM INFO LINE	SHIP MARK	QTY	MARK	MATERIAL	LENGTH FT	LENGTH INCHES	REMARKS	WT	PROCUREMENT NOTES
		43L0U1W	1		END POST SHIPPING		ASS'Y		1356D	
			1	12EP1W	END POST					
8	H		1	X2U1A	PL 3/4x51 5/8	8	1 3/4	M270-HPS70W		
8	H		1	X2U1B	PL 3/4x51 5/8	8	1 3/4	M270-HPS70W		
9	E		2	X2U1C	PL 1 5/8x10	2	0	FILL		
9	D		2	X2U1D	PL 1 5/8x10	2	3	FILL		
9	G		2	X2U1F	PL 13/16x15 3/4	4	4 1/2	FILL		
9	H		1	x4f	L 4x4x1/2	1	2	M270-36		
9	H		1	x4g	L 4x4x1/2	1	5	M270-36		
8	W		4	x4h	L 4x4x1/2	1	4 1/2	M270-36		
9	J		2	x4s	L 3x3x3/8	2	0	M270-36		
21	E		10		7/8 Ø HSB	0	2 3/4	MECH. GALV. A325-1		
21	L		20		7/8 Ø HSB	0	4 1/4	MECH. GALV. A325-1		
21	X		30		7/8 Ø HSW			MECH. GALV. F436		
21	Y		30		LOAD IND. WASH FOR 7/8 Ø HSB			MECH. GALV. F436		

JOB NO. 498 — DRAWING NO. 43 — REV.

ABM INFO PAGE	ABM INFO LINE	SHIP MARK	QTY	MARK	MATERIAL	LENGTH FT	LENGTH INCHES	REMARKS	WT	PROCUREMENT NOTES
		43L10U9E	1		END POST SHIPPING		ASS'Y		1356D	
			1	12EP10E	END POST					
8	H		1	X2U1A	PL 3/4x51 5/8	8	1 3/4	M270-HPS70W		
8	H		1	X2U1B	PL 3/4x51 5/8	8	1 3/4	M270-HPS70W		
9	E		2	X2U1C	PL 1 5/8x10	2	0	FILL		
9	D		2	X2U1D	PL 1 5/8x10	2	3	FILL		
9	G		2	X2U1F	PL 13/16x15 3/4	4	4 1/2	FILL		
9	H		1	x4f	L 4x4x1/2	1	2	M270-36		
9	H		1	x4g	L 4x4x1/2	1	5	M270-36		
8	W		4	x4h	L 4x4x1/2	1	4 1/2	M270-36		
9	J		2	x4s	L 3x3x3/8	2	0	M270-36		
21	E		10		7/8 Ø HSB	0	2 3/4	MECH. GALV. A325-1		
21	L		20		7/8 Ø HSB	0	4 1/4	MECH. GALV. A325-1		
21	X		30		7/8 Ø HSW			MECH. GALV. F436		
21	Y		30		LOAD IND. WASH FOR 7/8 Ø HSB			MECH. GALV. F436		

JOB NO. 498 — DRAWING NO. 43 — REV.

ABM INFO PAGE	ABM INFO LINE	SHIP MARK	QTY	MARK	MATERIAL	LENGTH FT	LENGTH INCHES	REMARKS	WT	PROCUREMENT NOTES
		43U9L10W	1		END POST SHIPPING		ASS'Y		1356D	
			1	12EP10W	END POST					
8	H		1	X2U1A	PL 3/4x51 5/8	8	1 3/4	M270-HPS70W		
8	H		1	X2U1B	PL 3/4x51 5/8	8	1 3/4	M270-HPS70W		
9	E		2	X2U1C	PL 1 5/8x10	2	0	FILL		
9	D		2	X2U1D	PL 1 5/8x10	2	3	FILL		
9	G		2	X2U1F	PL 13/16x15 3/4	4	4 1/2	FILL		
9	H		1	x4f	L 4x4x1/2	1	2	M270-36		
9	H		1	x4g	L 4x4x1/2	1	5	M270-36		
8	W		4	x4h	L 4x4x1/2	1	4 1/2	M270-36		
9	J		2	x4s	L 3x3x3/8	2	0	M270-36		
21	E		10		7/8 Ø HSB	0	2 3/4	MECH. GALV. A325-1		
21	L		20		7/8 Ø HSB	0	4 1/4	MECH. GALV. A325-1		
21	X		30		7/8 Ø HSW			MECH. GALV. F436		
21	Y		30		LOAD IND. WASH FOR 7/8 Ø HSB			MECH. GALV. F436		

JOB NO. 498 — DRAWING NO. 43 — REV.

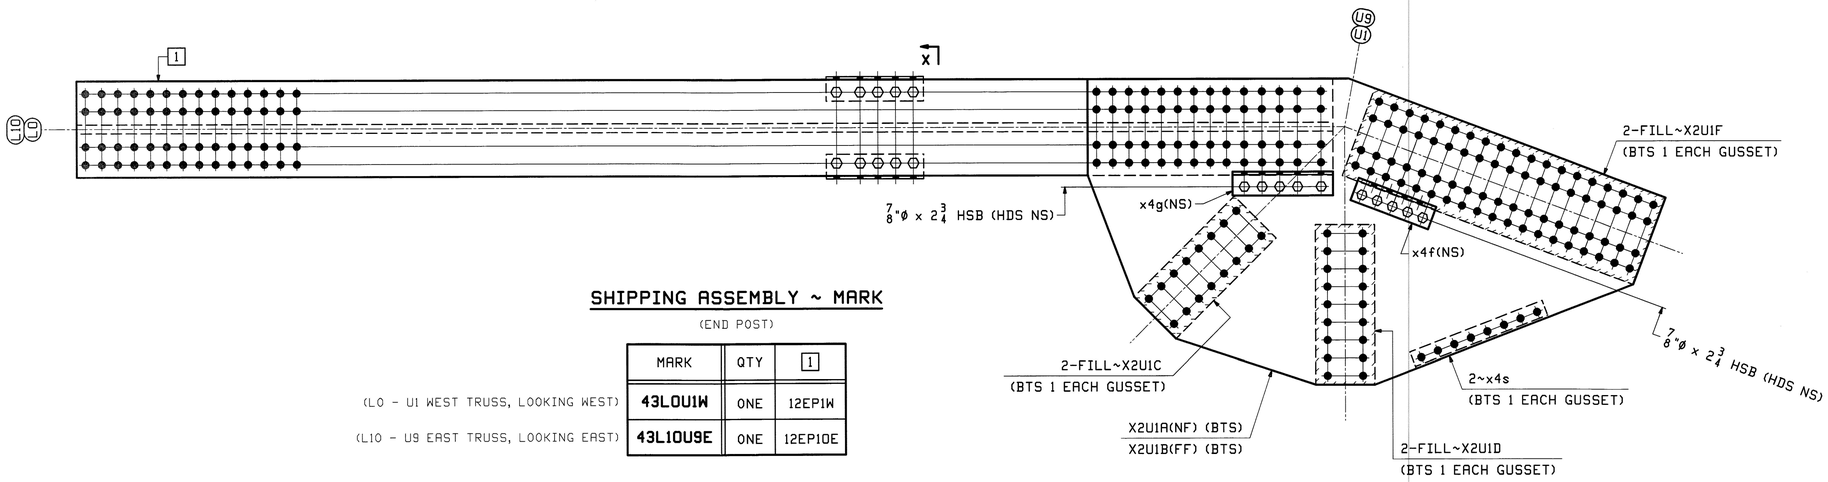

SHIPPING ASSEMBLY ~ MARK

(END POST)

	MARK	QTY	1
(L0 - U1 WEST TRUSS, LOOKING WEST)	43L0U1W	ONE	12EP1W
(L10 - U9 EAST TRUSS, LOOKING EAST)	43L10U9E	ONE	12EP10E

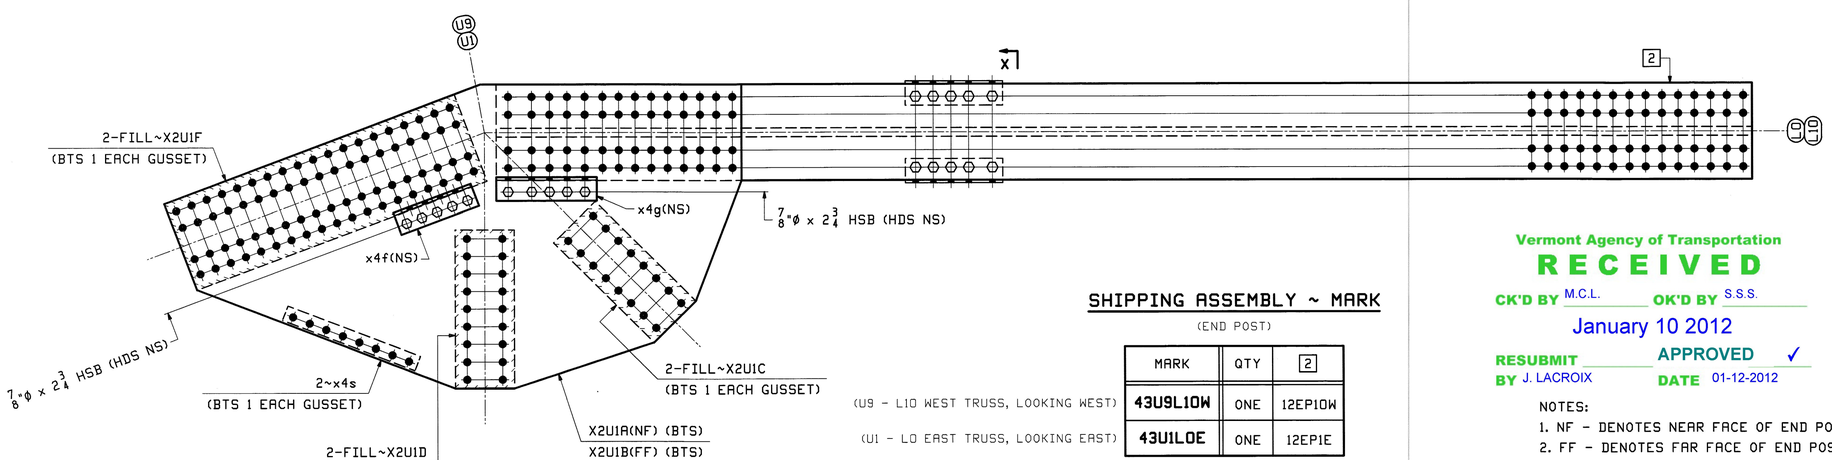

SHIPPING ASSEMBLY ~ MARK

(END POST)

	MARK	QTY	2
(U9 - L10 WEST TRUSS, LOOKING WEST)	43U9L10W	ONE	12EP10W
(U1 - L0 EAST TRUSS, LOOKING EAST)	43U1L0E	ONE	12EP1E

Vermont Agency of Transportation
RECEIVED
CK'D BY M.C.L. OK'D BY S.S.S.
January 10 2012
RESUBMIT APPROVED ✓
BY J. LACROIX DATE 01-12-2012

NOTES:
1. NF - DENOTES NEAR FACE OF END POST.
2. FF - DENOTES FAR FACE OF END POST.
3. NS - DENOTES NEAR SIDE.
4. FS - DENOTES FAR SIDE.

REV.	DATE	REMARKS	DWN	CHK	APVL	SHOP
					JAN 9 2012	
0					NOV 30 2011	

MATERIAL:	SURFACE PREP. & PAINT:	HOLES:	SHOP BOLTS:
M270-50 (UN)	HOT-DIP GALV.	15/16Ø (UN)	7/8Ø (UN)

DESCRIPTION: SHIPPING ASSEMBLY (L0-U1, L10-U9, U9-L10 & U1-L0)

CASCO BAY STEEL STRUCTURES, INC.
1 WALLACE AVE. PHONE (207) 780-6722
SOUTH PORTLAND, ME 04106 FAX. (207) 780-6726
TENSOR 3073

STRUCTURE: VT RTE 107 OVER WHITE RIVER	DRAWN: EEO	DATE: 11/21	
	CHKD: PCP	DATE: 11/28	
LOCATION: BETHEL, VT.	JOB NO.	DWG NO.	
PROJ NO. BRF 022-1(14)	498	43	
CUSTOMER: BECK & BELLUCCI		REV. △	

EEO Tue, Nov 29, 2011 04:56:53 PM /users/jake/3073/43 Rev0