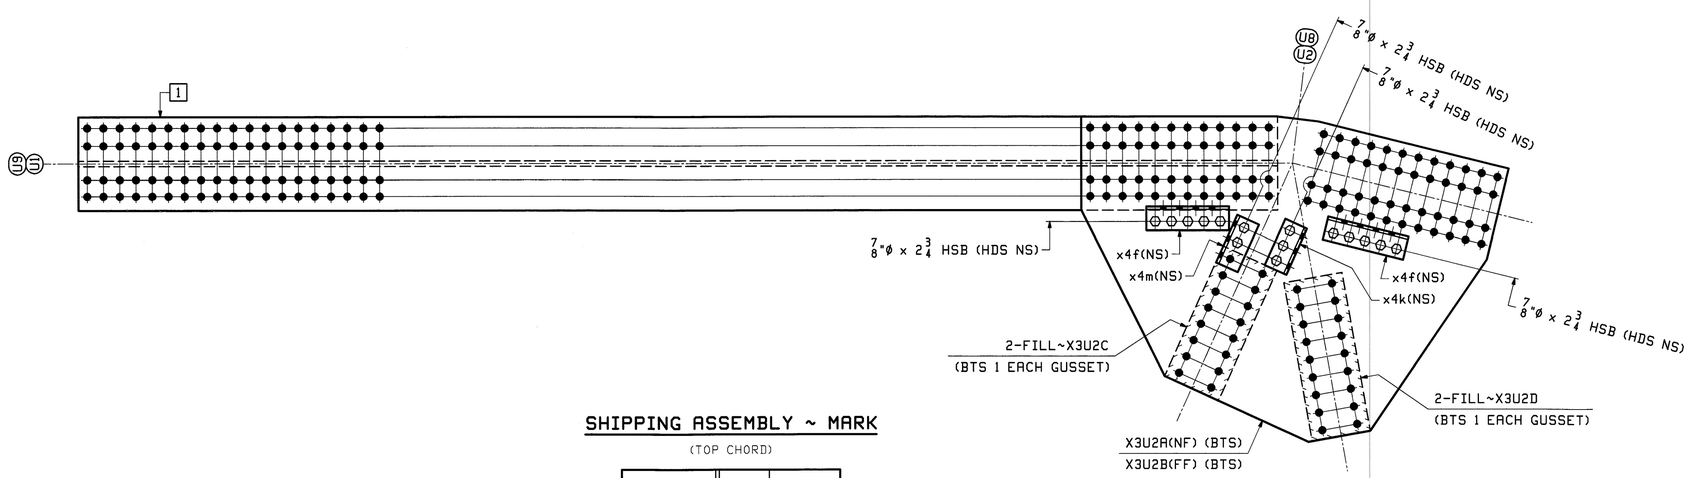

SHIPPING ASSEMBLY ~ MARK

(TOP CHORD)

	MARK	QTY	1
(U1 - U2 WEST TRUSS, LOOKING WEST)	**44U1U2W**	ONE	12TC2W
(U9 - U8 EAST TRUSS, LOOKING EAST)	**44U9U8E**	ONE	12TC9E

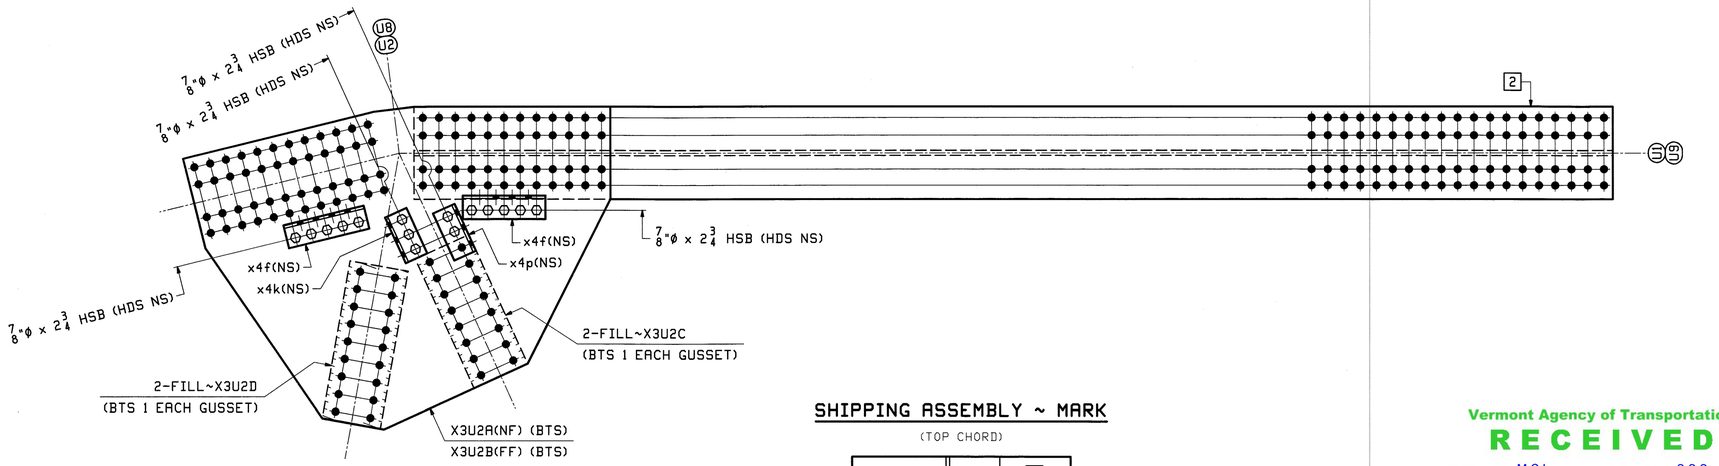

SHIPPING ASSEMBLY ~ MARK

(TOP CHORD)

	MARK	QTY	2
(U8 - U9 WEST TRUSS, LOOKING WEST)	**44U8U9W**	ONE	12TC9W
(U2 - U1 EAST TRUSS, LOOKING EAST)	**44U2U1E**	ONE	12TC2E

Vermont Agency of Transportation

RECEIVED

CK'D BY M.C.L. OK'D BY S.S.S.

January 10 2012

RESUBMIT APPROVED ✓

BY J. LACROIX DATE 01-12-2012

NOTES:
1. NF - DENOTES NEAR FACE OF TOP CHORD.
2. FF - DENOTES FAR FACE OF TOP CHORD.
3. NS - DENOTES NEAR SIDE.
4. FS - DENOTES FAR SIDE.

ABM INFO		SHIP	BILL OF MATERIAL					JOB NO.	DRAWING NO.	REV.
								498	44	
PAGE	LINE	MARK	QTY	MARK	MATERIAL	LENGTH FT	LENGTH INCHES	REMARKS	WT	PROCUREMENT NOTES
		44U1U2W	1		TOP CHORD SHIPPING ASS'Y				7238	
			1	12TC2W	TOP CHORD					
8	J		1	X3U2A	PL 3/4 x 55 3/4	6	0 3/8	M270-HPS70W		
8	J		1	X3U2B	PL 3/4 x 55 3/4	6	0 3/8	M270-HPS70W		
9	S		2	X3U2C	PL 13/16 x 10	2	0	FILL		
9	R		2	X3U2D	PL 13/16 x 10	2	3	FILL		
9	U		2	x4f	L 4x4x1/2	1	2	M270-36		
9	T		1	x4k	L 6x4x1/2	0	8 1/2	M270-36		
9	T		1	x4m	L 6x4x1/2	0	8 3/4	M270-36		
21	E		15		7/8 ø HSB	0	2 3/4	MECH. GALV. A325-1		
21	X		15		7/8 ø HSW			MECH. GALV. F436		
21	Y		15		LOAD IND. 7/8 ø WASH FOR HSB			MECH. GALV. F436		
		44U9U8E	1		TOP CHORD SHIPPING ASS'Y				7238	
			1	12TC9E	TOP CHORD					
8	J		1	X3U2A	PL 3/4 x 55 3/4	6	0 3/8	M270-HPS70W		
8	J		1	X3U2B	PL 3/4 x 55 3/4	6	0 3/8	M270-HPS70W		
9	S		2	X3U2C	PL 13/16 x 10	2	0	FILL		
9	R		2	X3U2D	PL 13/16 x 10	2	3	FILL		
9	U		2	x4f	L 4x4x1/2	1	2	M270-36		
9	T		1	x4k	L 6x4x1/2	0	8 1/2	M270-36		
9	T		1	x4m	L 6x4x1/2	0	8 3/4	M270-36		
21	E		15		7/8 ø HSB	0	2 3/4	MECH. GALV. A325-1		
21	X		15		7/8 ø HSW			MECH. GALV. F436		
21	Y		15		LOAD IND. 7/8 ø WASH FOR HSB			MECH. GALV. F436		
		44U8U9W	1		TOP CHORD SHIPPING ASS'Y				7238	
			1	12TC9W	TOP CHORD					
8	J		1	X3U2A	PL 3/4 x 55 3/4	6	0 3/8	M270-HPS70W		
8	J		1	X3U2B	PL 3/4 x 55 3/4	6	0 3/8	M270-HPS70W		
9	S		2	X3U2C	PL 13/16 x 10	2	0	FILL		
9	R		2	X3U2D	PL 13/16 x 10	2	3	FILL		
9	U		2	x4f	L 4x4x1/2	1	2	M270-36		
9	T		1	x4k	L 6x4x1/2	0	8 1/2	M270-36		
9	T		1	x4m	L 6x4x1/2	0	8 3/4	M270-36		
21	E		15		7/8 ø HSB	0	2 3/4	MECH. GALV. A325-1		
21	X		15		7/8 ø HSW			MECH. GALV. F436		
21	Y		15		LOAD IND. 7/8 ø WASH FOR HSB			MECH. GALV. F436		
		44U2U1E	1		TOP CHORD SHIPPING ASS'Y				7238	
			1	12TC2E	TOP CHORD					
8	J		1	X3U2A	PL 3/4 x 55 3/4	6	0 3/8	M270-HPS70W		
8	J		1	X3U2B	PL 3/4 x 55 3/4	6	0 3/8	M270-HPS70W		
9	S		2	X3U2C	PL 13/16 x 10	2	0	FILL		
9	R		2	X3U2D	PL 13/16 x 10	2	3	FILL		
9	U		2	x4f	L 4x4x1/2	1	2	M270-36		
9	T		1	x4k	L 6x4x1/2	0	8 1/2	M270-36		
9	T		1	x4m	L 6x4x1/2	0	8 3/4	M270-36		
21	E		15		7/8 ø HSB	0	2 3/4	MECH. GALV. A325-1		
21	X		15		7/8 ø HSW			MECH. GALV. F436		
21	Y		15		LOAD IND. 7/8 ø WASH FOR HSB			MECH. GALV. F436		

JAN 9 2012

NOV 30 2011

REV.	DATE	REMARKS	DWN	CHK	APVL	SHOP
0						

MATERIAL:	SURFACE PREP. & PAINT:	HOLES:	SHOP BOLTS:
M270-50 (UN)	HOT-DIP GALV.	15/16 ø (UN)	7/8 ø (UN)

DESCRIPTION: SHIPPING ASSEMBLY (U1-U2, U9-U8, U8-U9 & U2-U1)

CASCO BAY STEEL STRUCTURES, INC.
1 WALLACE AVE. PHONE (207) 780-6722
SOUTH PORTLAND, ME 04106 FAX. (207) 780-6726
TENSOR 3073

STRUCTURE: VT RTE 107 OVER WHITE RIVER	DRAWN: EEO	DATE: 11/21
	CHKD: PCP	DATE: 11/28
LOCATION: BETHEL, VT.	JOB NO. 498	DWG NO. 44
PROJ NO. BRF 022-1(14)		REV. △
CUSTOMER: BECK & BELLUCCI		

EEO Tue, Nov 29, 2011 03:46:01 PM /users/jobs/3073/44.1 Rev0