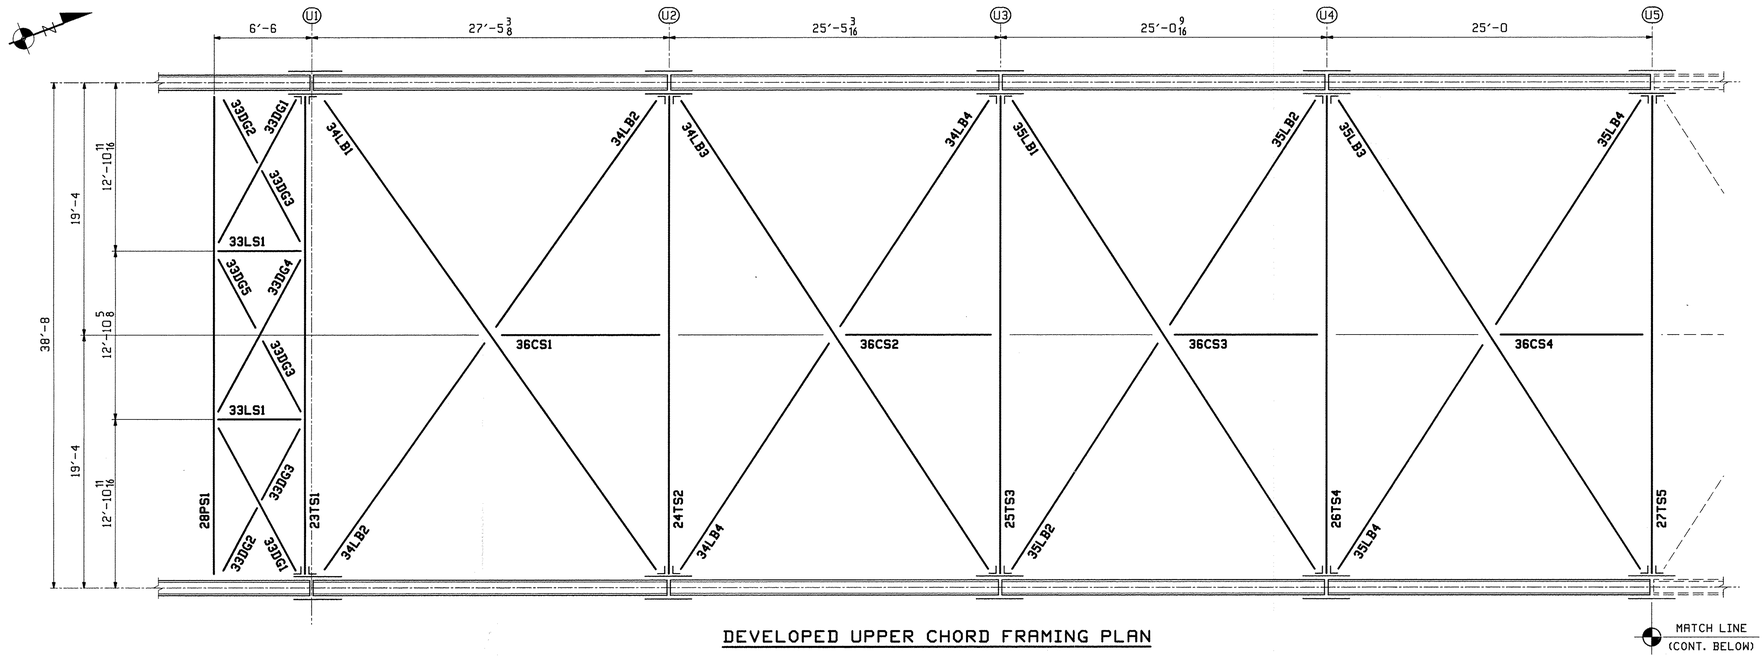

DEVELOPED UPPER CHORD FRAMING PLAN

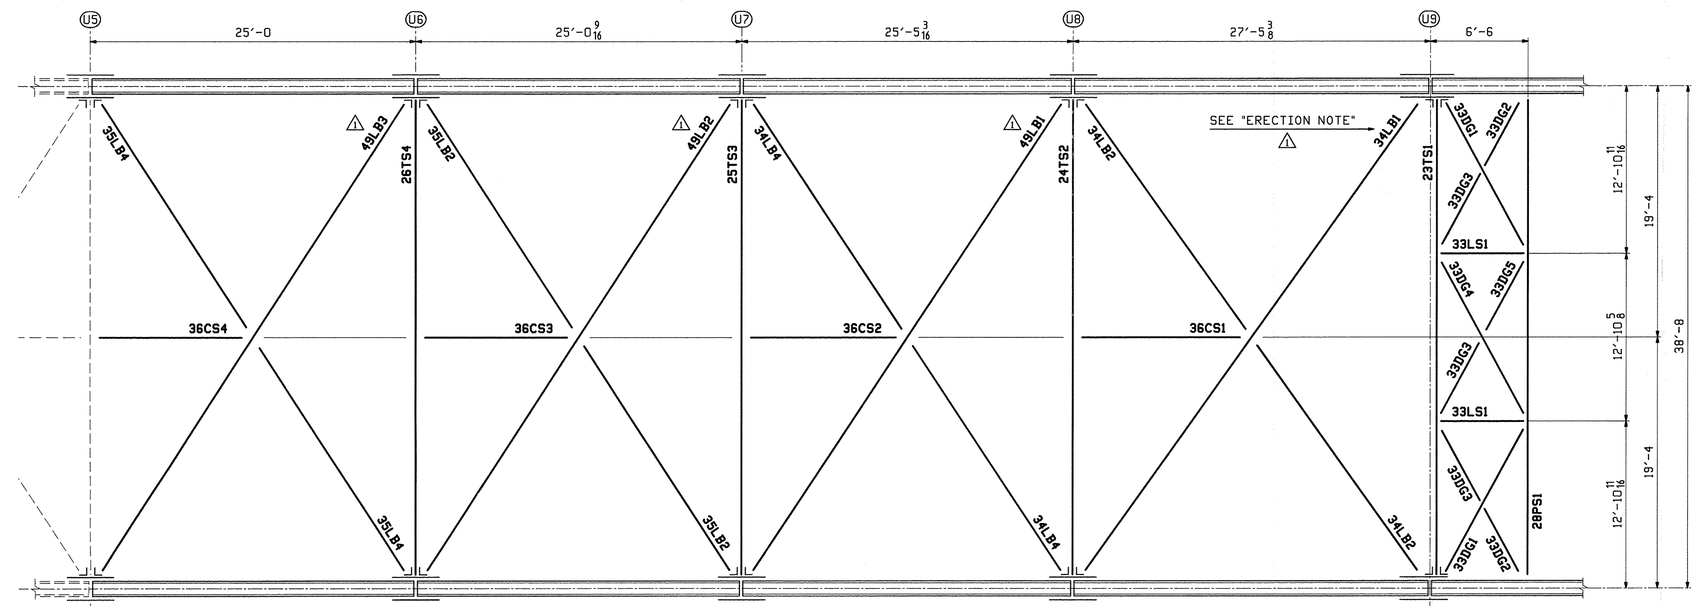

DEVELOPED UPPER CHORD FRAMING PLAN (CONTINUED)

ERECTION NOTE:
IF CENTER GUSSET PLATES ARE BOLTED TO BRACE 34LB1, TURN BRACE 34LB1 OVER SO THE BOTTOM FLANGE IS ON TOP.

NOTES:
1. REFER TO SHEET GN1 FOR GENERAL NOTES.
2. WORK THIS SHEET WITH SHEETS E1, E3 & E4.

REV.	DATE	REMARKS	DWN	CHK	APVL	SHOP
1	9/14/12	REV'D MARKS & ADDED ERECTION NOTE	EEO	PCP		
0						

MATERIAL: | SURFACE PREP. & PAINT: | HOLES: | SHOP BOLTS:

DESCRIPTION: DEVELOPED UPPER CHORD FRAMING PLAN

CASCO BAY STEEL STRUCTURES, INC.
1 WALLACE AVE. PHONE (207) 780-6722
SOUTH PORTLAND, ME 04106 FAX. (207) 780-6726
TENSOR 3073

STRUCTURE: VT RTE 107 OVER WHITE RIVER

DRAWN:	EEO	DATE:	11/02
CHKD:	PCP	DATE:	11/03
LOCATION:	BETHEL, VT.	JOB NO.	DWG NO.
PROJ NO.	BRF 022-1(14)	498	E2
CUSTOMER:	BECK & BELLUCCI		REV. 1