STATE OF VERMONT
AGENCY OF TRANSPORTATION

TRAFFIC SIGN SUMMARY SHEET

VAOT Metric

KILOMETER MARKER, STATION, OR SIGN NUMBER	SIGN LEGEND	SIGN DIMENSIONS EA	SIGN DIMENSIONS WIDTH (mm)	SIGN DIMENSIONS HEIGHT (mm)	NEW & SALVAGED SIGNS "A"	NEW & SALVAGED SIGNS "B"	NEW & SALVAGED SIGNS SALV SIGN	NEW & SALVAGED SIGNS SALV TIS	EXIST POST RETAIN	EXIST POST SALVAGE	NEW SIGN POSTS NO. OF POSTS	FLANGED CHANNEL kg/m 1.7	FLANGED CHANNEL kg/m 3.0	FLANGED CHANNEL kg/m 4.5	SQUARE STEEL (mm) kg/m 44 2.8	SQUARE STEEL (mm) kg/m 50 3.6	SQUARE STEEL (mm) kg/m 63 5.0	ANCHOR	SLEEVE	TUBULAR ALUMINUM Ø (mm) kg/m 75 1.9	TUBULAR ALUMINUM Ø (mm) kg/m 100 2.5	TUBULAR ALUMINUM Ø (mm) kg/m 100 MOD 2.5	FOUND-ATION	TUBULAR STEEL Ø (mm) kg/m 75 11.3	TUBULAR STEEL Ø (mm) kg/m 89 13.4	TUBULAR STEEL Ø (mm) kg/m 100 16.1	TUBULAR STEEL Ø (mm) kg/m 125 21.7	W-SHAPE STEEL FTG. SIZE 24"	W-SHAPE STEEL FTG. SIZE 30"	W-SHAPE STEEL WEIGHT	W-SHAPE STEEL POST SIZE	SIGN FRAME REQUIRED	REMARKS	SIGN DETAIL DETAIL ON SHEET NUMBER	SIGN DETAIL STD. SHEET NUMBER
												OPTION ITEMS																								
STA. 10+060.000, RT.	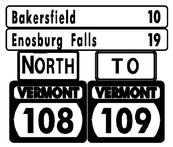		1800 1800 600 600 750 750	300 300 300 300 600 600	.56 ~~.54~~ .56 ~~.54~~ .19 ~~.18~~ .19 ~~.18~~ .46 ~~.45~~ .46 ~~.45~~						2					X															X	M3-1 M4-5 MI-6B MI-6B	71	E-123 E-123 SHS E-136B
	TOTALS				2.42 ~~2.34~~											9.1																				
STA. 10+105.000, LT.	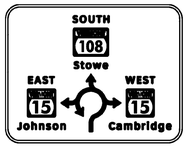																																	SEE CAMBRIDGE BRF 027-1(4) PROJECT FOR SIGN INFORMATION		
STA. 10+165.000, LT.																																		SEE CAMBRIDGE BRF 027-1(4) PROJECT FOR SIGN INFORMATION		
	TOTAL TSS SHEET 1				5.82	11.32										36.6							2				198.4									
	TOTAL TSS SHEET 2				7.23											59.4																				
	TOTAL TSS SHEET 3				6.74	22.64										45.7							4				396.8									
	TOTAL TSS SHEET 4				6.83											41.1																				
	TOTAL TSS SHEET 5				2.34											9.1																				
											m	m	m	m	m 191.9	m		EA	kg	kg	kg		kg	kg	kg	kg									
	TOTALS				m2 ~~28.96~~ 29.89	m2 33.96	EA.	m2			m			m 191.9					kg			EA. 6	kg 595.2				EA.	EA.	kg						

SHS = MUTCD STANDARD HIGHWAY SIGNS

FINAL POST LENGTHS ARE TO BE DETERMINED IN THE FIELD. POST SIZES ARE COMPUTED BASED ON INFORMATION FURNISHED ON THE STANDARD SHEETS AND THE VTRANS "SIGN POST DESIGN GUIDELINE."

PROJECT NAME: CAMBRIDGE
PROJECT NUMBER: STP 030-2(27)

FILE NAME: t78f163frm.dgn
PROJECT LEADER: JLS
DESIGNED BY: MBL
TRAFFIC SIGN SUMMARY SHEET 5

PLOT DATE: 05-JUN-2012
DRAWN BY: MBL
CHECKED BY: JAD
SHEET 70 OF 214