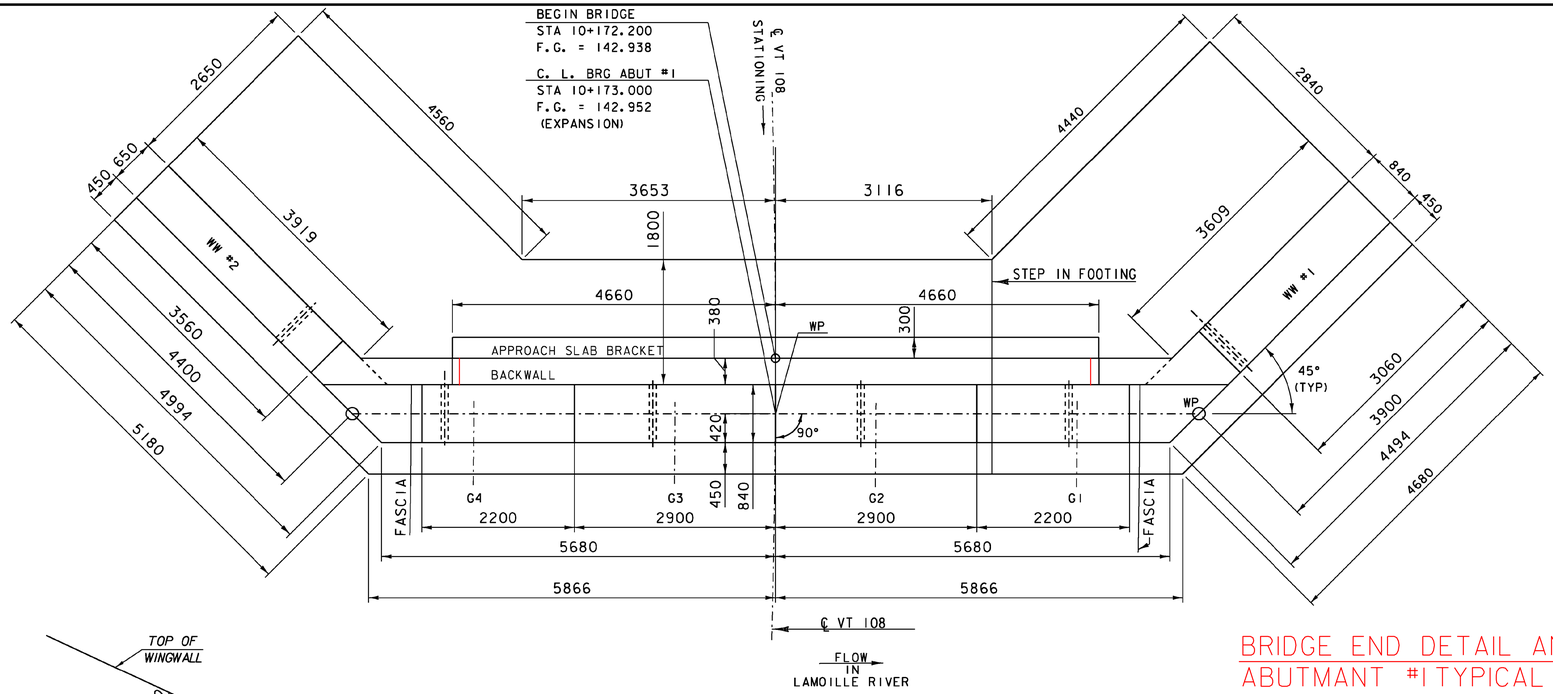

ABUTMENT #1 PLAN

SCALE = 1:40

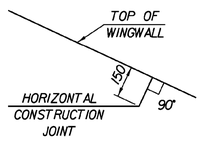

DETAIL A

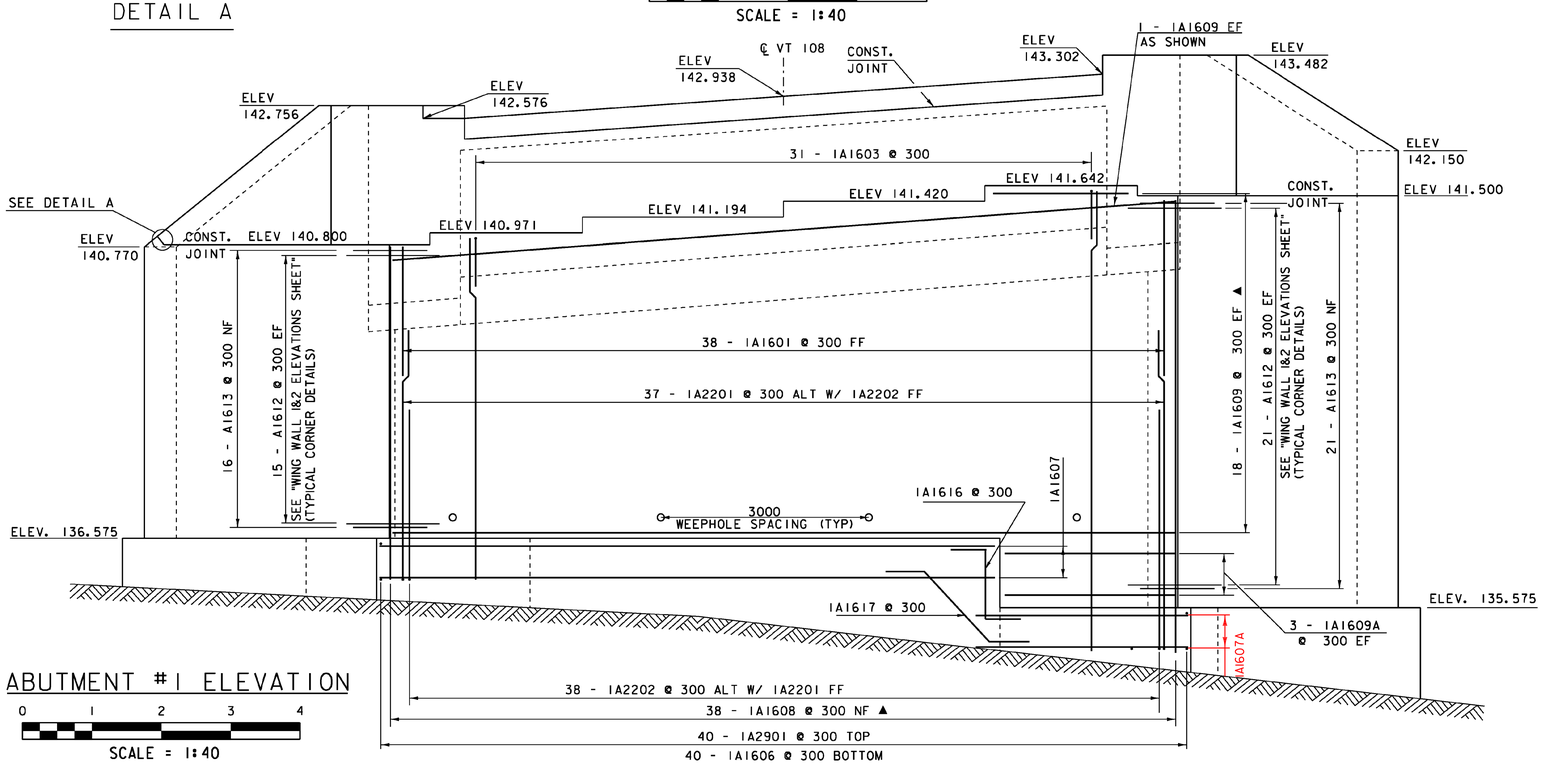

ABUTMENT #1 ELEVATION

SCALE = 1:40

BRIDGE END DETAIL AND ABUTMANT #1 TYPICAL SECTION

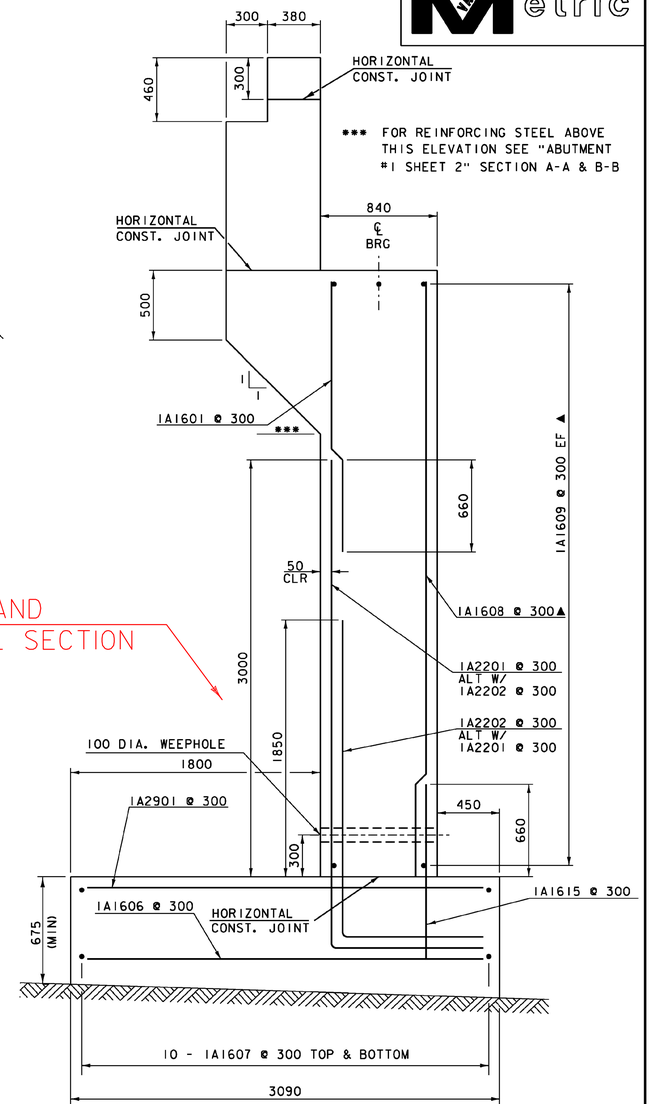

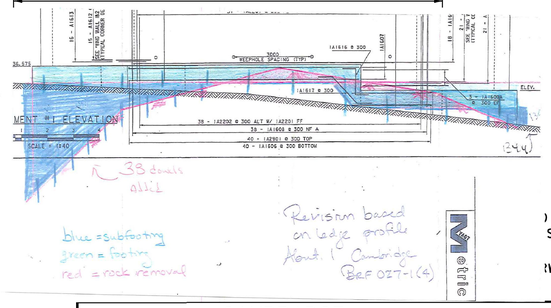

PROJECT NAME:	CAMBRIDGE		
PROJECT NUMBER:	BRF 027-1 (4)		
FILE NAME:	78f163subst.dgn	PLOT DATE:	05-JUN-2012
PROJECT LEADER:	M. EVANS-MONGEON	DRAWN BY:	R. PELLETT
DESIGNED BY:	T. FILLBACH	CHECKED BY:	T. FILLBACH
ABUTMENT #1 SHEET 1		SHEET 172	OF 214