Metric

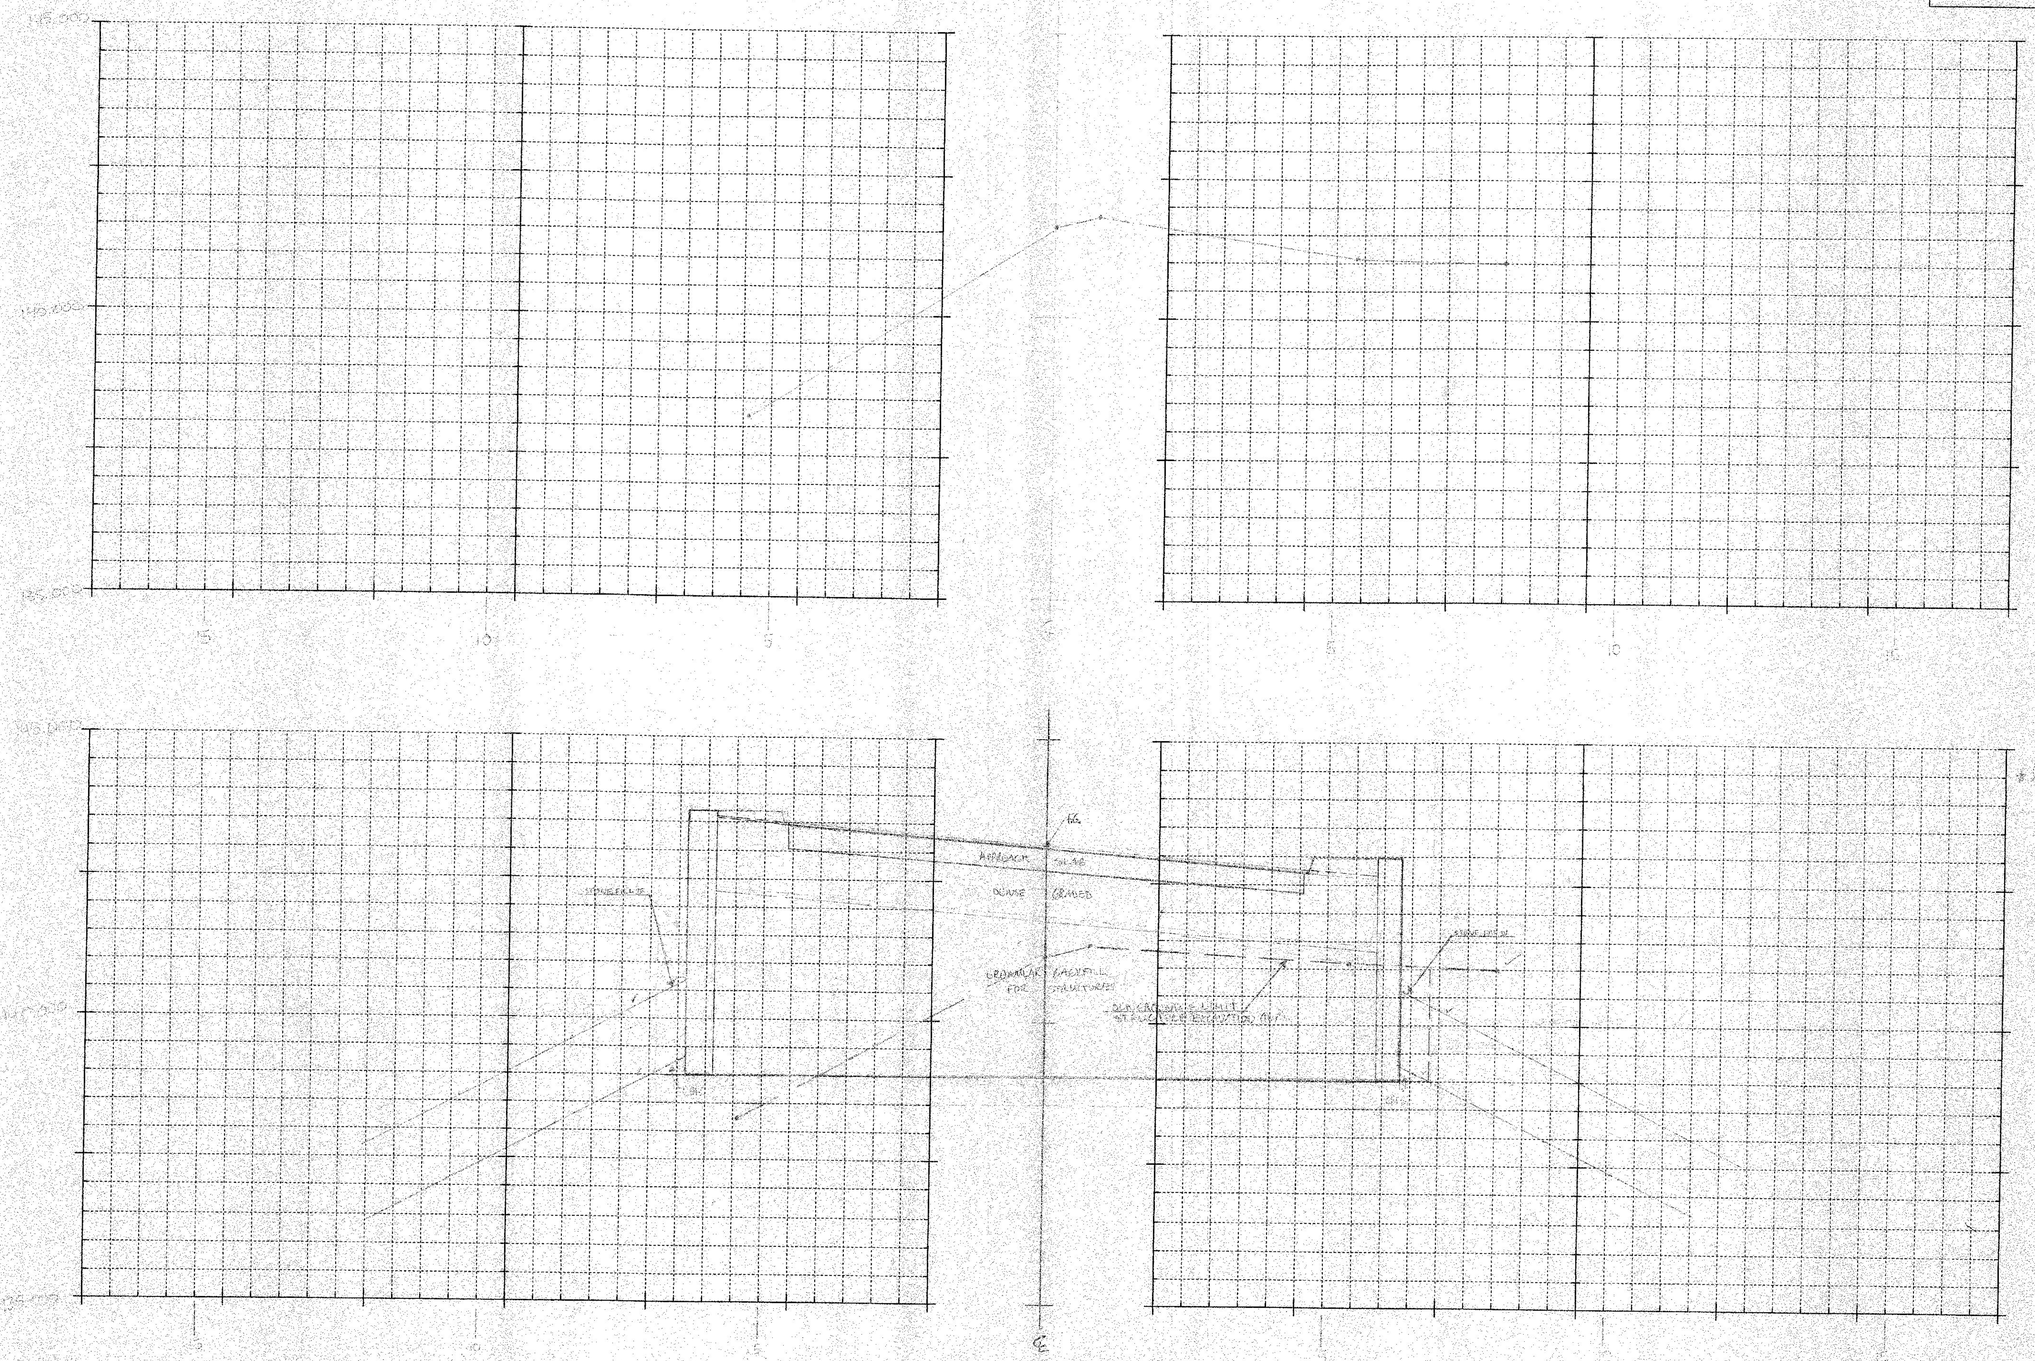

0 2 4 6 8 10
SCALE 1:100

PROJECT:	PROJECT NO.:
DESIGN FILE NAME:	
IPARM FILE NAME:	PLOT DATE:
MAINLINE ROADWAY SECTIONS	
	SHEET: OF