Metric

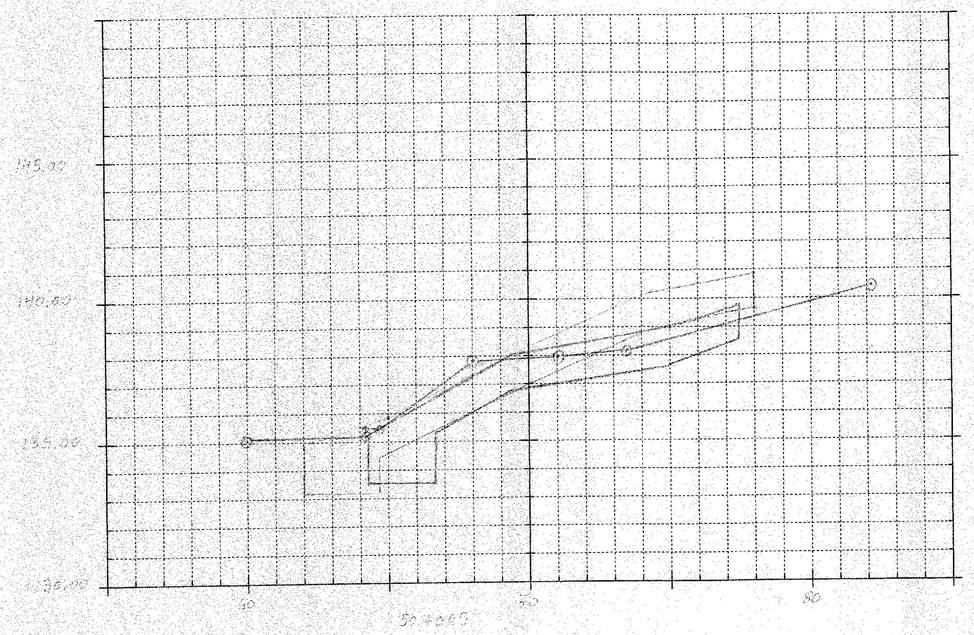

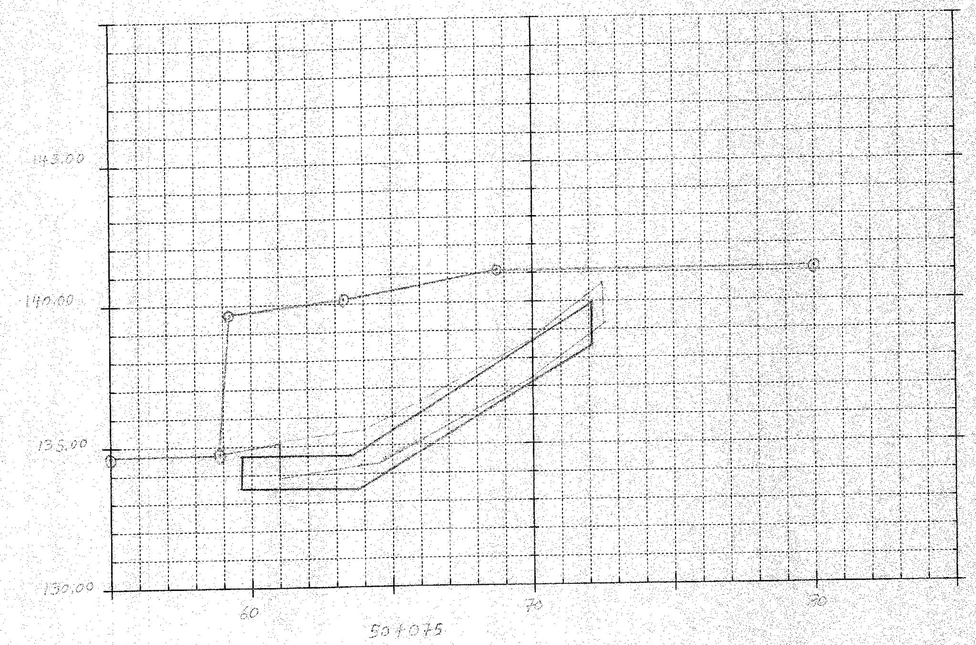

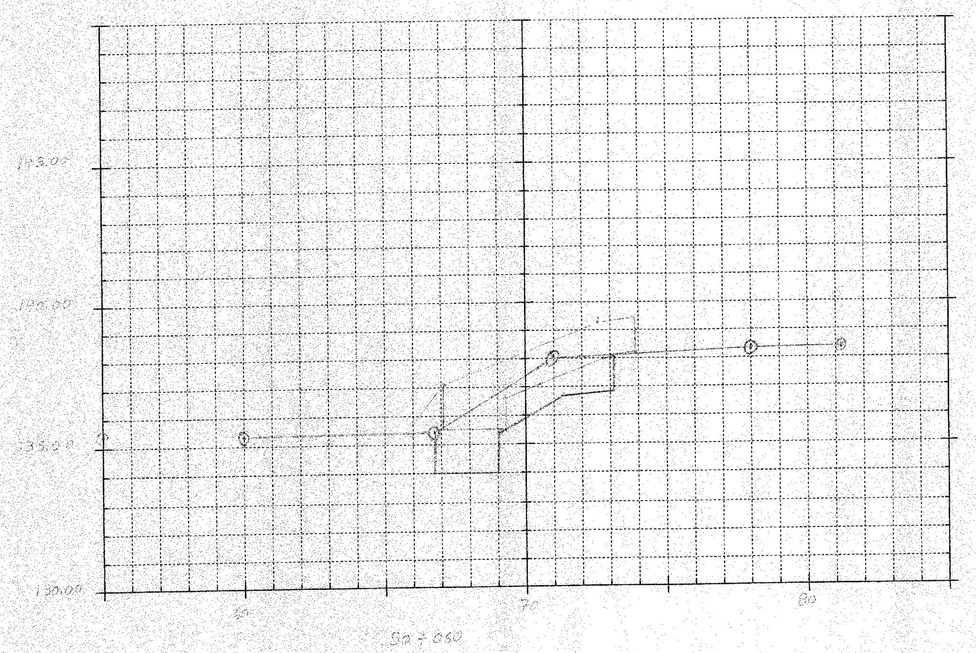

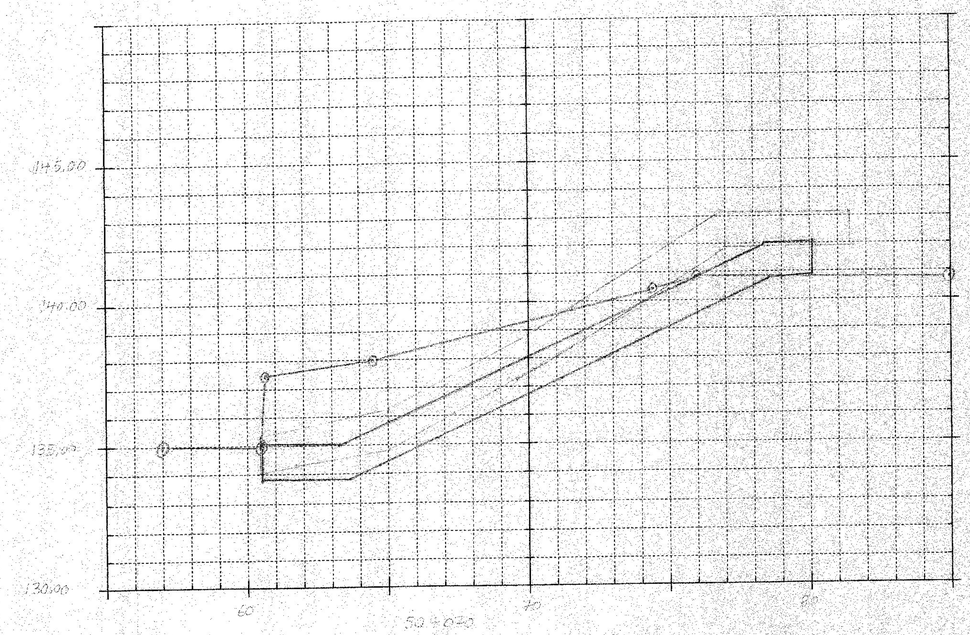

MOE H-70-13 Original Sections Pinkal JPO 09-31-17
MOE H-70-13 Original Templates
MOE H-70-13 Final Sections " JPO 03-18-13

0 2 4 6 8 10
SCALE 1:100

PROJECT:	PROJECT NO.:
DESIGN FILE NAME: IPARM FILE NAME:	PLOT DATE:
MAINLINE ROADWAY SECTIONS	SHEET: ____ OF ____