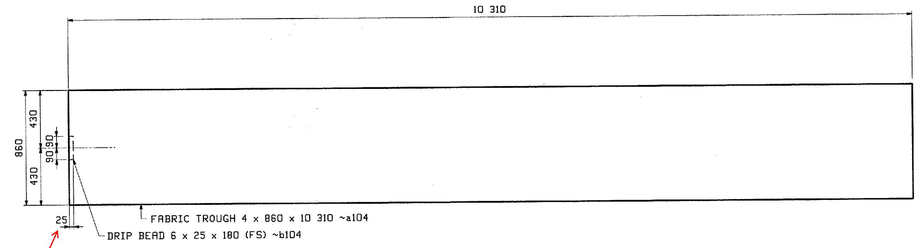

Begin Application of the Drip Bead 25 away from end of trough

1 - FABRIC TROUGH - 104FT1

1.) FABRIC DRAIN TROUGH SHALL BE 3-PLY PREFORMED FABRIC MATERIAL CONFORMING TO SECTION 707.07 AND SHALL BE CUT PRE-ASSEMBLY FROM ONE PIECE.

2.) DRIP BEAD OF FABRIC MATERIAL SHALL BE CEMENTED TO THE BOTTOM OF THE FABRIC TROUGH.

RBM INFO		SHIP	BILL OF MATERIAL					JOB NO.	BRAKING NO.		REV.
						LENGTH		524	104		
PAGE	LINE	MARK	QTY	MARK	MATERIAL	m	ss	REMARKS	WT	PROCUREMENT NOTES	
		104FT1	1		FABRIC TROUGH						
9	N		1	a104	4en x 890 x10 310 TROUGH			3 PLY FABRIC			
9	P		1	b104	6en x 25 x 180 DRIP BEAD			3 PLY FABRIC			

Vermont Agency of Transportation

RECEIVED

CK'D BY J. GRIFFIN OK'D BY M.UMBERGER

APR. 03, 2013

RESUBMIT APPROVED AS NOTED ✓

BY J. LACROIX DATE 04-10-2013

REV.	DATE	REMARKS	DWN	CHK	APVL	SHOP
0					MAR 28 2013	

MATERIAL:	SURFACE PREP. & PAINT:	HOLES:	SHOP BOLTS:
		AS NOTED	AS NOTED

DESCRIPTION: FABRIC TROUGH

CASCO BAY STEEL STRUCTURES, INC.
1 WALLACE AVE. PHONE (207) 780-6722
SOUTH PORTLAND, ME 04106 FAX. (207) 780-6726

STRUCTURE: VT ROUTE 108, BRIDGE #21
MAJOR COLLECTOR
TOWN OF CAMBRIDGE
COUNTY OF LAMOILLE, VERMONT

DRAWN: TJB DATE: 03/22

CHK'D: DH DATE: 03/25

LOCATION: CAMBRIDGE, VERMONT

PROJ NO. BRF 027-1(4)

CUSTOMER: A. L. ST. ONGE CONTRACTING

JOB NO. 524

DWG NO. 104

REV. △