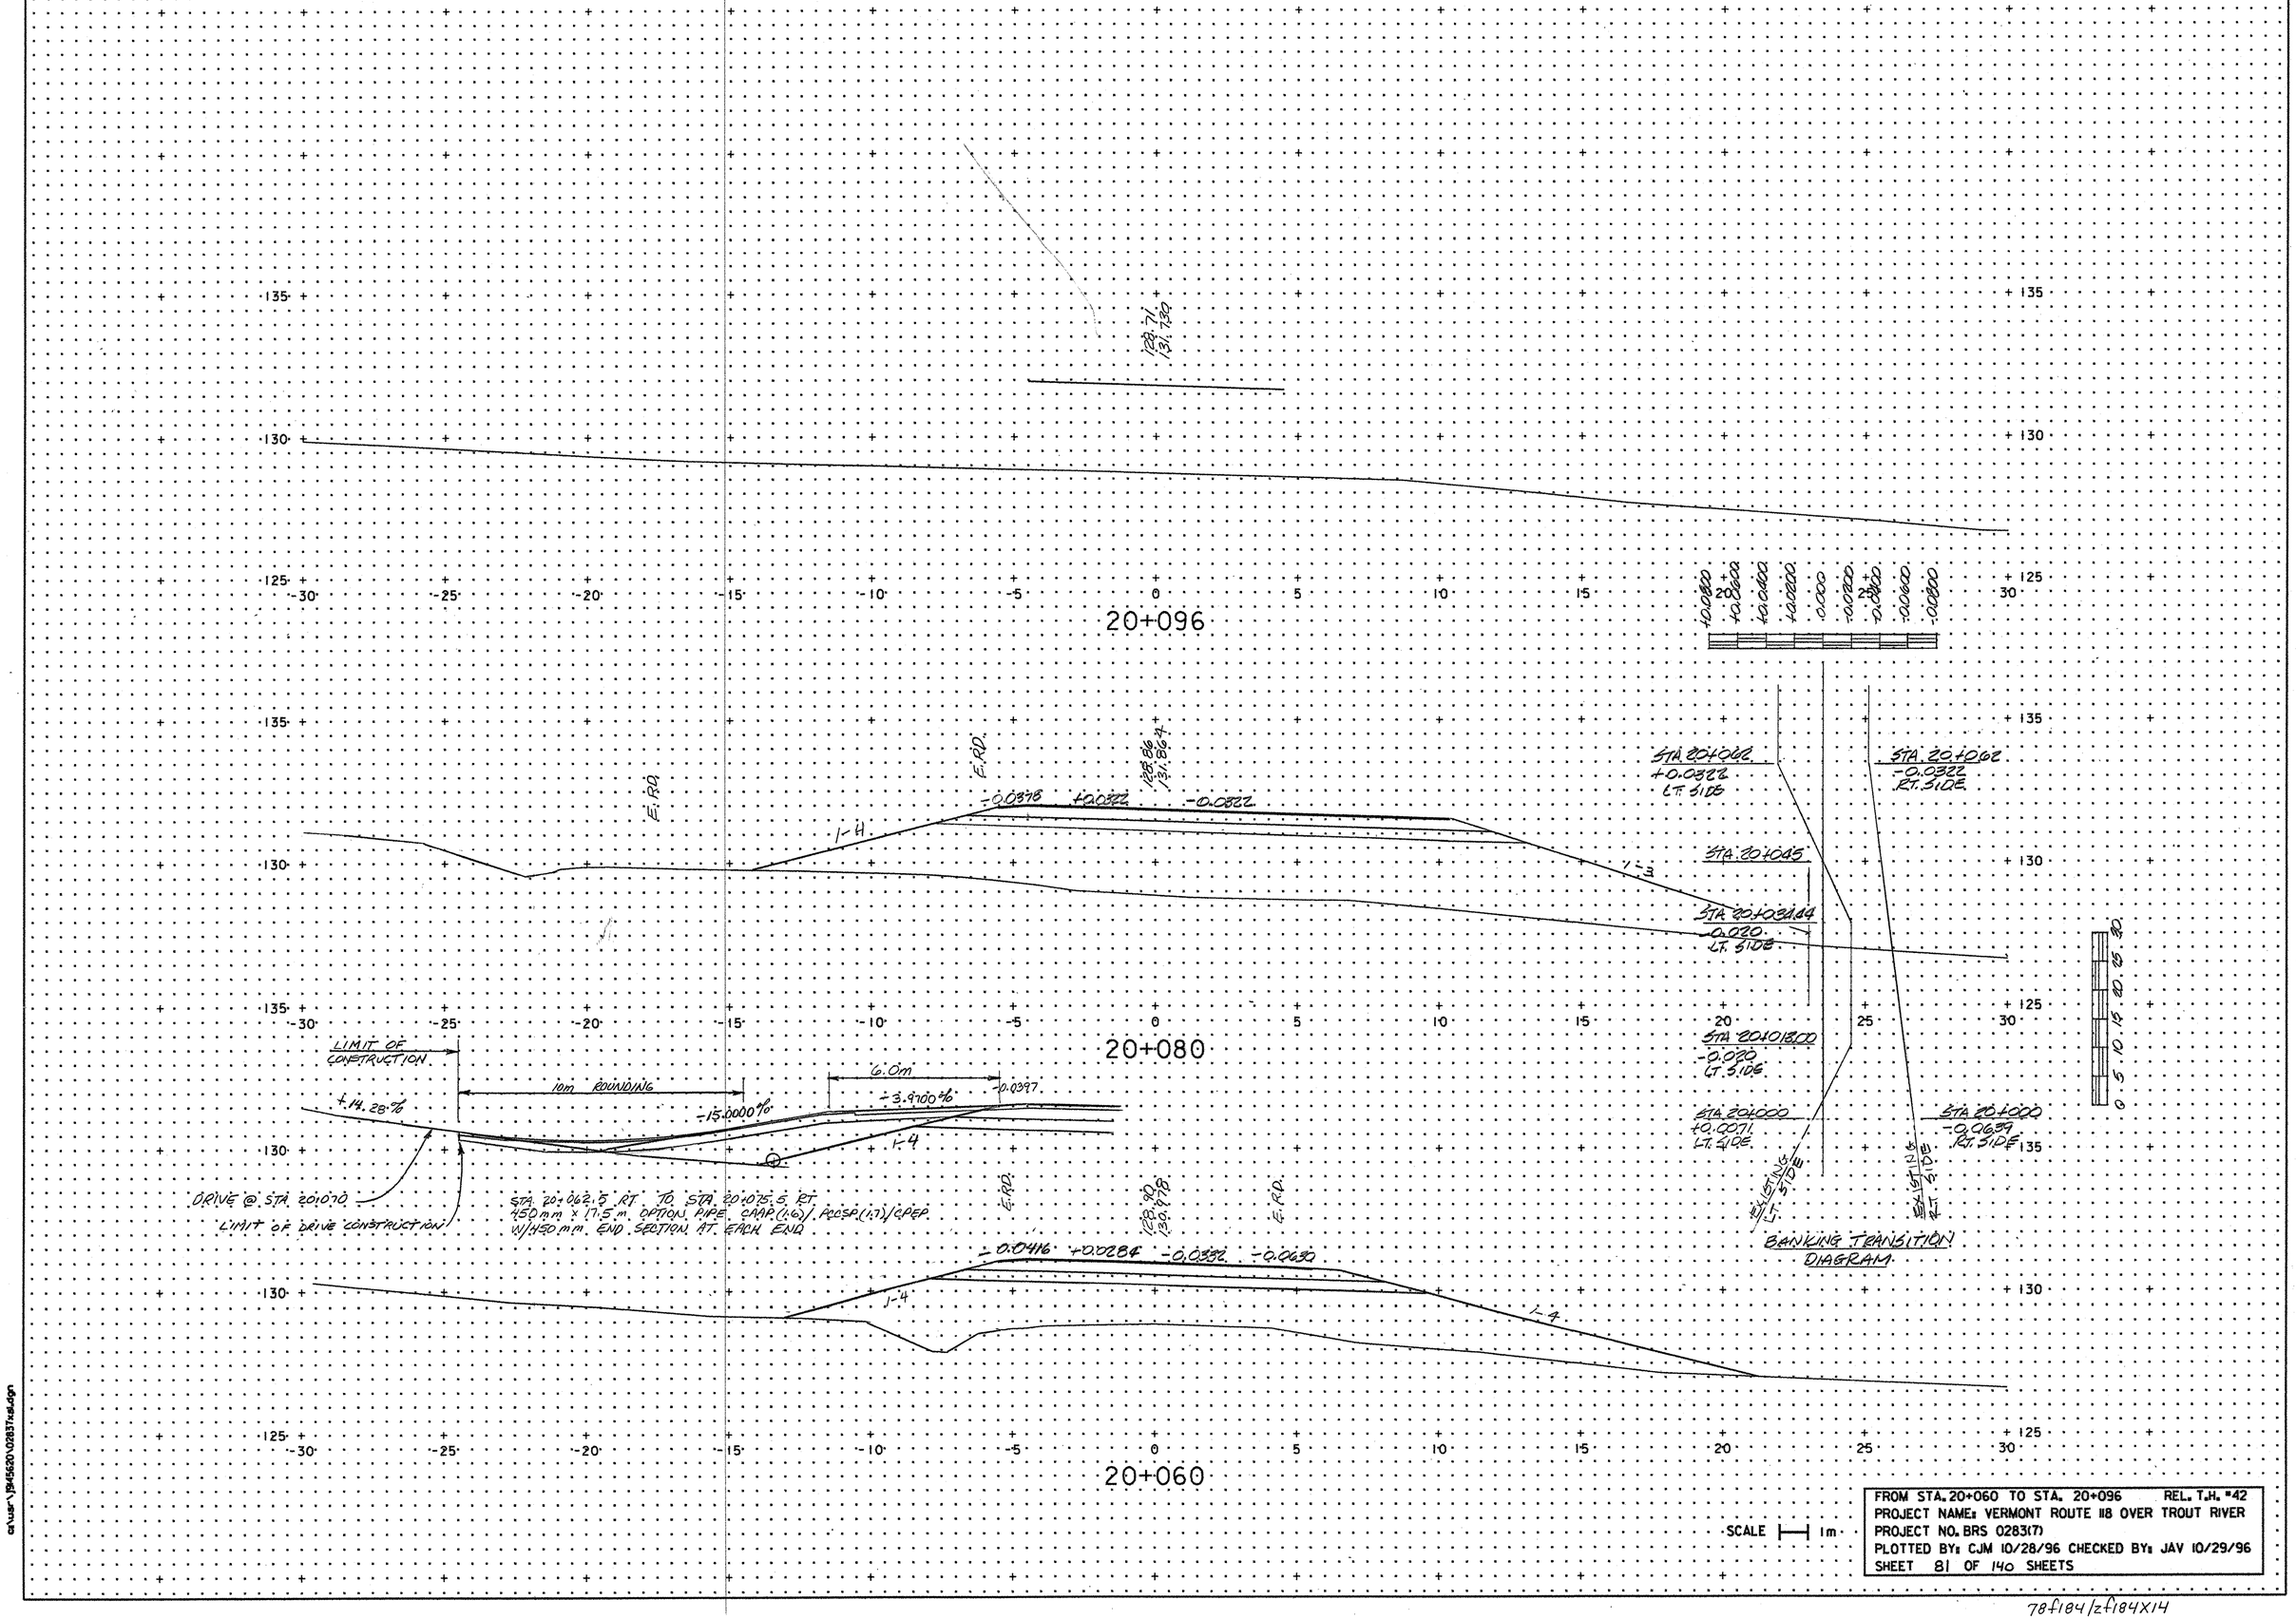

FROM STA. 20+060 TO STA. 20+096 REL. T.H. #42
PROJECT NAME: VERMONT ROUTE 118 OVER TROUT RIVER
PROJECT NO. BRS 0283(7)
PLOTTED BY: CJM 10/28/96 CHECKED BY: JAV 10/29/96
SHEET 81 OF 140 SHEETS

cs\user\3945620\02837xsd.dgn

78f184/zf184X14