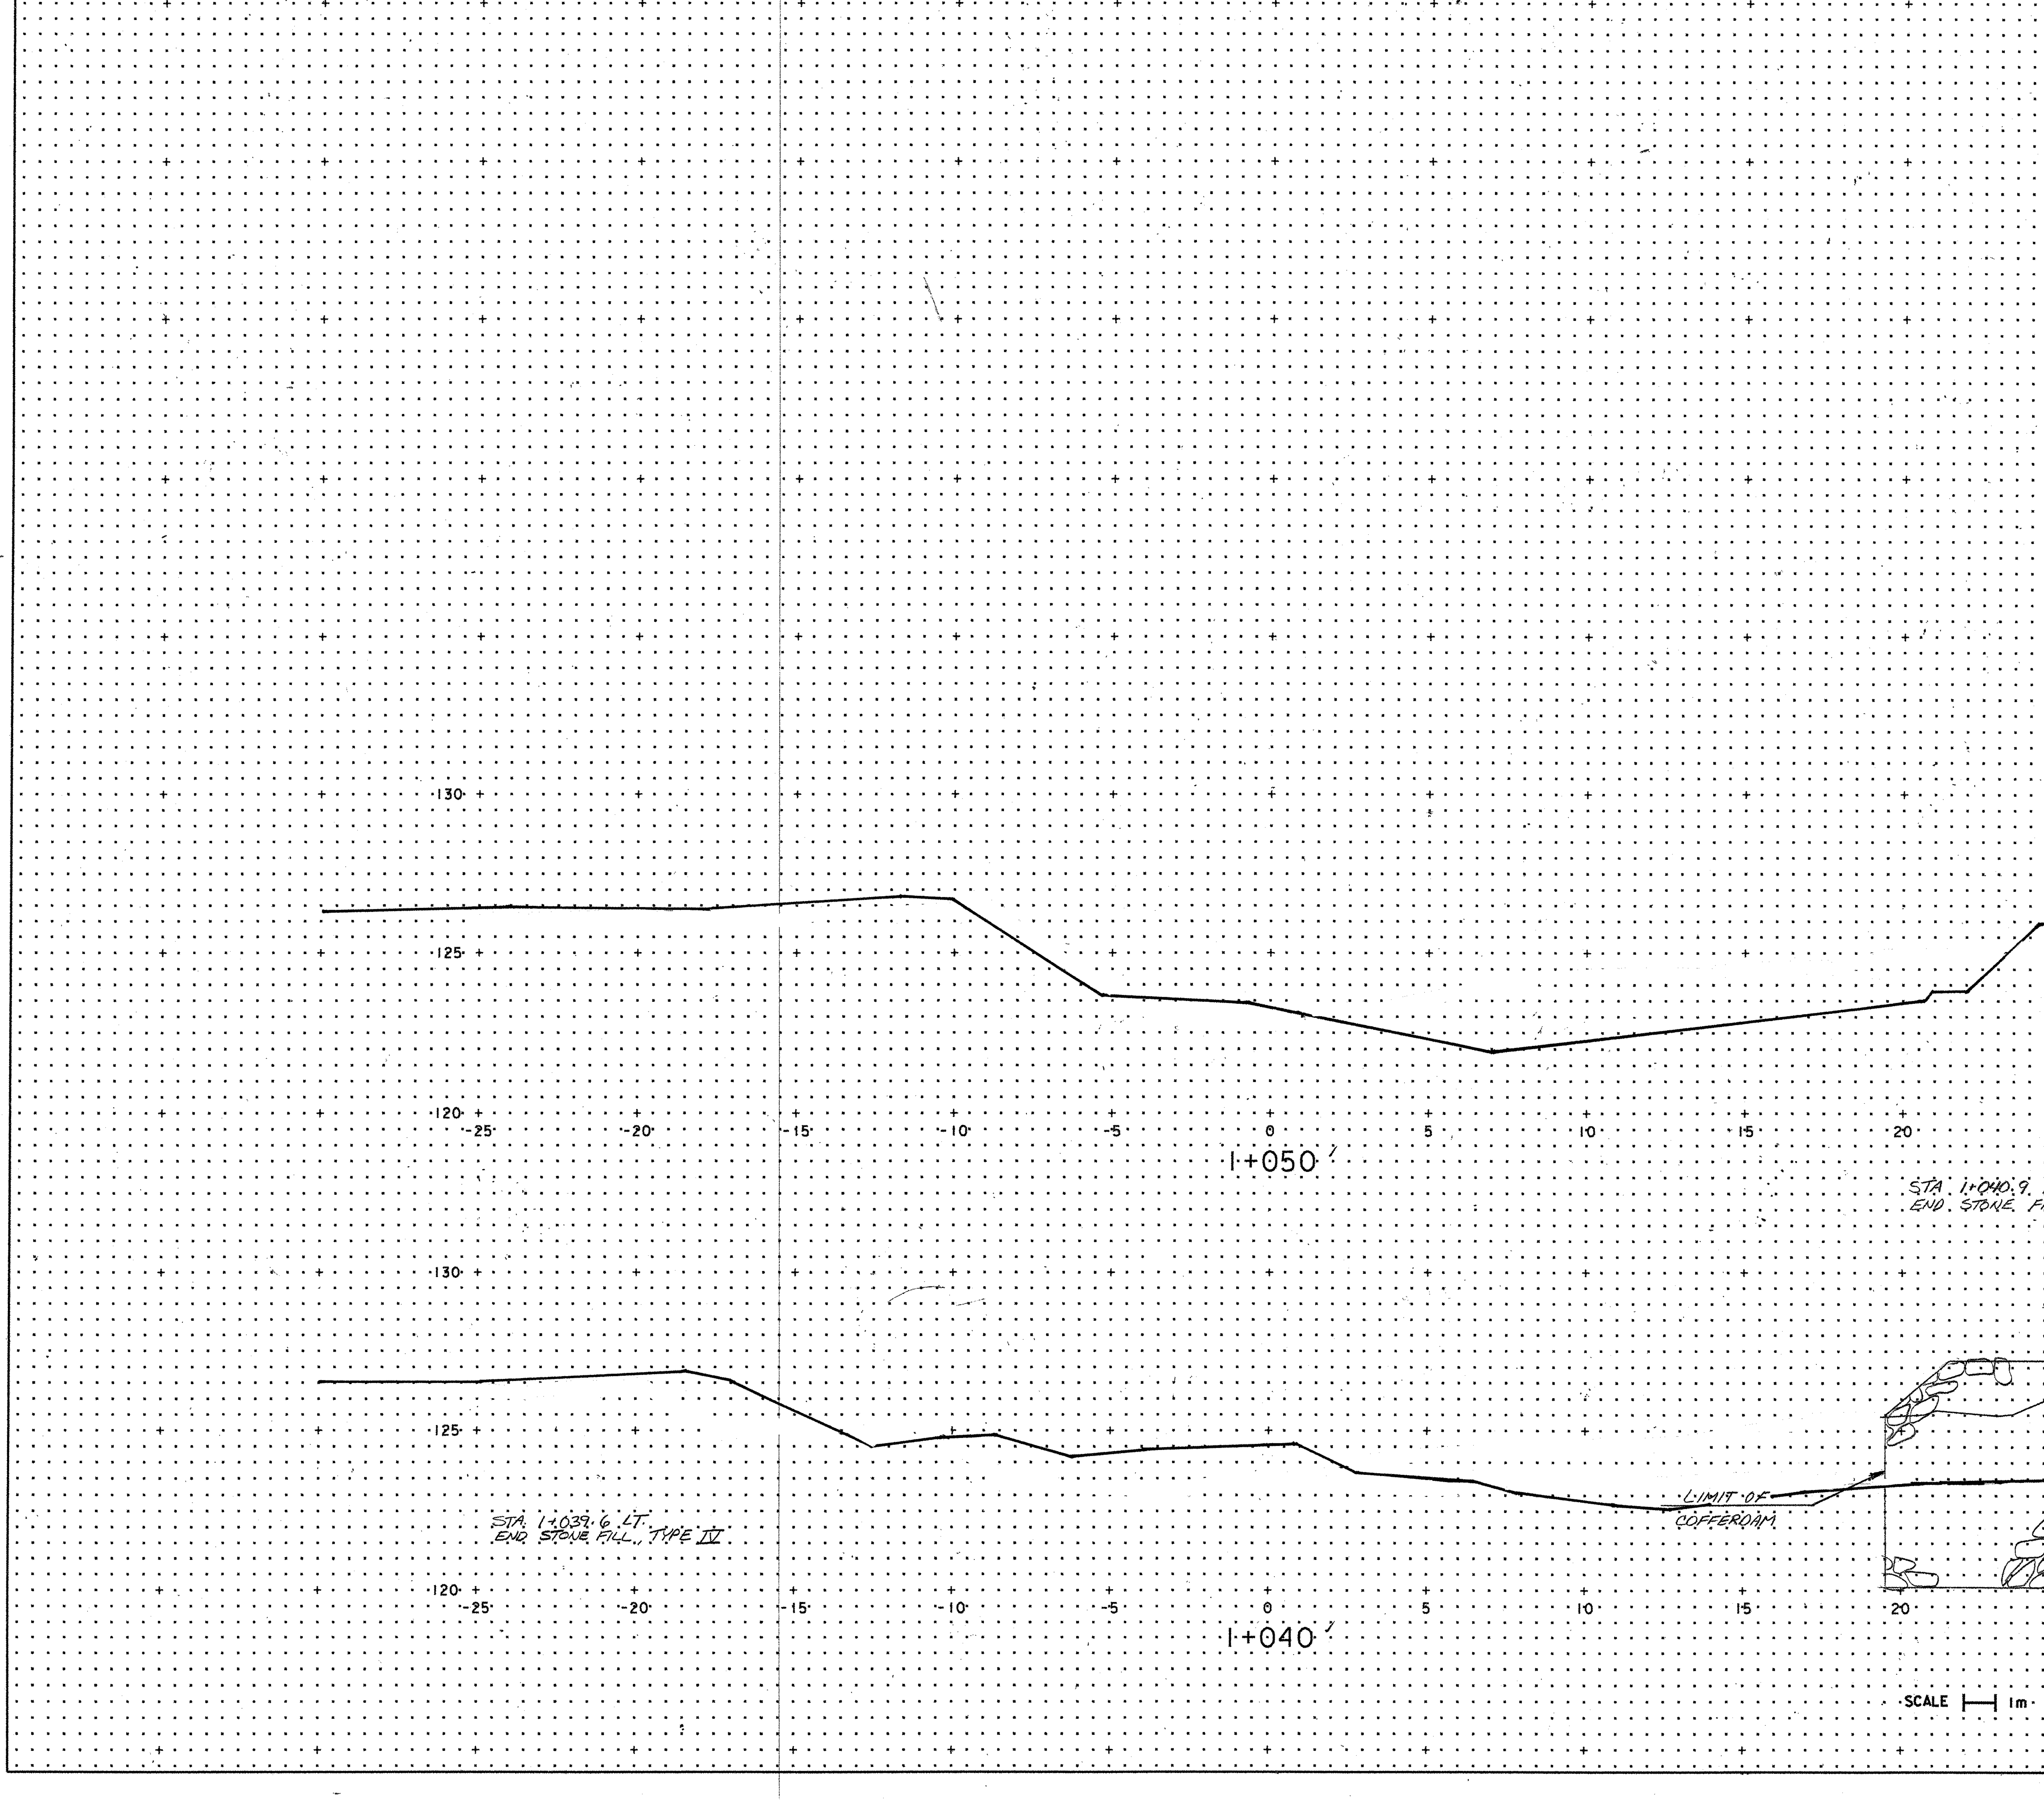

FROM STA. 1+040 TO STA. 1+050 TROUT RIVER
PROJECT NAME: VERMONT ROUTE 118 OVER TROUT RIVER
PROJECT NO. BRS 0283(7)
PLOTTED BY: CJM 10/28/96 CHECKED BY: JAV 10/29/96
SHEET 86 OF 140 SHEETS

78 f 84/zf184cx2

c:\usr\j9456\20\0283\xsl.dgn