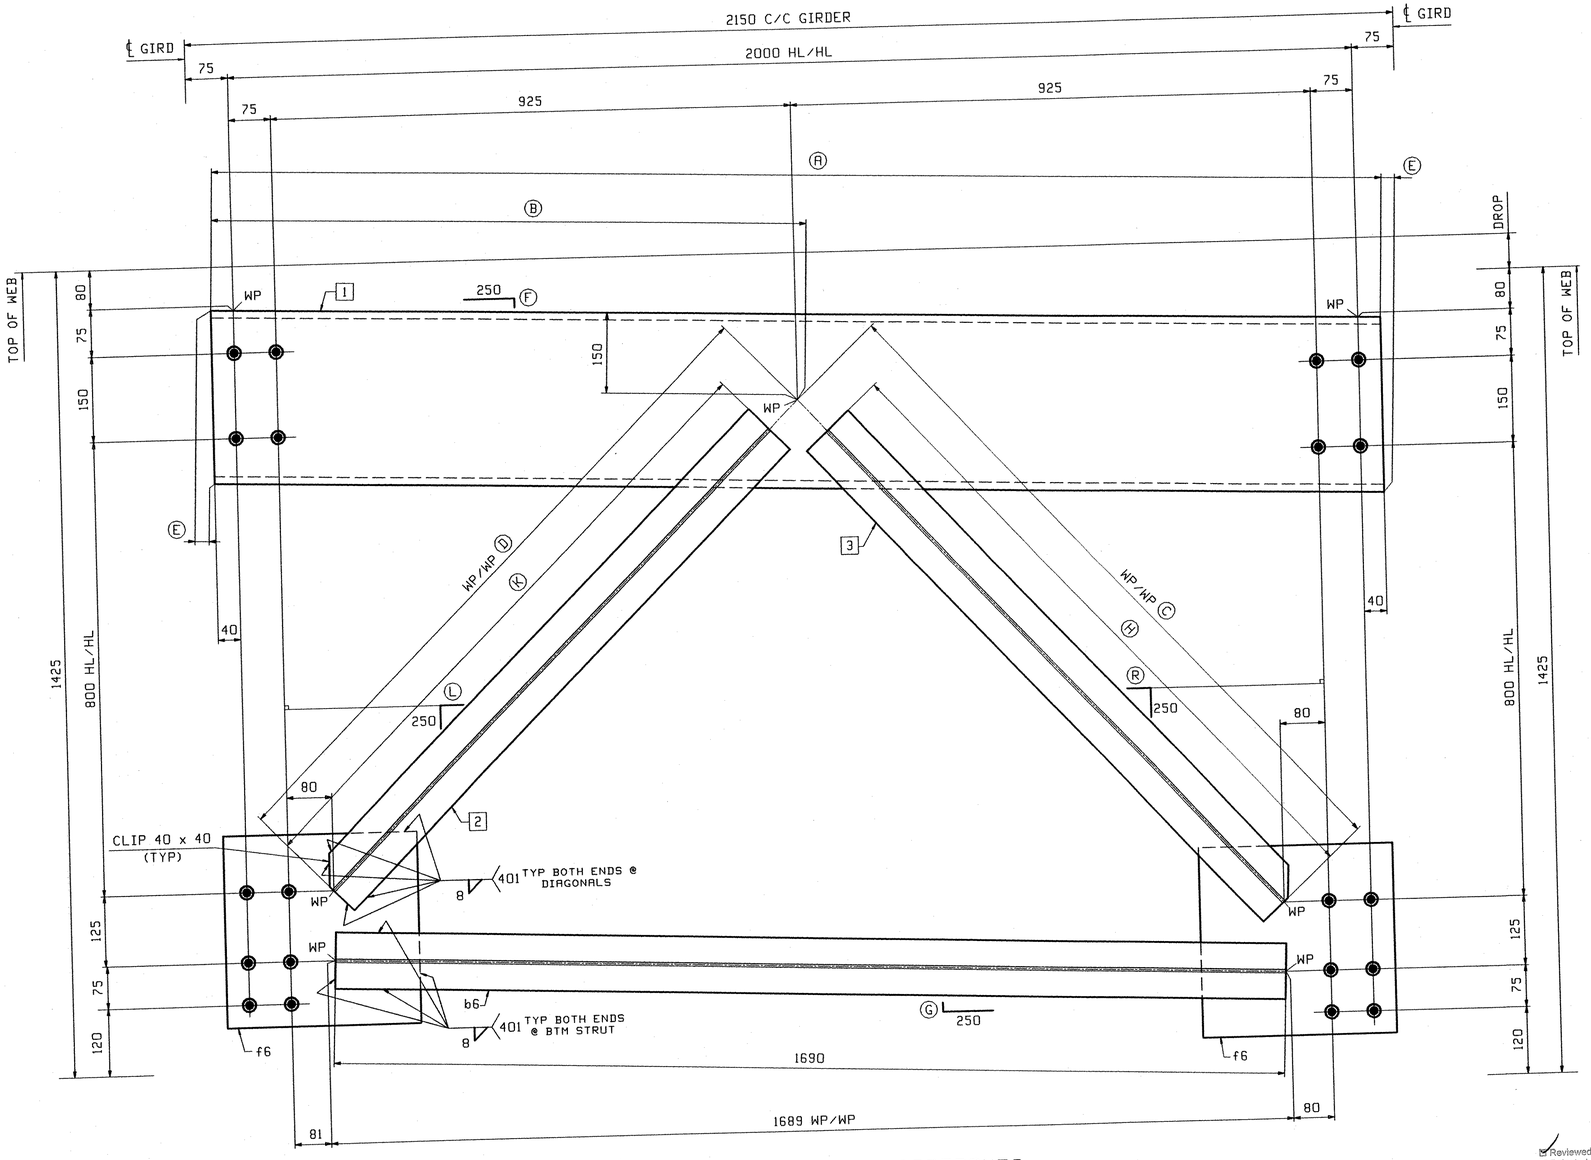

END CROSSFRAMES

(@ ABUTMENTS LOOKING AWAY FROM BACKWALL)

	MARK	REQ'D	DROP	Ⓐ	Ⓑ	Ⓒ	Ⓓ	Ⓔ	Ⓕ	Ⓖ	Ⓗ	Ⓚ	Ⓛ	Ⓡ	1	2	3
G5-G4 (ABUT1)	7CF1	1	63	2081	1045	1239	1194	10	8	9	1160	1120	250	233	a7	c7	d7
G4-G3 (ABUT1)	7CF2	1	43	2080	1043	1232	1201	7	5	6	1155	1130	248	236	g7	h7	k7
G2-G1 (ABUT2)	7CF3	1	63	2081	1045	1239	1194	10	8	9	1160	1120	250	233	a7	c7	d7
G3-G2 (ABUT2)	7CF4	1	43	2080	1043	1232	1201	7	5	6	1155	1130	248	236	g7	h7	k7

PAINTED

BILL OF MATERIAL

ABM INFO PAGE	ABM INFO LINE	SHIP MARK	QTY	MARK	MATERIAL	LENGTH m	LENGTH mm	REMARKS	WT	PROCUREMENT NOTES
		7CF1	1		END CROSSFRAME				145 kg 319 lbs	
2	G		1	a7	C 310x37	2	091	(M270M-345W)		
2	H		1	b6	WT 100x11	1	690	(M270M-345W)		
2	J		1	c7	WT 100x11	1	120	(M270M-345W)		
2	J		1	d7	WT 100x11	1	160	(M270M-345W)		
2	K		2	f6	PL 13x340	0	345	(M270M-345W)		
		7CF2	1		END CROSSFRAME				145 kg 319 lbs	
2	G		1	g7	C 310x37	2	087	(M270M-345W)		
2	H		1	b6	WT 100x11	1	690	(M270M-345W)		
2	J		1	h7	WT 100x11	1	130	(M270M-345W)		
2	J		1	k7	WT 100x11	1	155	(M270M-345W)		
2	K		2	f6	PL 13x340	0	345	(M270M-345W)		
		7CF3	1		END CROSSFRAME				145 kg 319 lbs	
2	G		1	a7	C 310x37	2	091	(M270M-345W)		
2	H		1	b6	WT 100x11	1	690	(M270M-345W)		
2	J		1	c7	WT 100x11	1	120	(M270M-345W)		
2	J		1	d7	WT 100x11	1	160	(M270M-345W)		
2	K		2	f6	PL 13x340	0	345	(M270M-345W)		
		7CF4	1		END CROSSFRAME				145 kg 319 lbs	
2	G		1	g7	C 310x37	2	087	(M270M-345W)		
2	H		1	b6	WT 100x11	1	690	(M270M-345W)		
2	J		1	h7	WT 100x11	1	130	(M270M-345W)		
2	J		1	k7	WT 100x11	1	155	(M270M-345W)		
2	K		2	f6	PL 13x340	0	345	(M270M-345W)		

JOB NO.

DRAWING NO. 7

REV.

NOTES:

FOR GENERAL NOTES & WELD PROCEDURES SEE DRAWING GN1.

FOR DETAIL OF f6 SEE DRG.6

REV.	REMARKS	DATE	DWN	CHK	APP	Q.A.	NO.	DIA.	LGT	TYPE	WASHER
	OUT FOR APPROVAL	8-2-04									
	OUT FOR APPROVAL										
	ISSUED TO SHOP										
	FIELD & OFFICE										

RECEIVED
CK'D BY JWK DA'D BY
OCT 20 2004
RESUBMIT APPROVED
BY DATE 11-01-04

☑ Reviewed ☐ Furnish as Corrected
☐ Rejected ☐ Revise and Resubmit
☐ Submit Specified Item

This review is only for general conformance with the design concept and the information given in the Construction Documents. Corrections or comments made on the shop drawings during this review do not relieve the contractor from compliance with the requirements of the plans and specifications. Review of a specific item shall not include review of an assembly of which the item is a component. The Contractor is responsible for dimensions to be confirmed and correlated at the jobsite; information that pertains solely to the fabrication process or to the means, methods, techniques, sequences and procedures of construction; coordination of the Work with that of all other trades and performing all work in a safe and satisfactory manner

McFarland-Johnson, Inc.
Date 10/18/04
By Steven F. Dalia

MATERIAL: M270M-345W

ELECTRODES:

HOLES: 15/16 Ø U.N.

SHOP BOLTS: NONE

SURFACE PREP. & PAINT:
STEEL WITHIN 2450 OF ABUTMENT 2 SHALL BE PAINTED PER NOTES ON GN1.
ALL OTHER STEEL SHALL BE UNPAINTED.

DESCRIPTION: END CROSSFRAME

JOB: VT. ROUTE 118 OVER TROUT RIVER
TOWN OF BERKSHIRE, VT
FRANKLIN COUNTY

TENSOR 2475

PROJ NO. BRF-RS 0283(7)

CUSTOMER: A.L. ST. ONGE

		DATE
DRAWN BY	AB	07/29/04
CHKD BY		
PCP		08/02/04
APPROV BY		
SUPERVISOR	W. J. GATTI	
Q.A.		

JOB NO. 222 — DRG. NO. 7

REV. △

CASCO BAY STEEL STRUCTURES, INC.
75 SPRING HILL ROAD SACO, MAINE 04072
PHONE (207) 282-7360 FAX. (207) 282-1179

761 SS

PCP Tue Aug 3 10:56:56 CDT 2004 /usera/jobs/2475/7 : Rev0