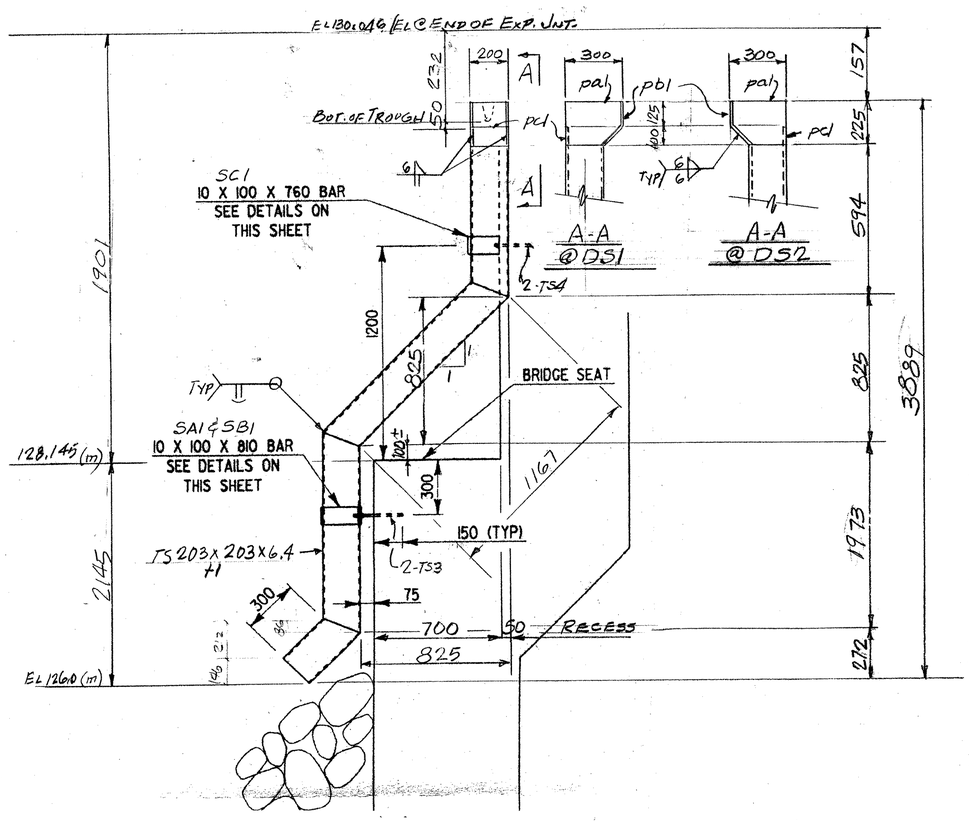

DS1- ONE REQ'D (@ NORTH END OF ABUT. NO. 2)
DS2- ONE REQ'D (@ SOUTH DO DO)

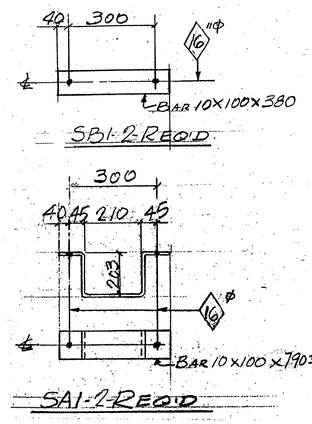

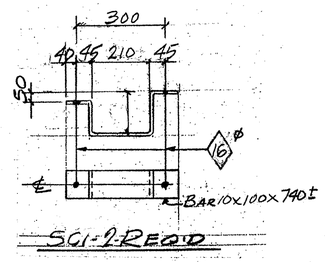

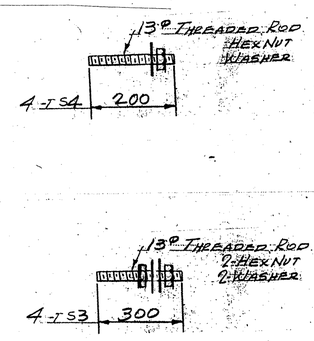

VTrans
RECEIVED
CK'D BY ____ CK'D BY ____
MAY 10 2005
RESUBMIT ____ APPROVED
BY DATE 5/12/2005

ABM INFO PAGE	LINE	NO.	DESCRIPTION	WT./PC.	ASSEM. MARK	SHIPPING MARK	REMARKS	WEIGHT
			SHOP BILL				JOB NO. 222	DRG. NO. M1
		1	DOWNSPOUT	4050		DS1		—
		1	DO	4050		DS2		—
		2	TS 203x203x6.4	4260± +1			A500-A501	
		4	ø 6.4x 225	294	pa1			
		2	ø6.4x 188	266	pb1		BEND	
		2	ø6.4x 100	188	pc1			
		2	BAR 10x100	760±		SA1	BEND.	
		2	DO	880		SB1		
		2	DO	840		SC1	BEND	
		4	13ø THREADED ROD	300				
		4	DO	200				
		12	13ø HEX NUTS					
		12	13ø WASHERS					

PAY ITEM 510.10

OUT FOR APPROVAL	3-8-05								
OUT FOR APPROVAL final	5-9-05								
ISSUED TO SHOP									
FIELD & OFFICE									

REV.	REMARKS	DATE	DWN	CHK	APP	Q.A.	NO.	DIA.	LGT	TYPE	WASHER

PROJECT NO. BRF-R5-0283(1) STATE PROJECT NO. 26

MATERIAL AASHTO M270 Gr 250 | ELECTRODES: PER PROC. | HOLES: AS NOTED | SHOP BOLTS: 13ø

SURFACE PREP. & PAINT:

GALV. AFTER FAB. (ASTM-A123)

DESCRIPTION: DOWNSPOUTS - ABUT. No. 2

JOB: VT. ROUTE 118 OVER TROUT RIVER BERKSHIRE, VT.

CUSTOMER: A. L. ST ONGE

	DRAWN BY	DATE
	J.P.F	3-05
	CHKD. BY	
	EJ	
	APPROV BY	
	Q.A.	

CASCO BAY STEEL STRUCTURES, INC.
75 SPRING HILL ROAD SACO, MAINE 04072
PHONE (207) 282-7360 FAX. (207) 282-1179

JOB NO. 222 | DRG. NO. M1 | REV. 1 | 163