LEGEND

Seed & Mulch

Erosion Control Matting

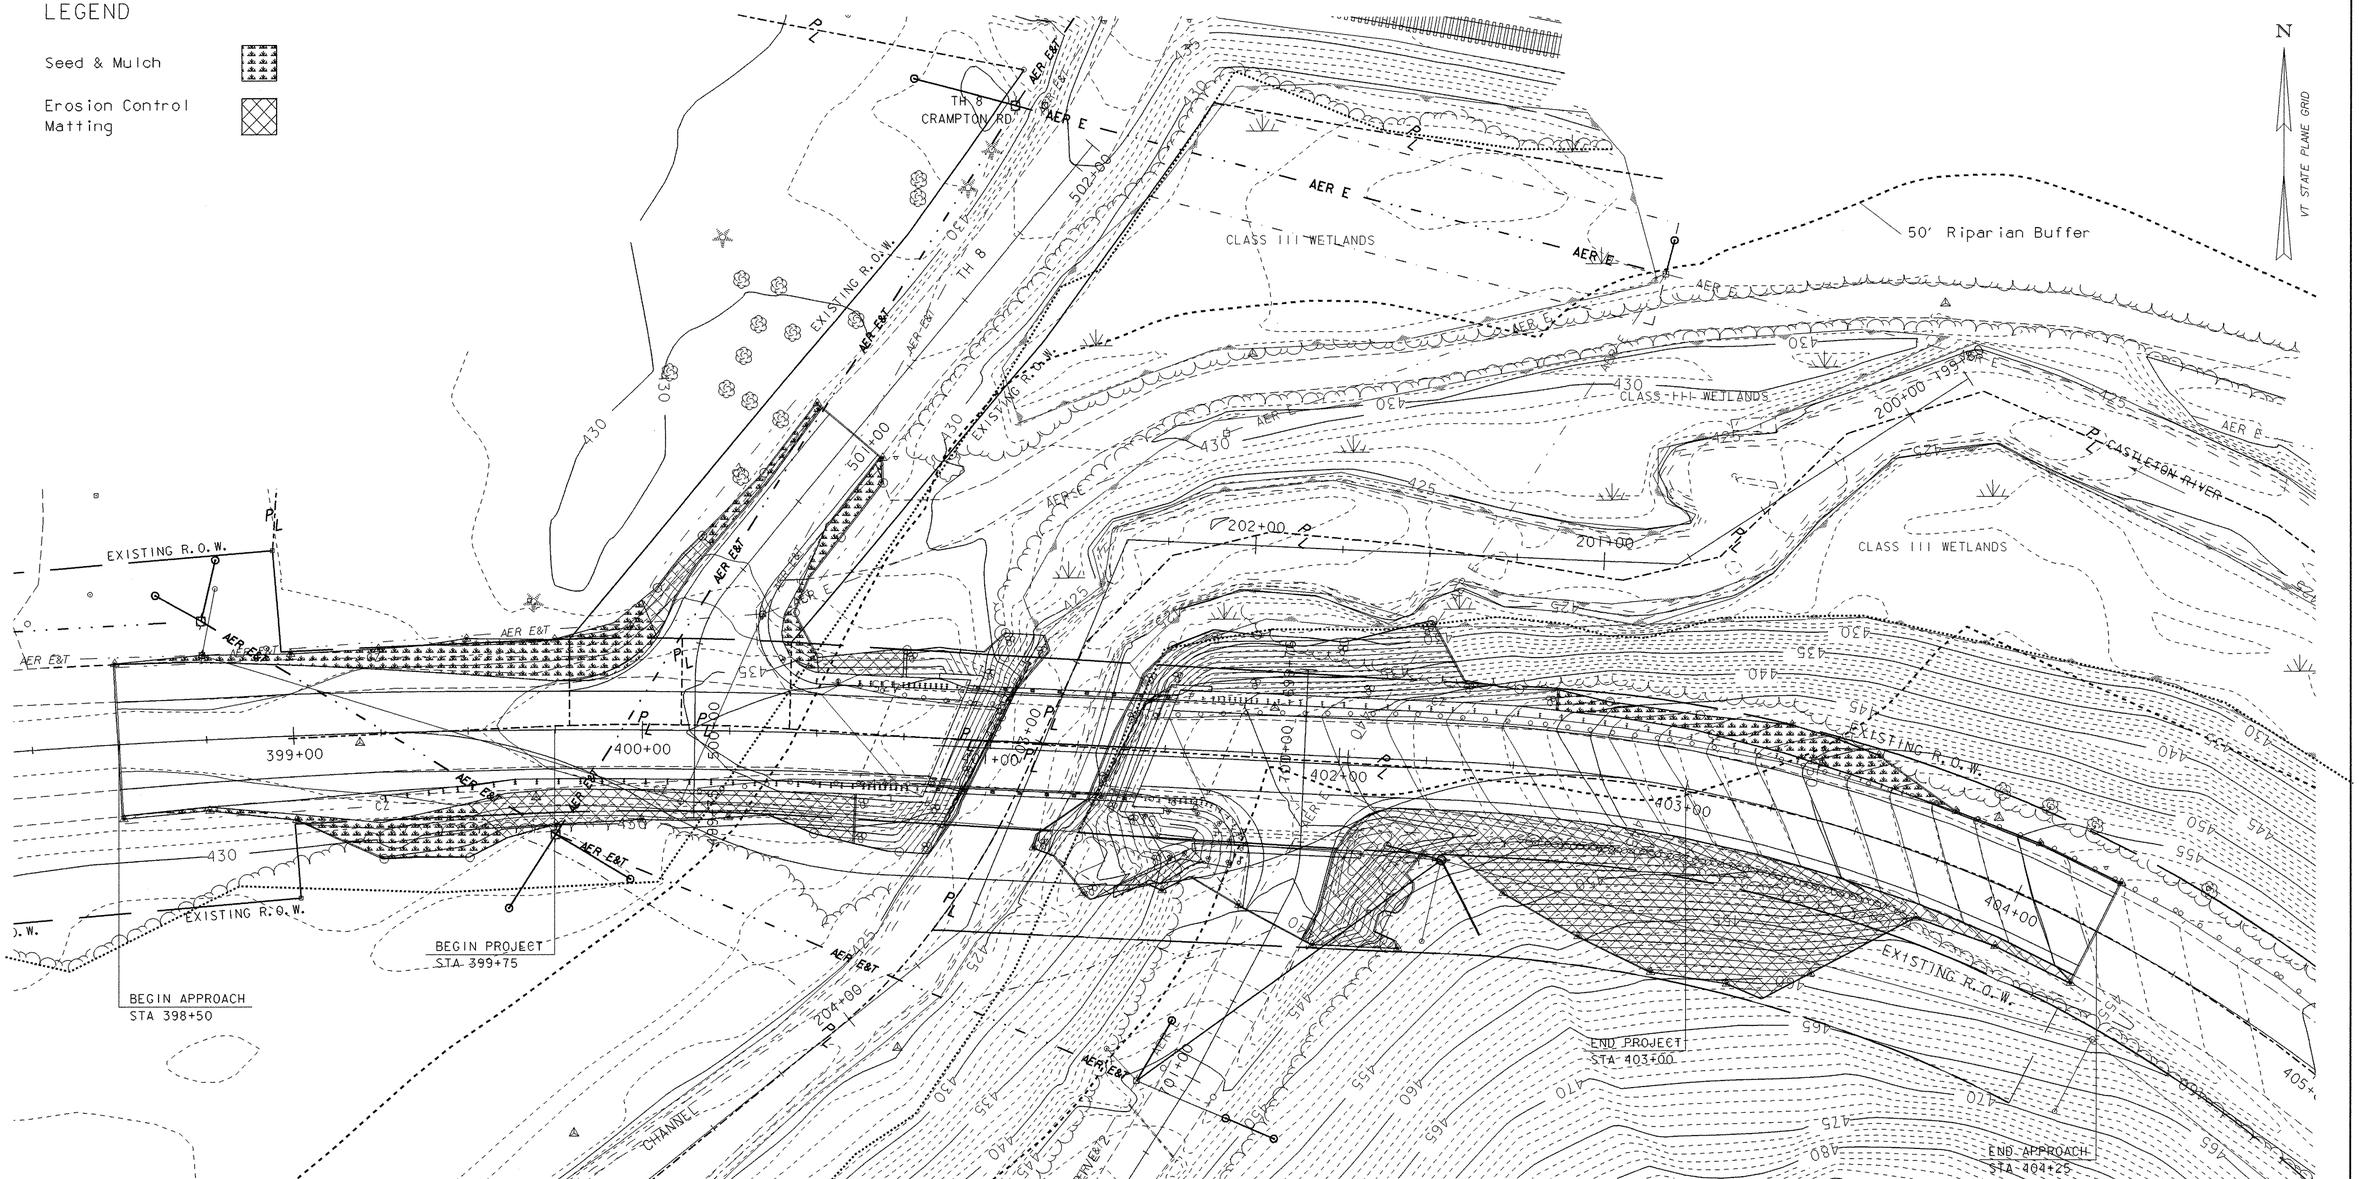

LEGEND

50' Riparian Buffer

Soil Line

Wetland Limit

R.O.W.

Property Line

PLAN

0 20 40

SCALE IN FEET

EROSION FINAL SITE PLAN

PROJECT NAME: CASTLETON	
PROJECT NUMBER: RS 0142(10)	
FILE NAME: sf193e04.1	PLOT DATE: 09-FEB-2007
PROJECT LEADER: R. WHITCOMB	DRAWN BY: T. LACKEY
DESIGNED BY: T. LACKEY	CHECKED BY: W. LAMMER
78f193/structures/sf193ero.dgn	SHEET 27 OF 68