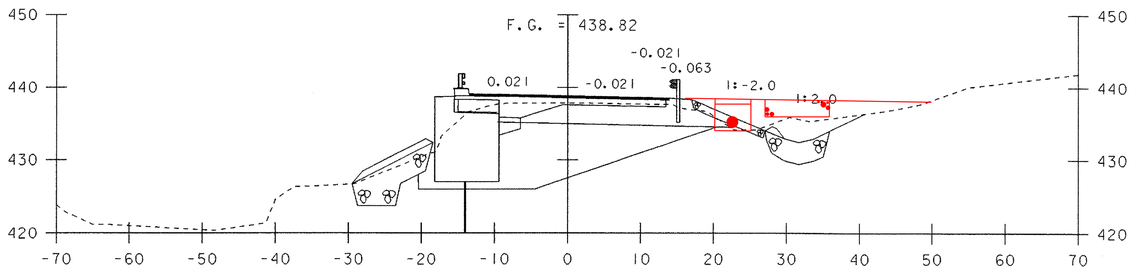

401+51

401+50

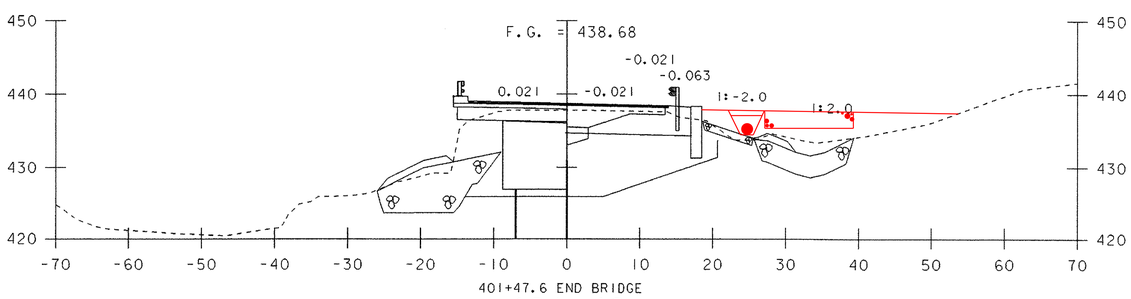

401+48

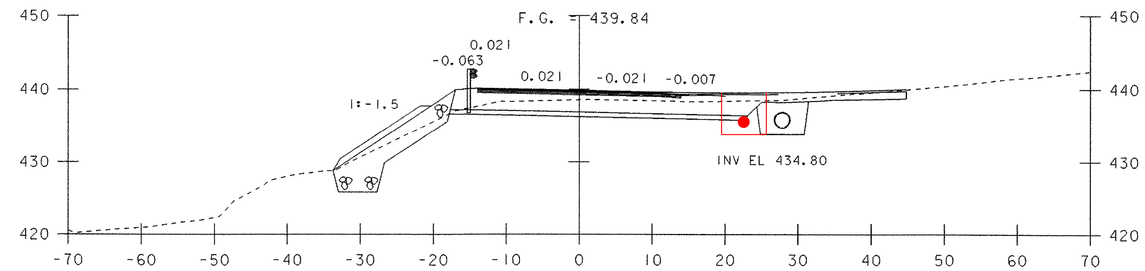

401+75

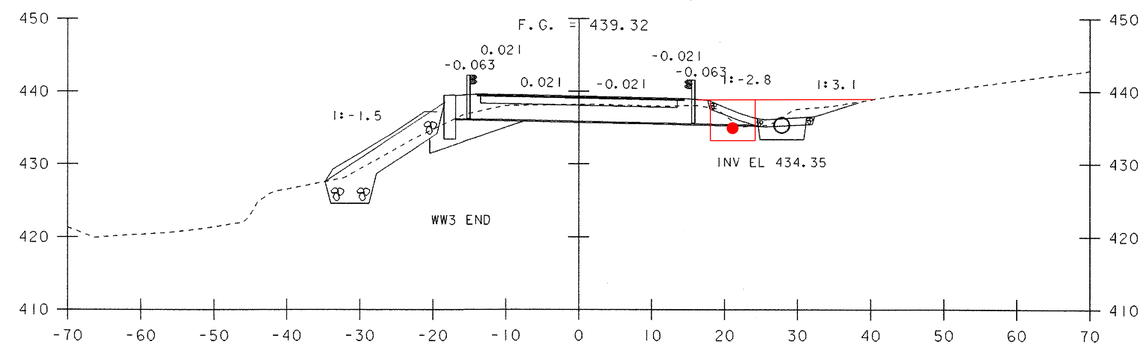

401+63

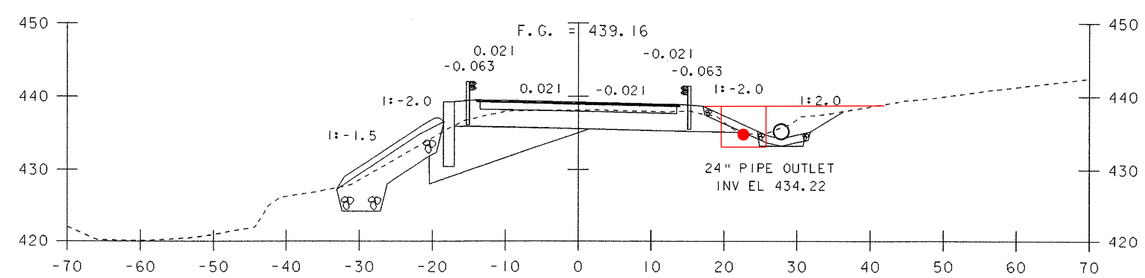

401+59

SCALE 1" = 10'-0

MAINLINE SECTIONS 4

PROJECT NAME: CASTLETON	
PROJECT NUMBER: RS 0142(10)	
FILE NAME: sf193m04.i	PLOT DATE: 09-FEB-2007
PROJECT LEADER: R. WHITCOMB	DRAWN BY: T. LACKEY
DESIGNED BY: T. LACKEY	CHECKED BY: W. LAMMER
78f193/structures/sf193xsl.dgn	SHEET 58 OF 68