

TH5 SURV. CURVE DATA
 $\Delta = 49^\circ 03' 20''$ LT
 $D = 28' 00''$
 $R = 204.65$
 $T = 93.38$
 $L = 175.20$
 $E = 20.30$


TH 5 REV. CURVE DATA
 $\Delta = 57^\circ 59' 23''$
 $D = 36^\circ 00' 00''$
 $R = 159.1550$
 $T = 88.20$
 $L = 161.08$
 $E = 22.81$
 BANK = 0.021 FT/FT

CONSTRUCT DRIVE
 REV 51+98 RT (PAVED)
 REV 52+92 LT (GRAVEL)

GEOTEXTILE FOR SILT FENCE
 REV 51+74 RT - REV 51+88 RT

VERTICAL GRANITE CURB
 REV 52+00 LT - REV 52+60 LT
 53+03 - 52+62.5 LT

SEE PREVIOUS LAYOUT SHEET FOR PIPE NOTE

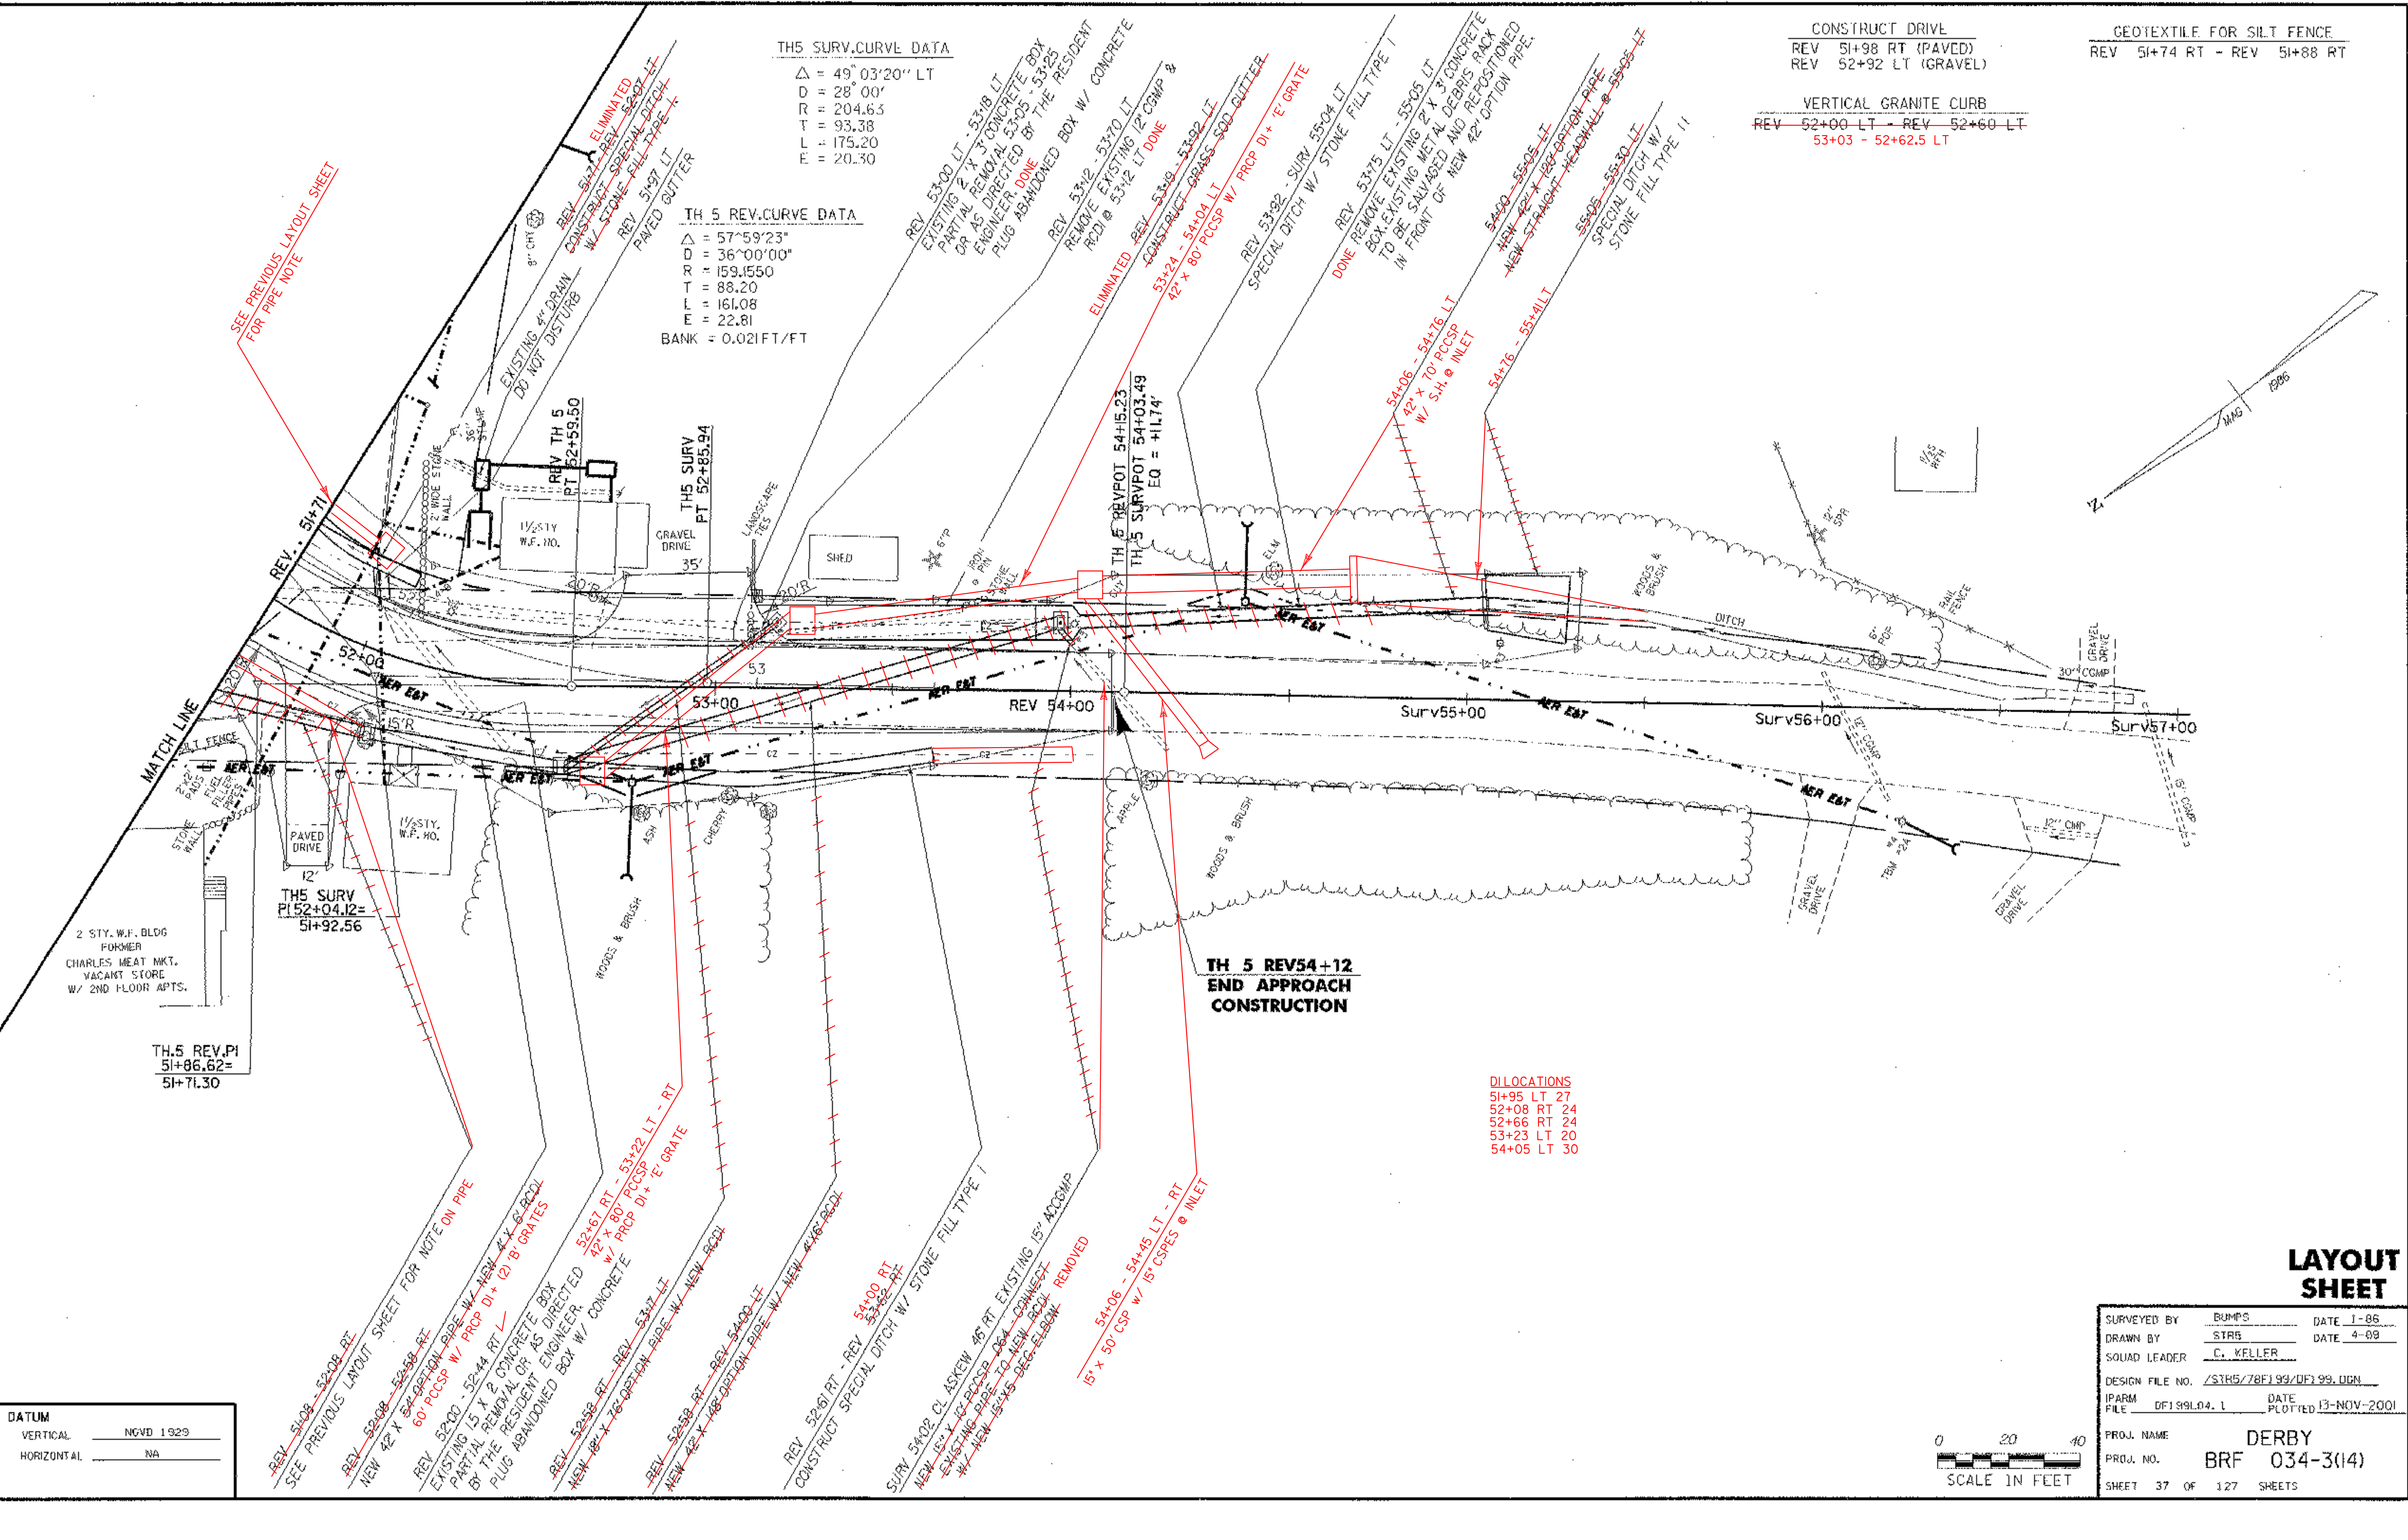

- DILLOCATIONS**
 51+95 LT 27
 52+08 RT 24
 52+66 RT 24
 53+23 LT 20
 54+05 LT 30

DATUM
 VERTICAL NGVD 1929
 HORIZONTAL NA



LAYOUT SHEET

SURVEYED BY	BUMPS	DATE	1-86
DRAWN BY	STRB	DATE	4-89
SQUAD LEADER	C. KELLER		
DESIGN FILE NO.	/STR5/78F199/DF199.DGN		
IPARM FILE	DF199L04.L	DATE PLOTTED	13-NOV-2001
PROJ. NAME	DERBY		
PROJ. NO.	BRF 034-3(14)		
SHEET	37	OF	127 SHEETS