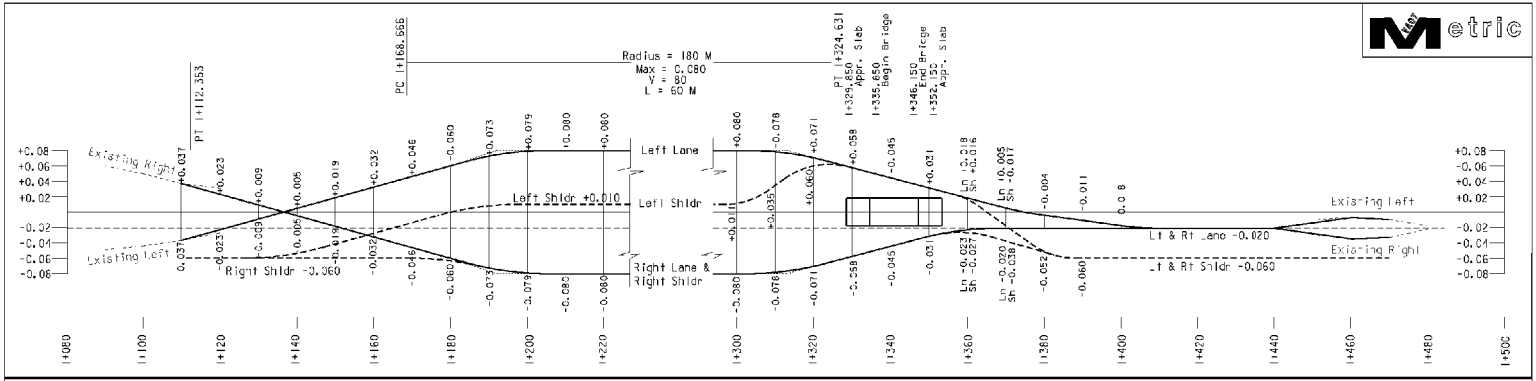


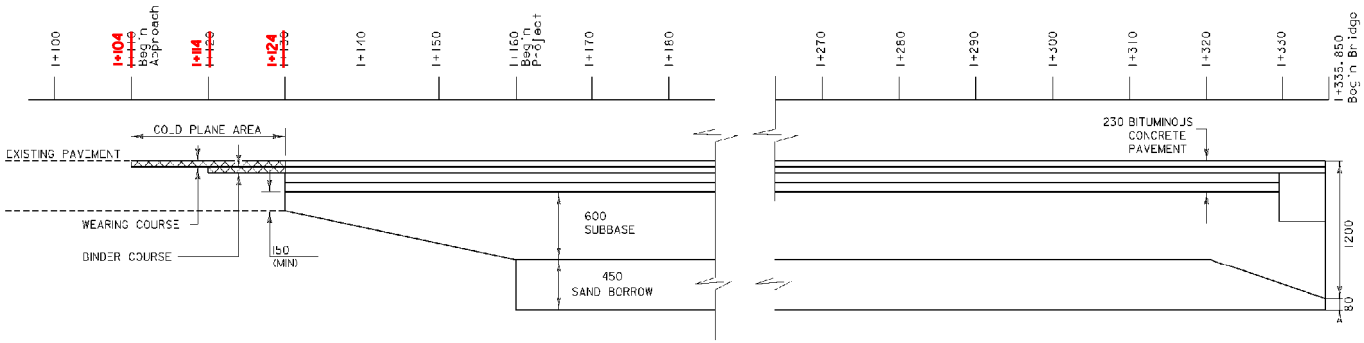


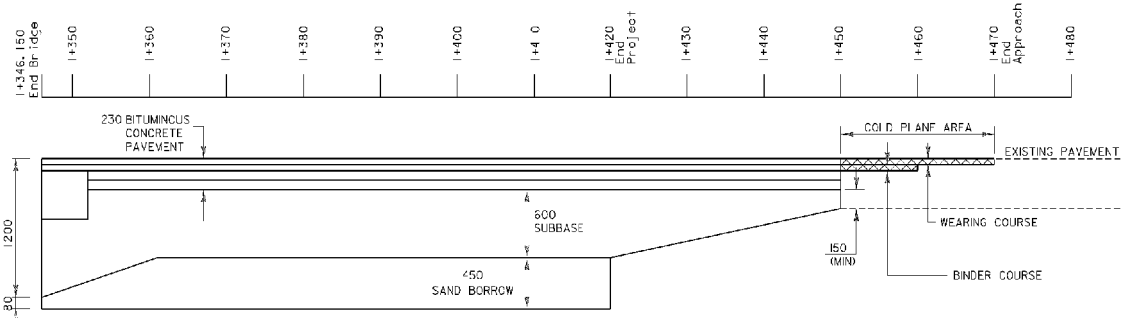


NOT TO SCALE

**SUPERELEVATION DIAGRAM & MATERIAL TRANSITION DIAGRAM**

| | |
|---|---|
| PROJECT NAME: EAST MONTPELIER | |
| PROJECT NUMBER: STP 037-2(9) | |
| FILE NAME: 78F200\s-r\sf200xsld.dgn | PLOT DATE: 14-JUL-2009 |
| PROJECT LEADER: K. HIGGINS | DRAWN BY: K. PELLETT |
| DESIGNED BY: J. LACROIX | CHECKED BY: J. LACROIX |
| sf200sed.l | SHEET 16 OF 67 |