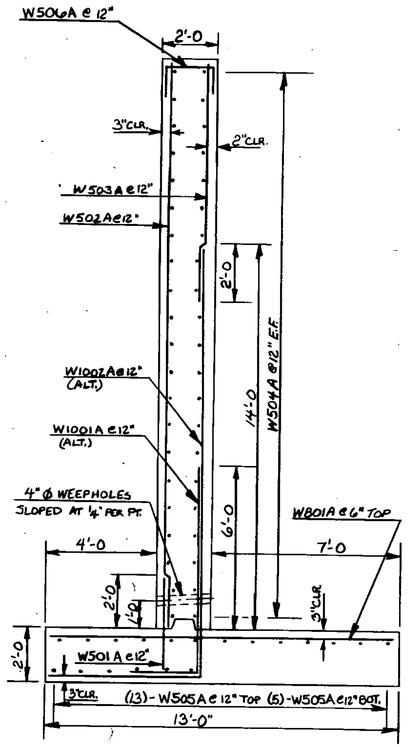

WINGWALL SECTION "A"
SCALE: 3/8" = 1'-0

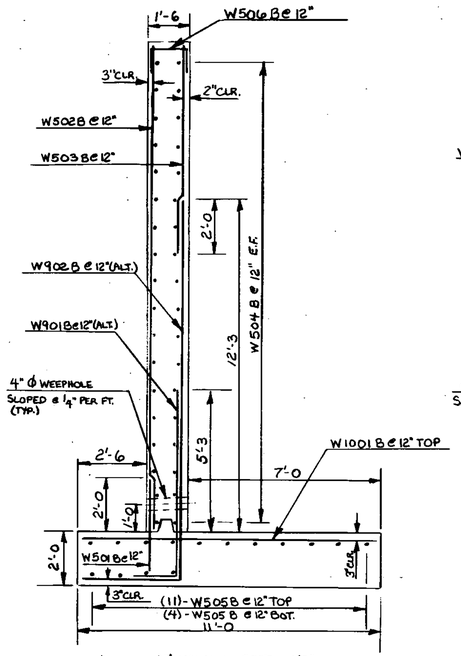

WINGWALL SECTION "B"
SCALE: 3/8" = 1'-0

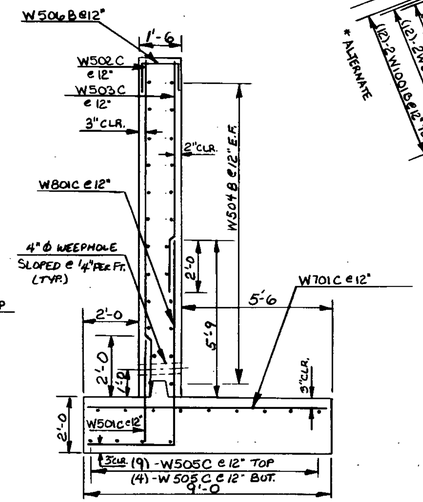

WINGWALL SECTION "C"
SCALE: 3/8" = 1'-0

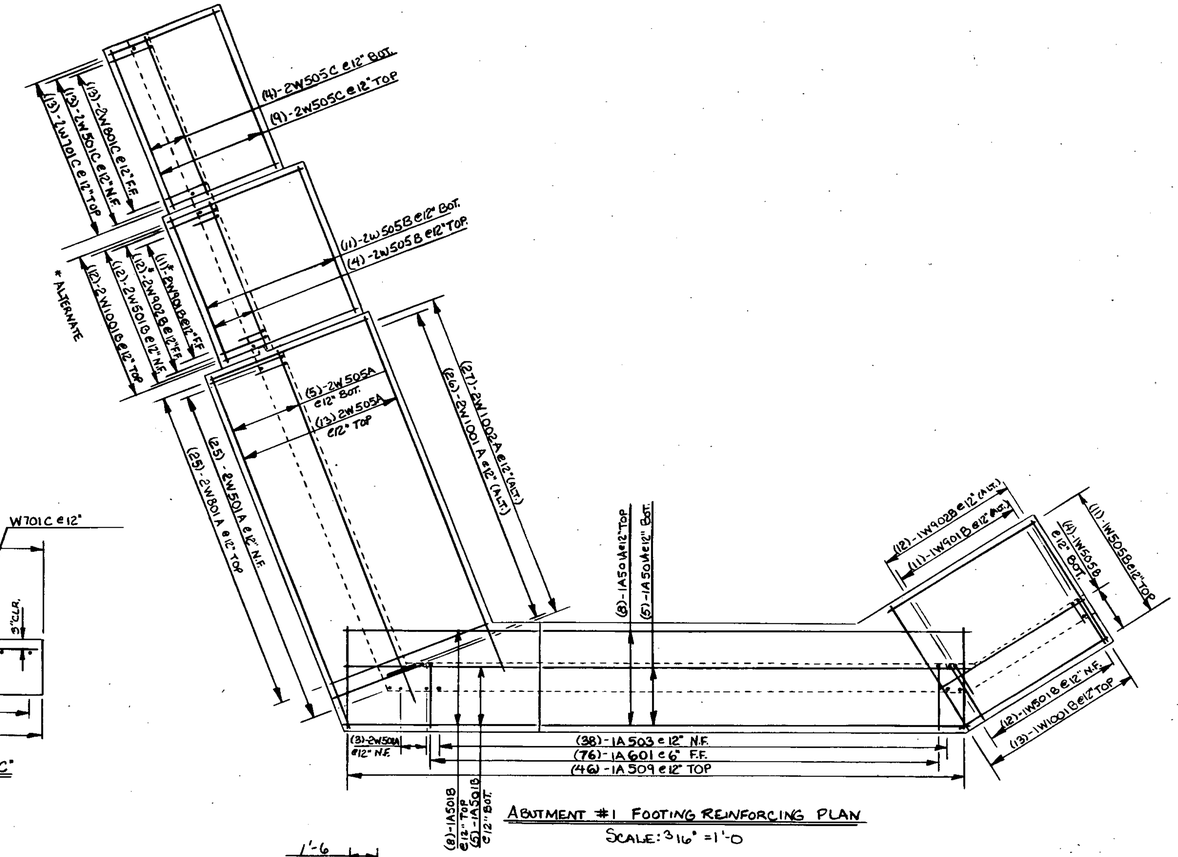

ABUTMENT #1 FOOTING REINFORCING PLAN
SCALE: 3/16" = 1'-0

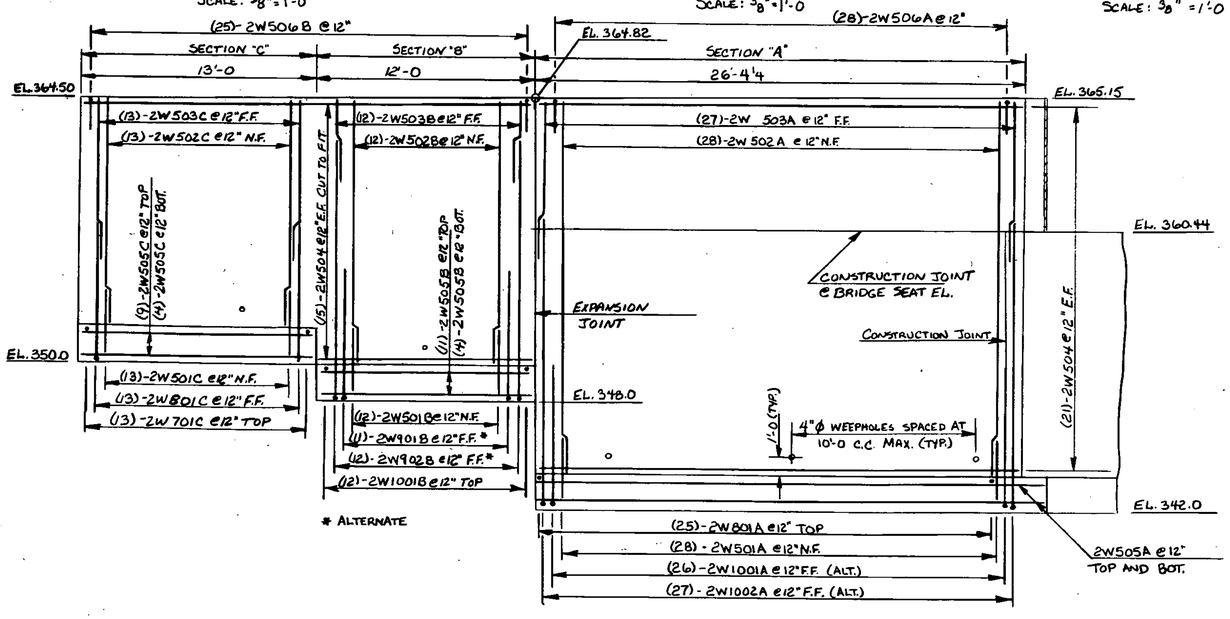

* ALTERNATE

ELEVATION - WINGWALL #2
SCALE: 1/4" = 1'-0

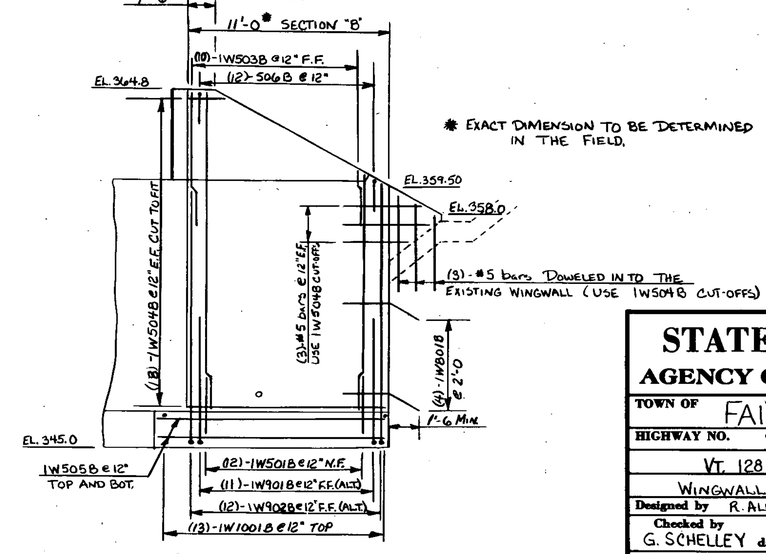

* EXACT DIMENSION TO BE DETERMINED IN THE FIELD.

ELEVATION - WINGWALL #1
SCALE: 1/4" = 1'-0

STATE OF VERMONT
AGENCY OF TRANSPORTATION

TOWN OF FAIRFAX	Bridge No. 8
	Log Sta. 9+56
HIGHWAY NO. VT. 128	Surv. Sta. 24+21
VT. 128 OVER BROWNS RIVER	
WINGWALLS #1 & #2, FOOTING REINFORCEMENT	
Designed by R. ALDRICH	Drawn by M. EVANS
Checked by G. SCHELLEY date 10/83	Bridge Design Supervisor E.L. Ooffey date 1-84
PROJECT FAIRFAX	PROJECT NO. BRS 0229(2) S
Bridge Sheet No. BR809	Sheet 30 of 98

BRUNING 44-131 50384

BB-6-'83