24+73 Lt ~ 25+40 Lt
Removal & Disposal of
Existing Guard Rail

24+69 Lt ~ 25+33 Lt
Removal and Disposal of
Existing Guard Rail

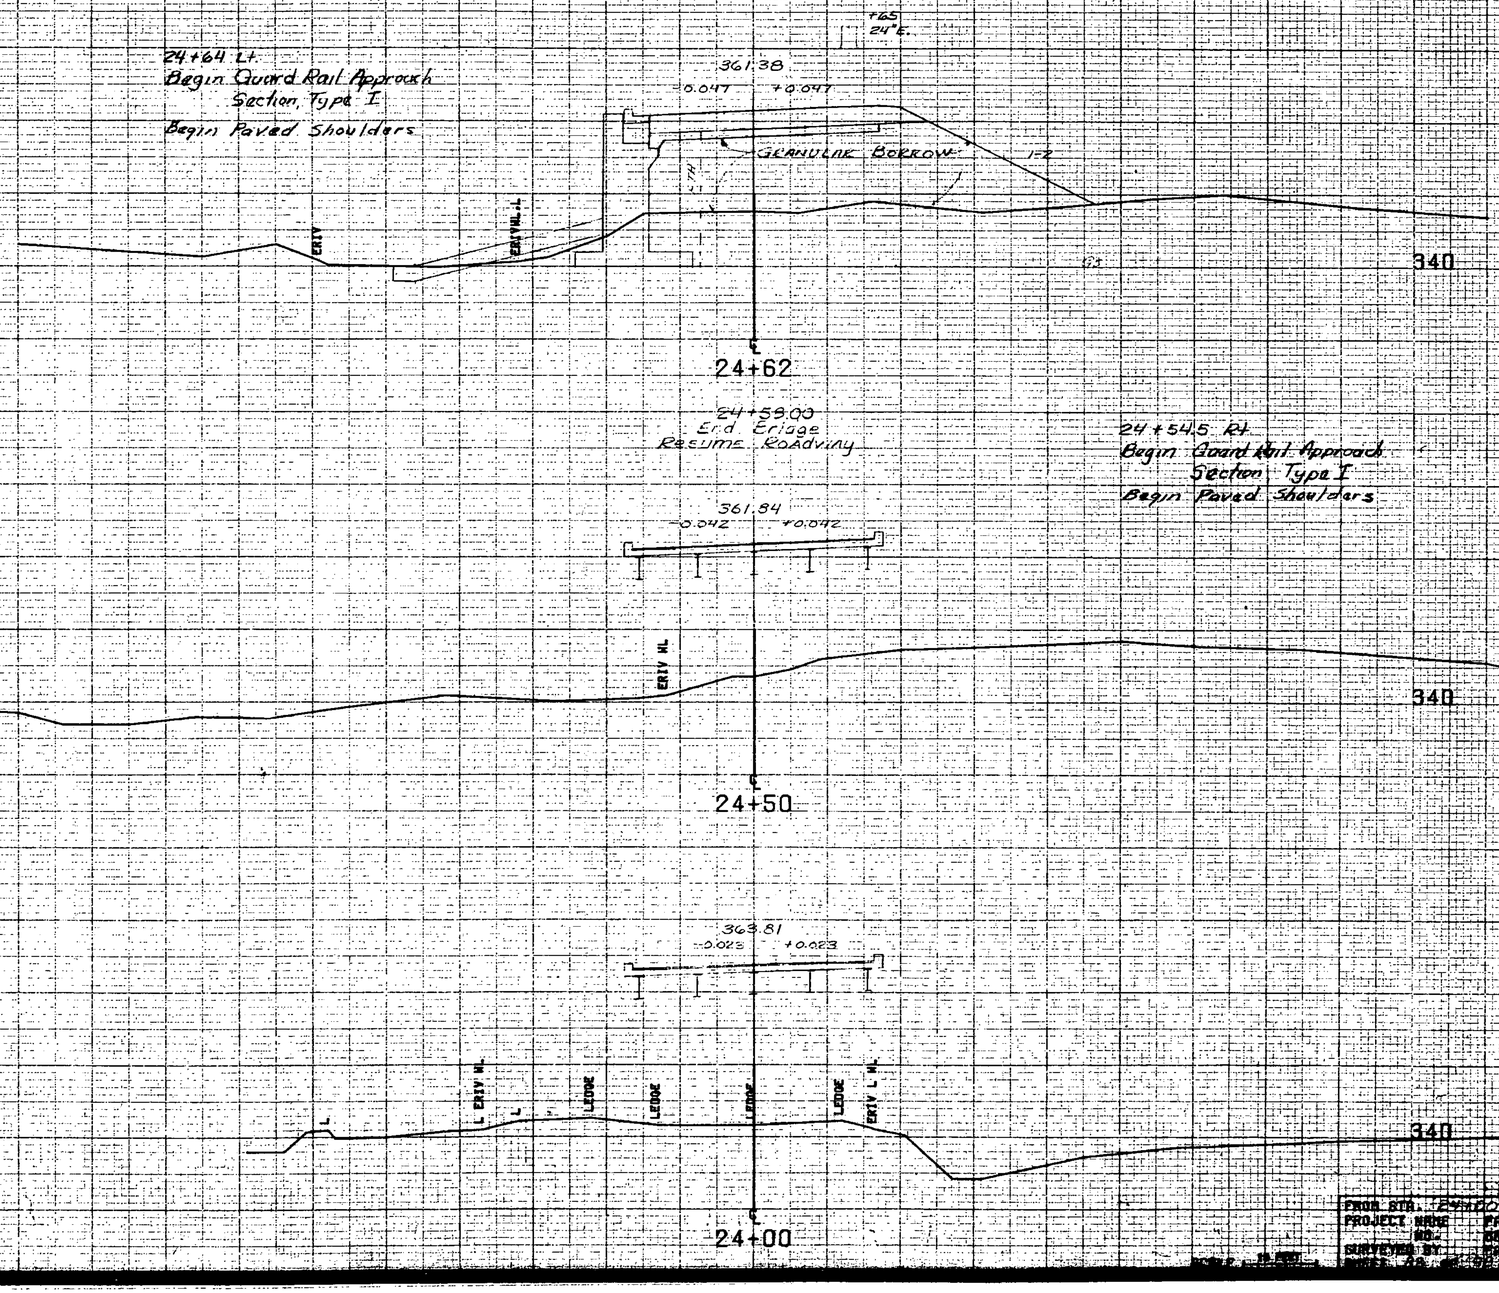

FROM STA. 24+00 TO STA. 24+62
PROJECT NAME FAIRFAX MAIN
NO. BRO0229(21)
SURVEYED BY PHL PLOTTED 04/