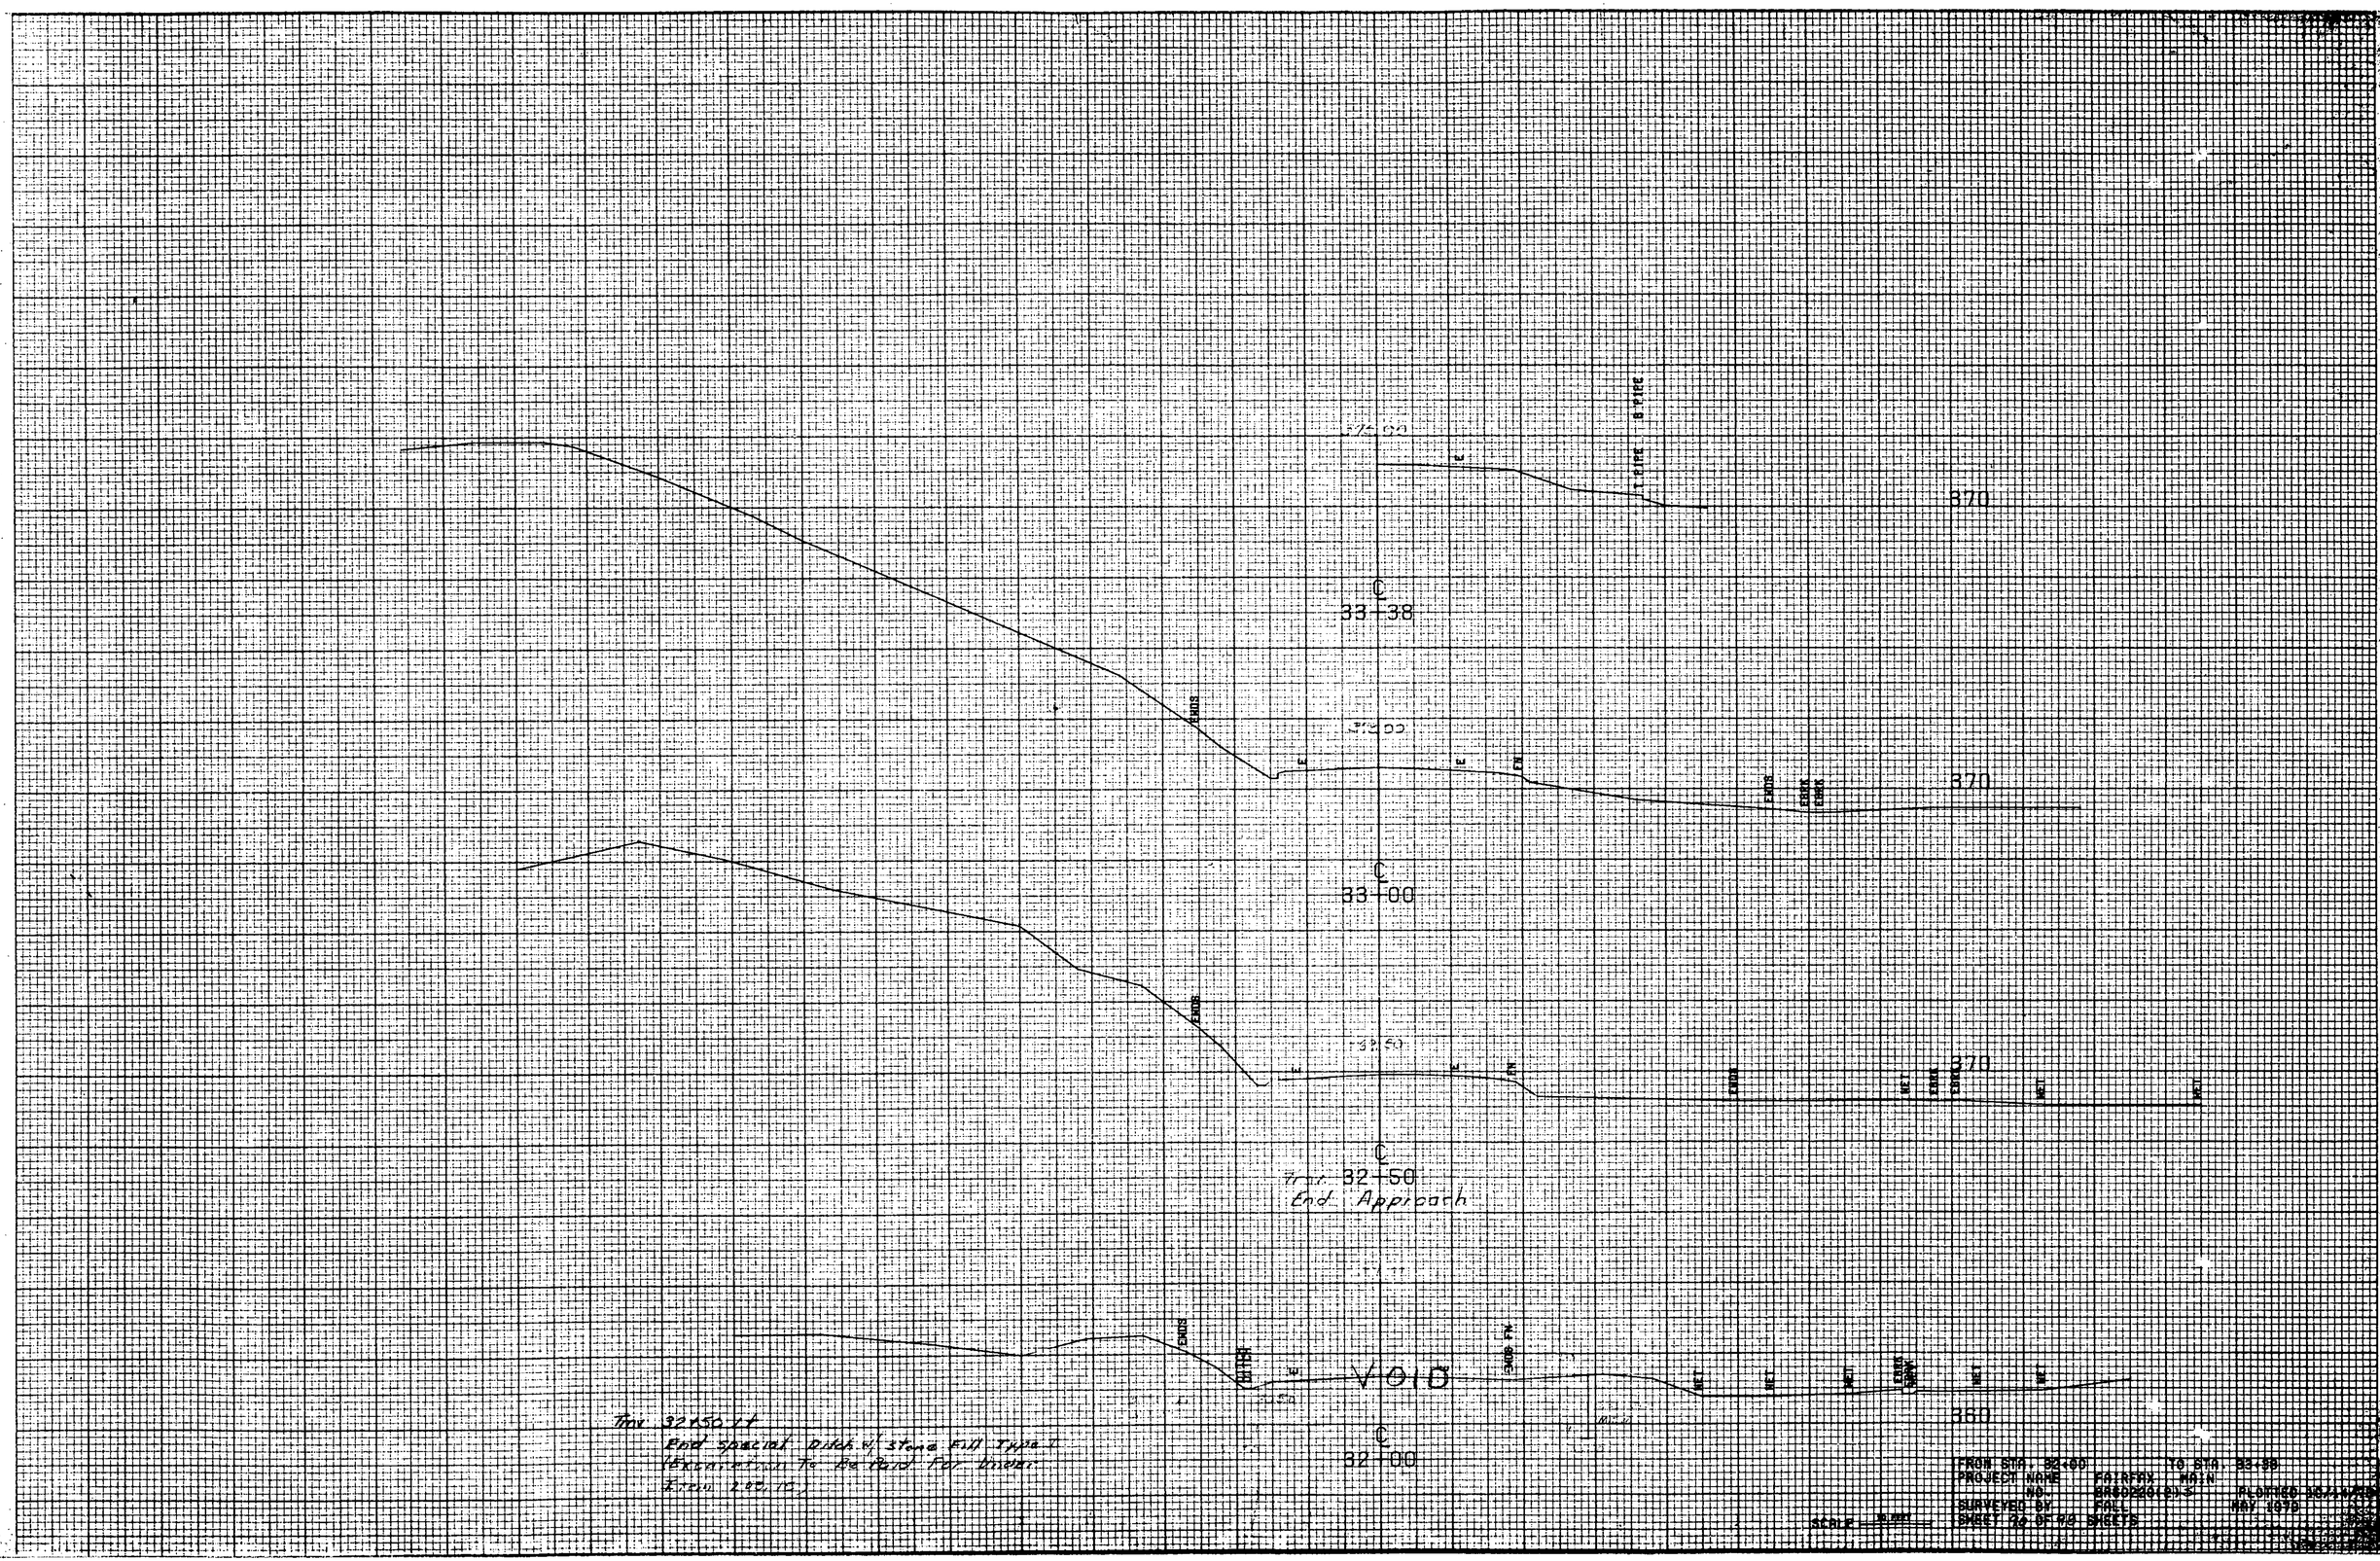
370
33+38
370
33+00
370
32+50
End Approach
360
32+00
FROM STA. 32+00
TO STA. 33+99
PROJECT NAME
FAIRFAX MAIN
NO.
SURVEYED BY
MAY 1978
SHEET 26 OF 80 SHEETS
SCALE