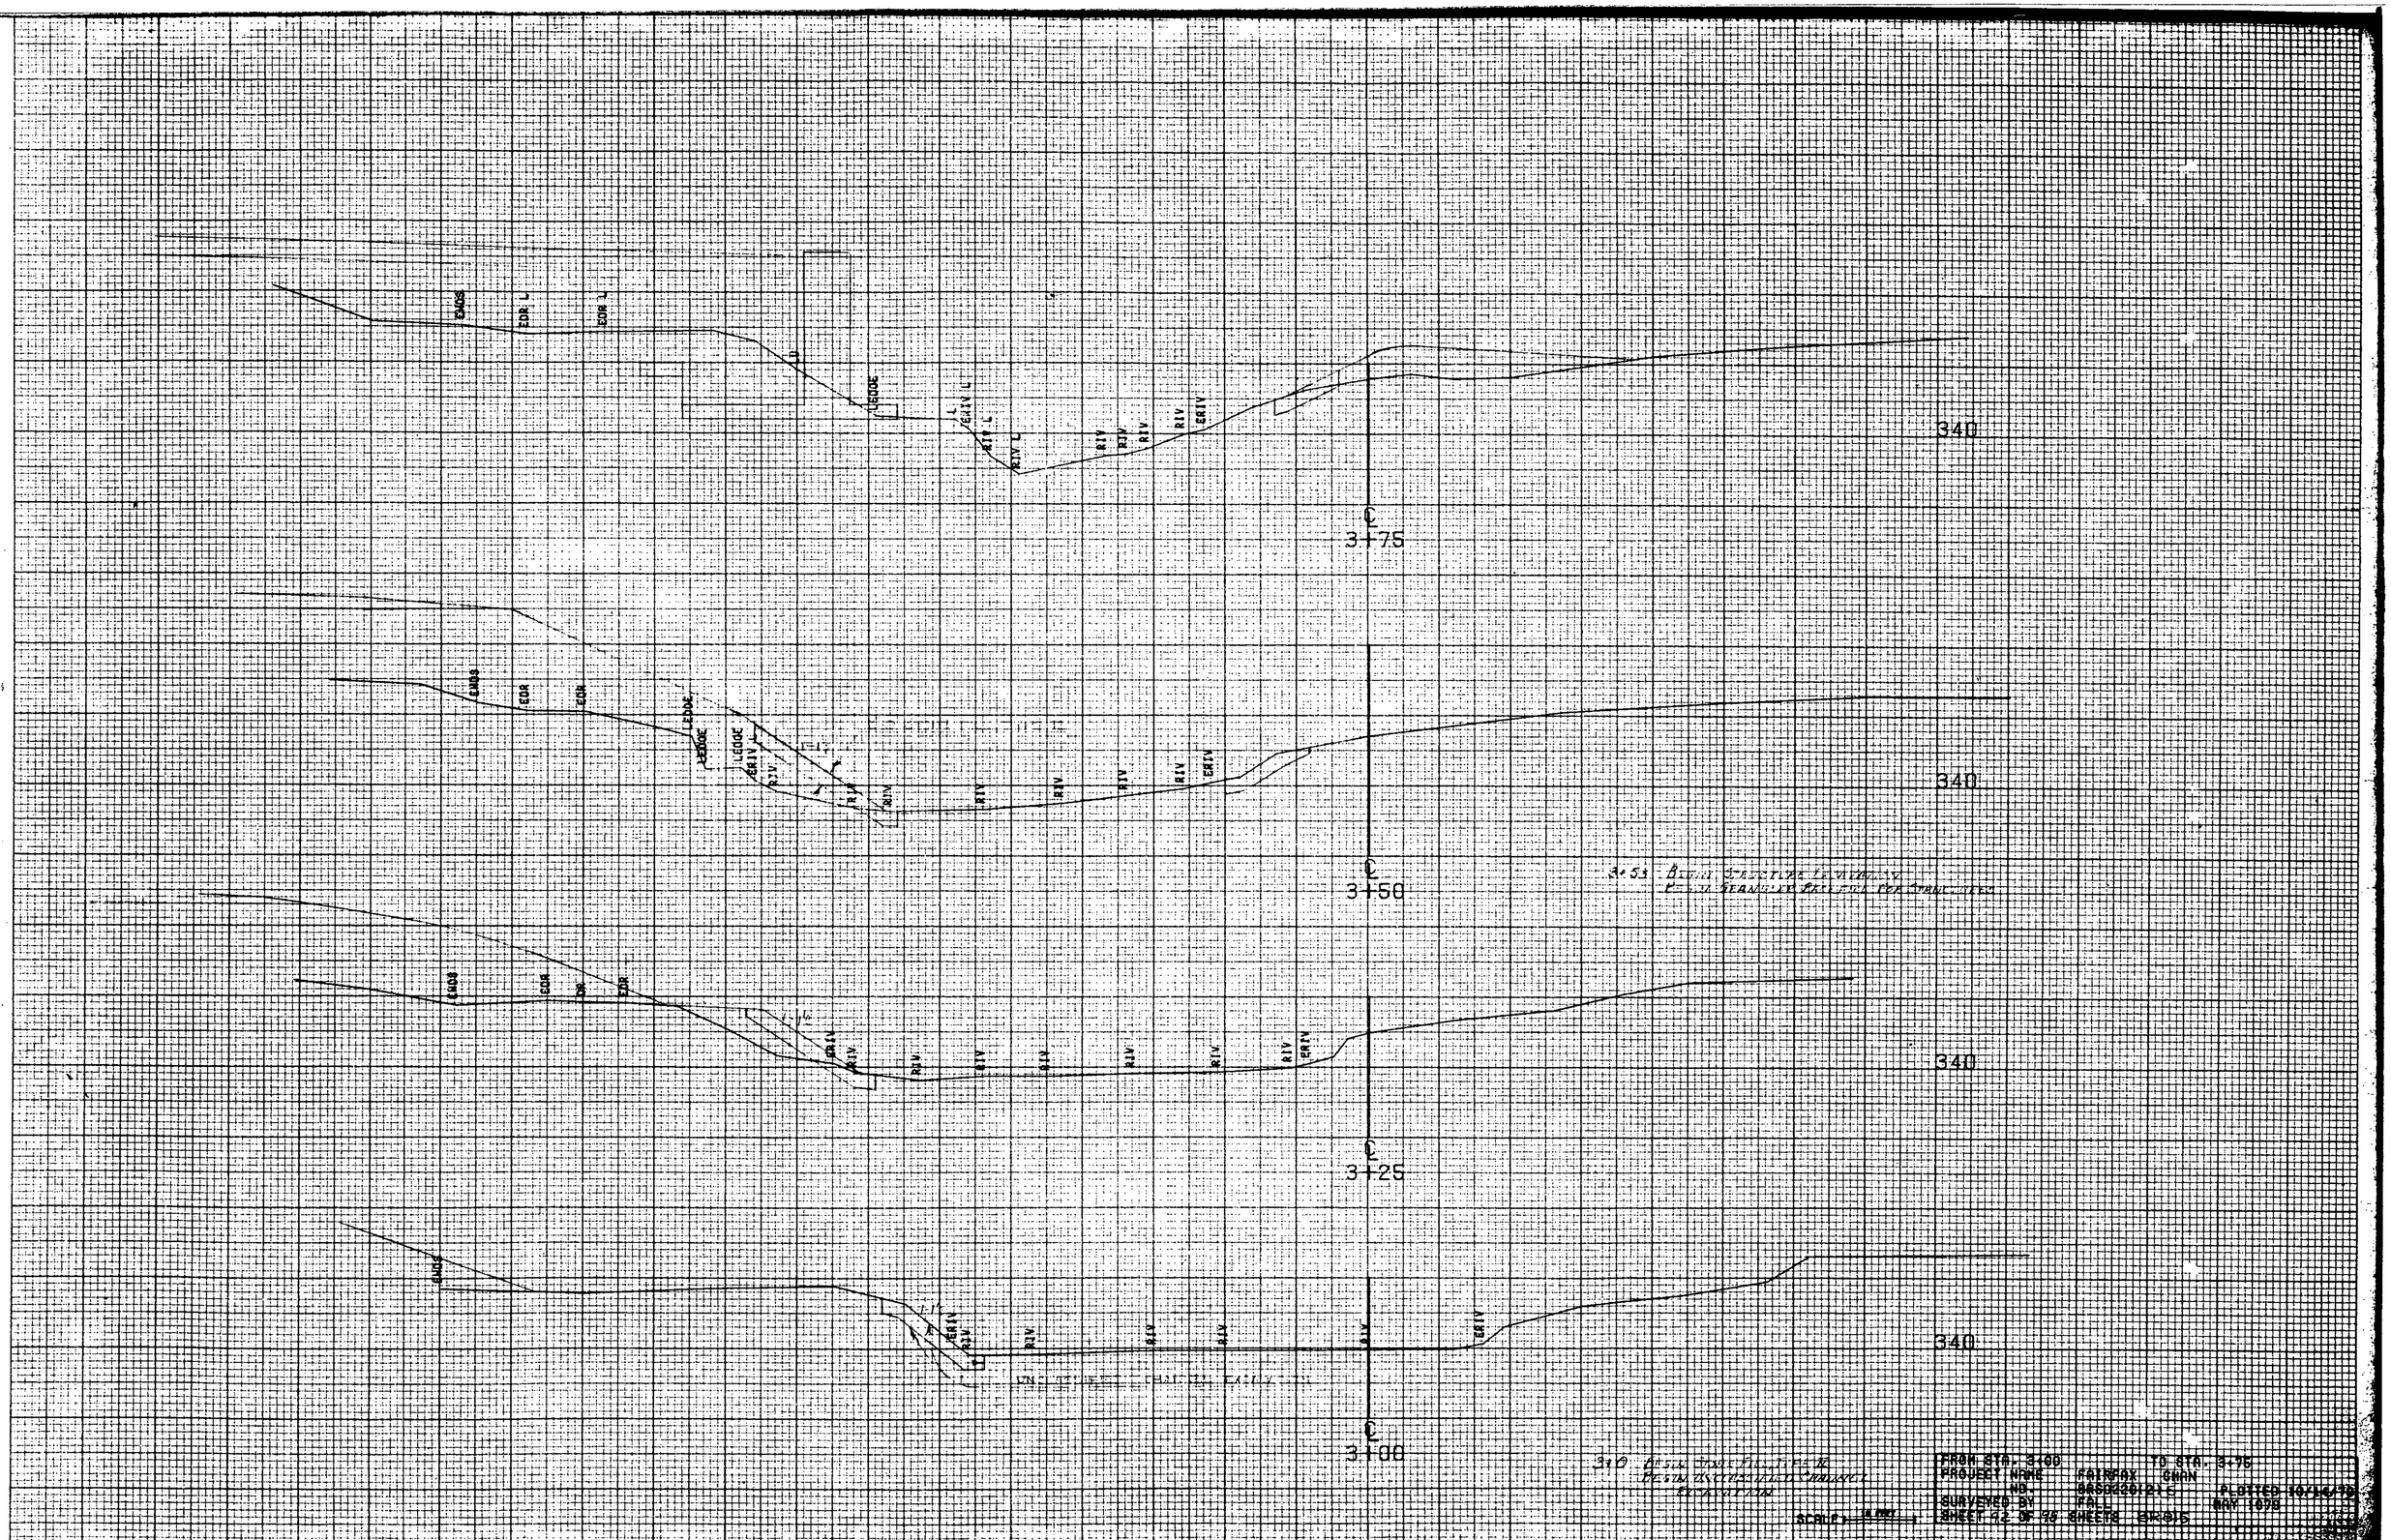
EADS
EDR L
EDR L
LEDDC
ERIV L
RIV L
RIV
RIV
RIV
RIV
ERIV
340
3+75
EADS
EDR
EDR
LEDDC
LEDDC
LEDDC
ERIV
RIV
RIV
RIV
RIV
RIV
ERIV
340
3+50
EADS
EDR
DR
EDR
ERIV
RIV
RIV
RIV
RIV
RIV
RIV
ERIV
340
3+25
EADS
ERIV
RIV
RIV
RIV
RIV
ERIV
340
3+00
FROM STA. 3+00
TO STA. 3+75
PROJECT NAME
FAIRFAX
GRNN
NO.
0850220121E
PLOTTED 10/16/78
SURVEYED BY
PLOT
NOV 1978
SHEET 22 OF 98 SHEETS
SCALE