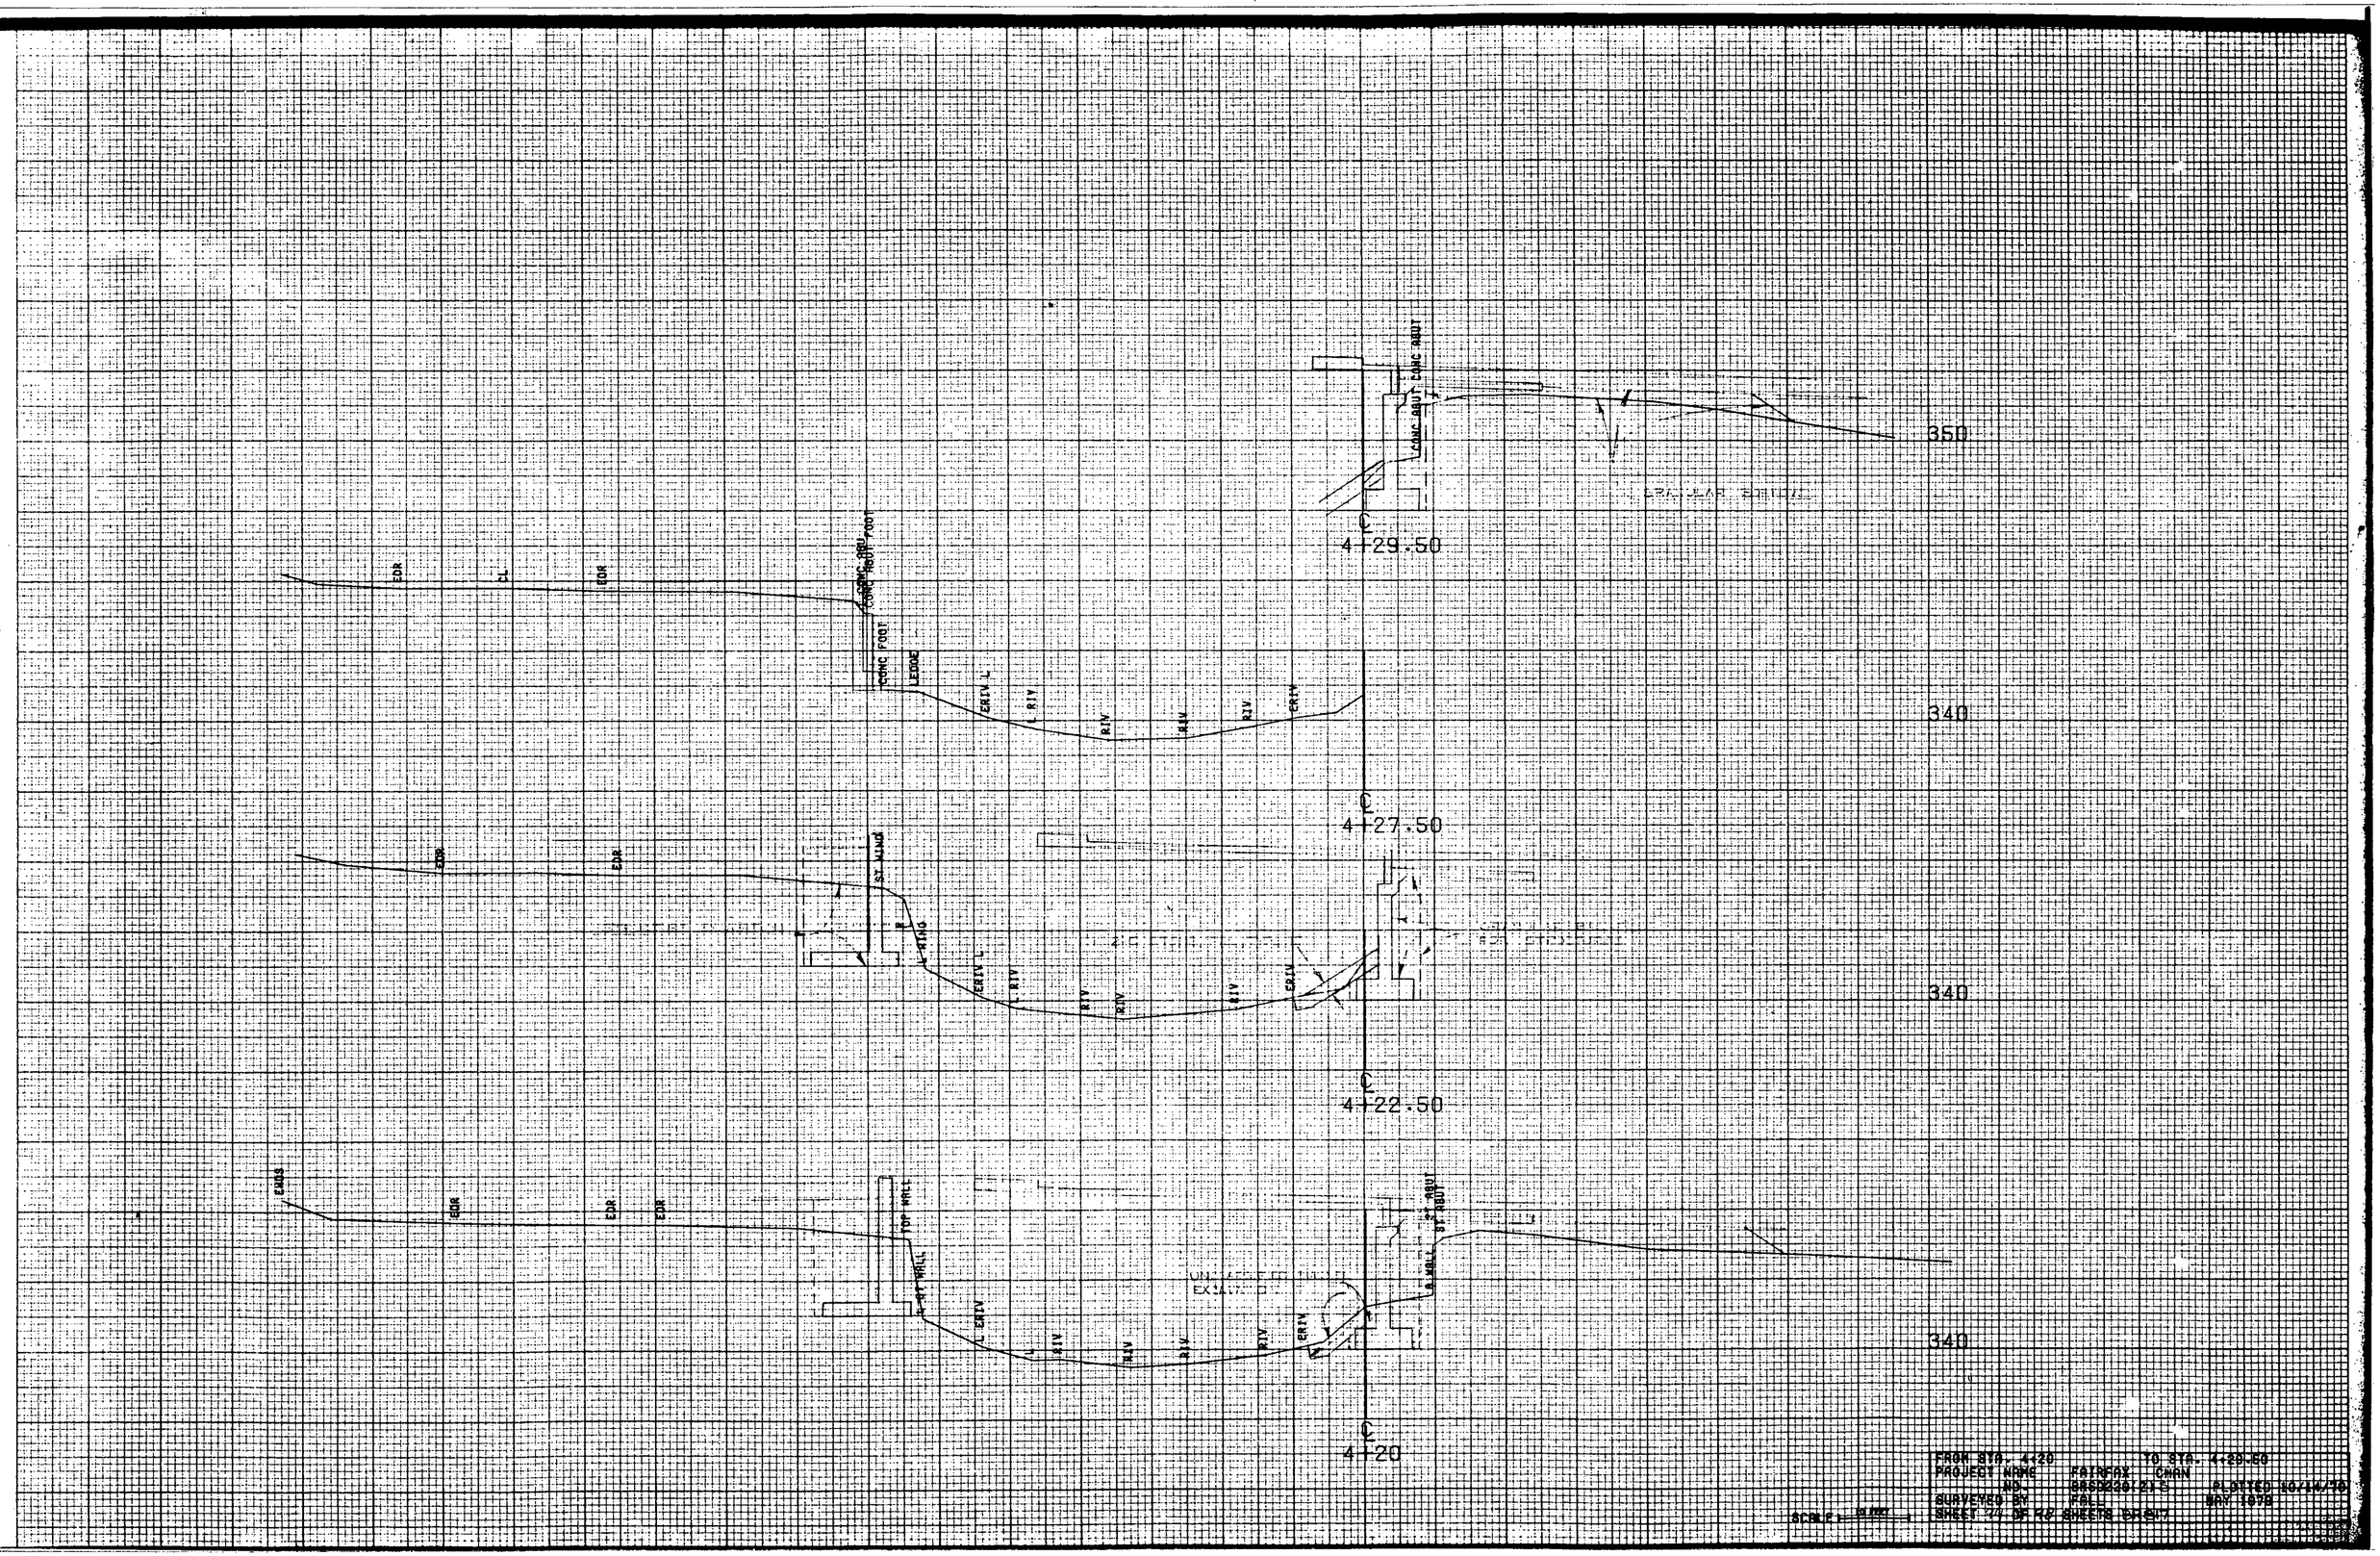
EDR
CL
EDR
CONC ABUT
CONC ABUT FOOT
CONC FOOT
LEDGE
ERIV L
RIV
RIV
RIV
RIV
ERIV
4+29.50
CONC ABUT
CONC ABUT
350
340
EDR
EDR
ST WING
WING
ERIV L
RIV
RIV
RIV
RIV
ERIV
4+27.50
340
4+22.50
EDRS
EDR
EDR
EDR
TOP WALL
WALL
ERIV
RIV
RIV
RIV
RIV
ERIV
ST ABUT
ST ABUT
WALL
340
4+20
FROM STA. 4+20 TO STA. 4+29.50
PROJECT NAME FAIRFAX CHAN
NO. BRSC2230(21)
PLOTTED 10/14/78
SURVEYED BY FBL MAY 1978
SHEET 22 OF 22 SHEETS SHEET
SCALE 1" = 10'