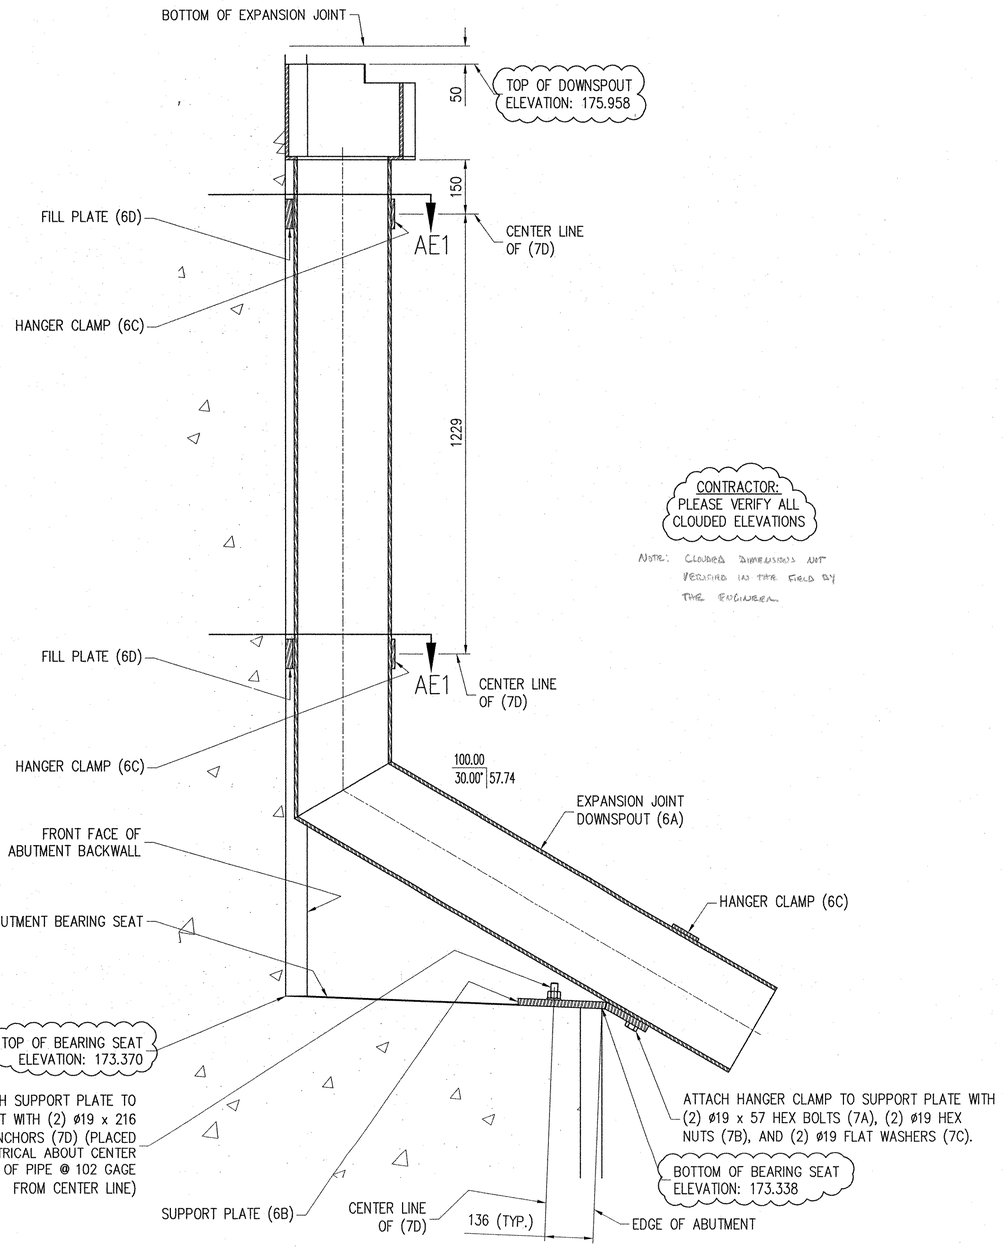

SECTION THROUGH ABUTMENT NO. 2 @ CENTER LINE OF EXPANSION JOINT DOWNSPOUT

(LOOKING SOUTH – 15° SOUTH FROM PERPENDICULAR TO ABUTMENT)
(EXPANSION JOINT, BRIDGE DECK, BRIDGE SUPERSTRUCTURE, BEARINGS NOT SHOWN FOR CLARITY)

CONTRACTOR:
PLEASE VERIFY ALL
CLOUDED ELEVATIONS

NOTE: CLOUDED DIMENSIONS NOT VERIFIED IN THE FIELD BY THE ENGINEER.

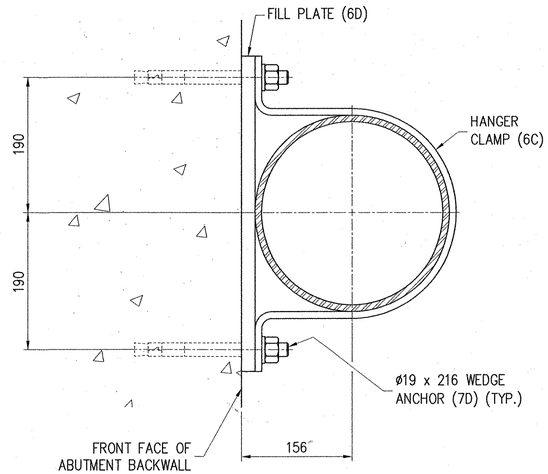

SECTION AE1
(ROTATED)
(SCALE: 2X)

RECEIVED
CK'D BY JL OK'D BY
JUN 26 2006
RESUBMIT APPROVED
BY DATE 7/7/06

STRUCTURES COPY

VTrans - PDD
JUN 26 2006
Structures Design Section

WORK THIS SHEET WITH SHEET NO. 6 AND 7.

REV.	DESCRIPTION	DATE	DET.	CKD.

D.S. BROWN
300 E. CHERRY STREET
NORTH BALTIMORE, OHIO 45872
419.257.3561
FAX: 419.257.0332
4201 NOREX DRIVE
CHASKA, MINNESOTA 55318
952.368.3000
FAX: 952.448.7000
DSBROWN.COM

	ITEM	QUANTITY
LOCATION — U.S. ROUTE 5 OVER LULLS BROOK	–	–
BRIDGE — NO. 60	–	–
PROJECT — BRS 0113 (22)	–	–
TOWN — HARTLAND	–	–
P.O. NO. — 2004	–	–
DESIGNER — McFARLAND–JOHNSON, INC.	–	–
CUSTOMER — MILLER CONSTRUCTION, INC.	–	–
	–	–

DESCRIPTION: EXPANSION JOINT DRAINAGE ERECTION DETAILS
WINDSOR COUNTY, VT

SCALE:	DRAWN BY:	CHECKED BY:	DATE:	
N.T.S.	JMB	JEB	5/30/06	–
PROJECT NUMBER		PRODUCT CODE	RELEASE	SHEET
14032		1042	2	E1

1415CWP