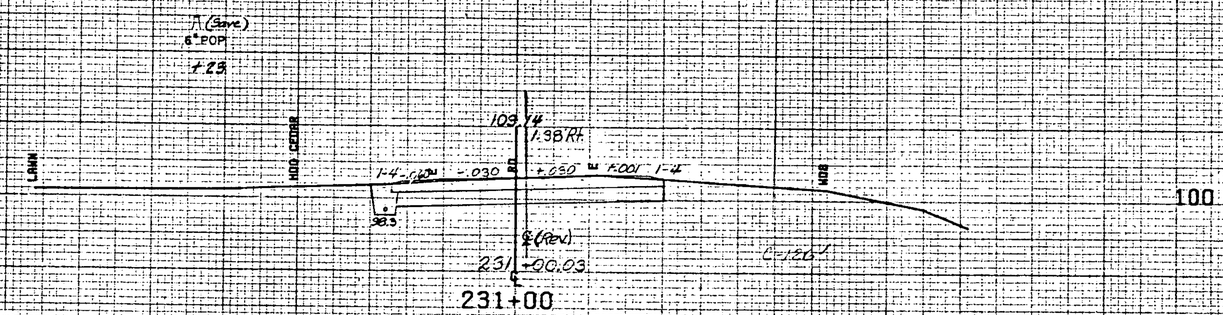

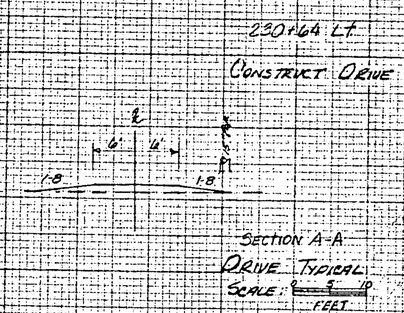

For Banking Transition
See Sheet 56 of 64 Sheets

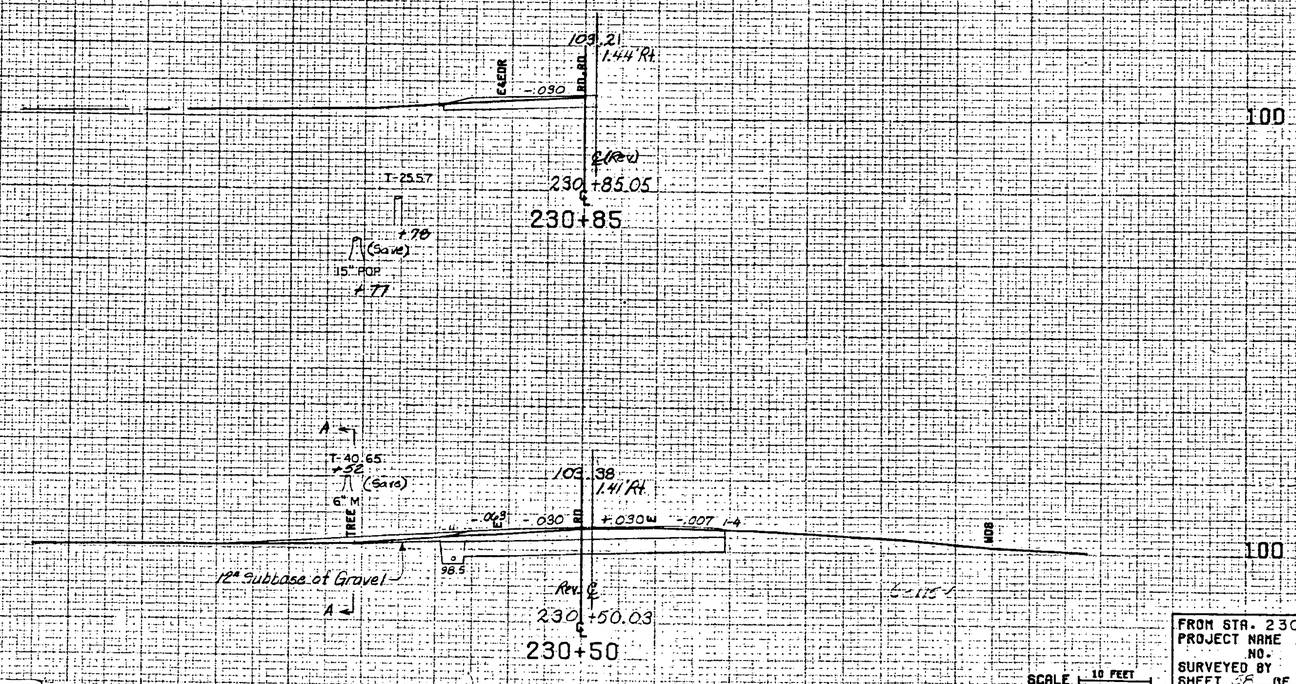

FROM STA. 230+50 TO STA. 231+00
PROJECT NAME HIGHGATE
NO. BRS0285(11)S PLOTTED 11/24/81
SURVEYED BY FANTONI SEPT. 1981
SHEET 55 OF 64 SHEETS