


PAVEMENT TRANSITION
SCALE 1" = 10 FEET

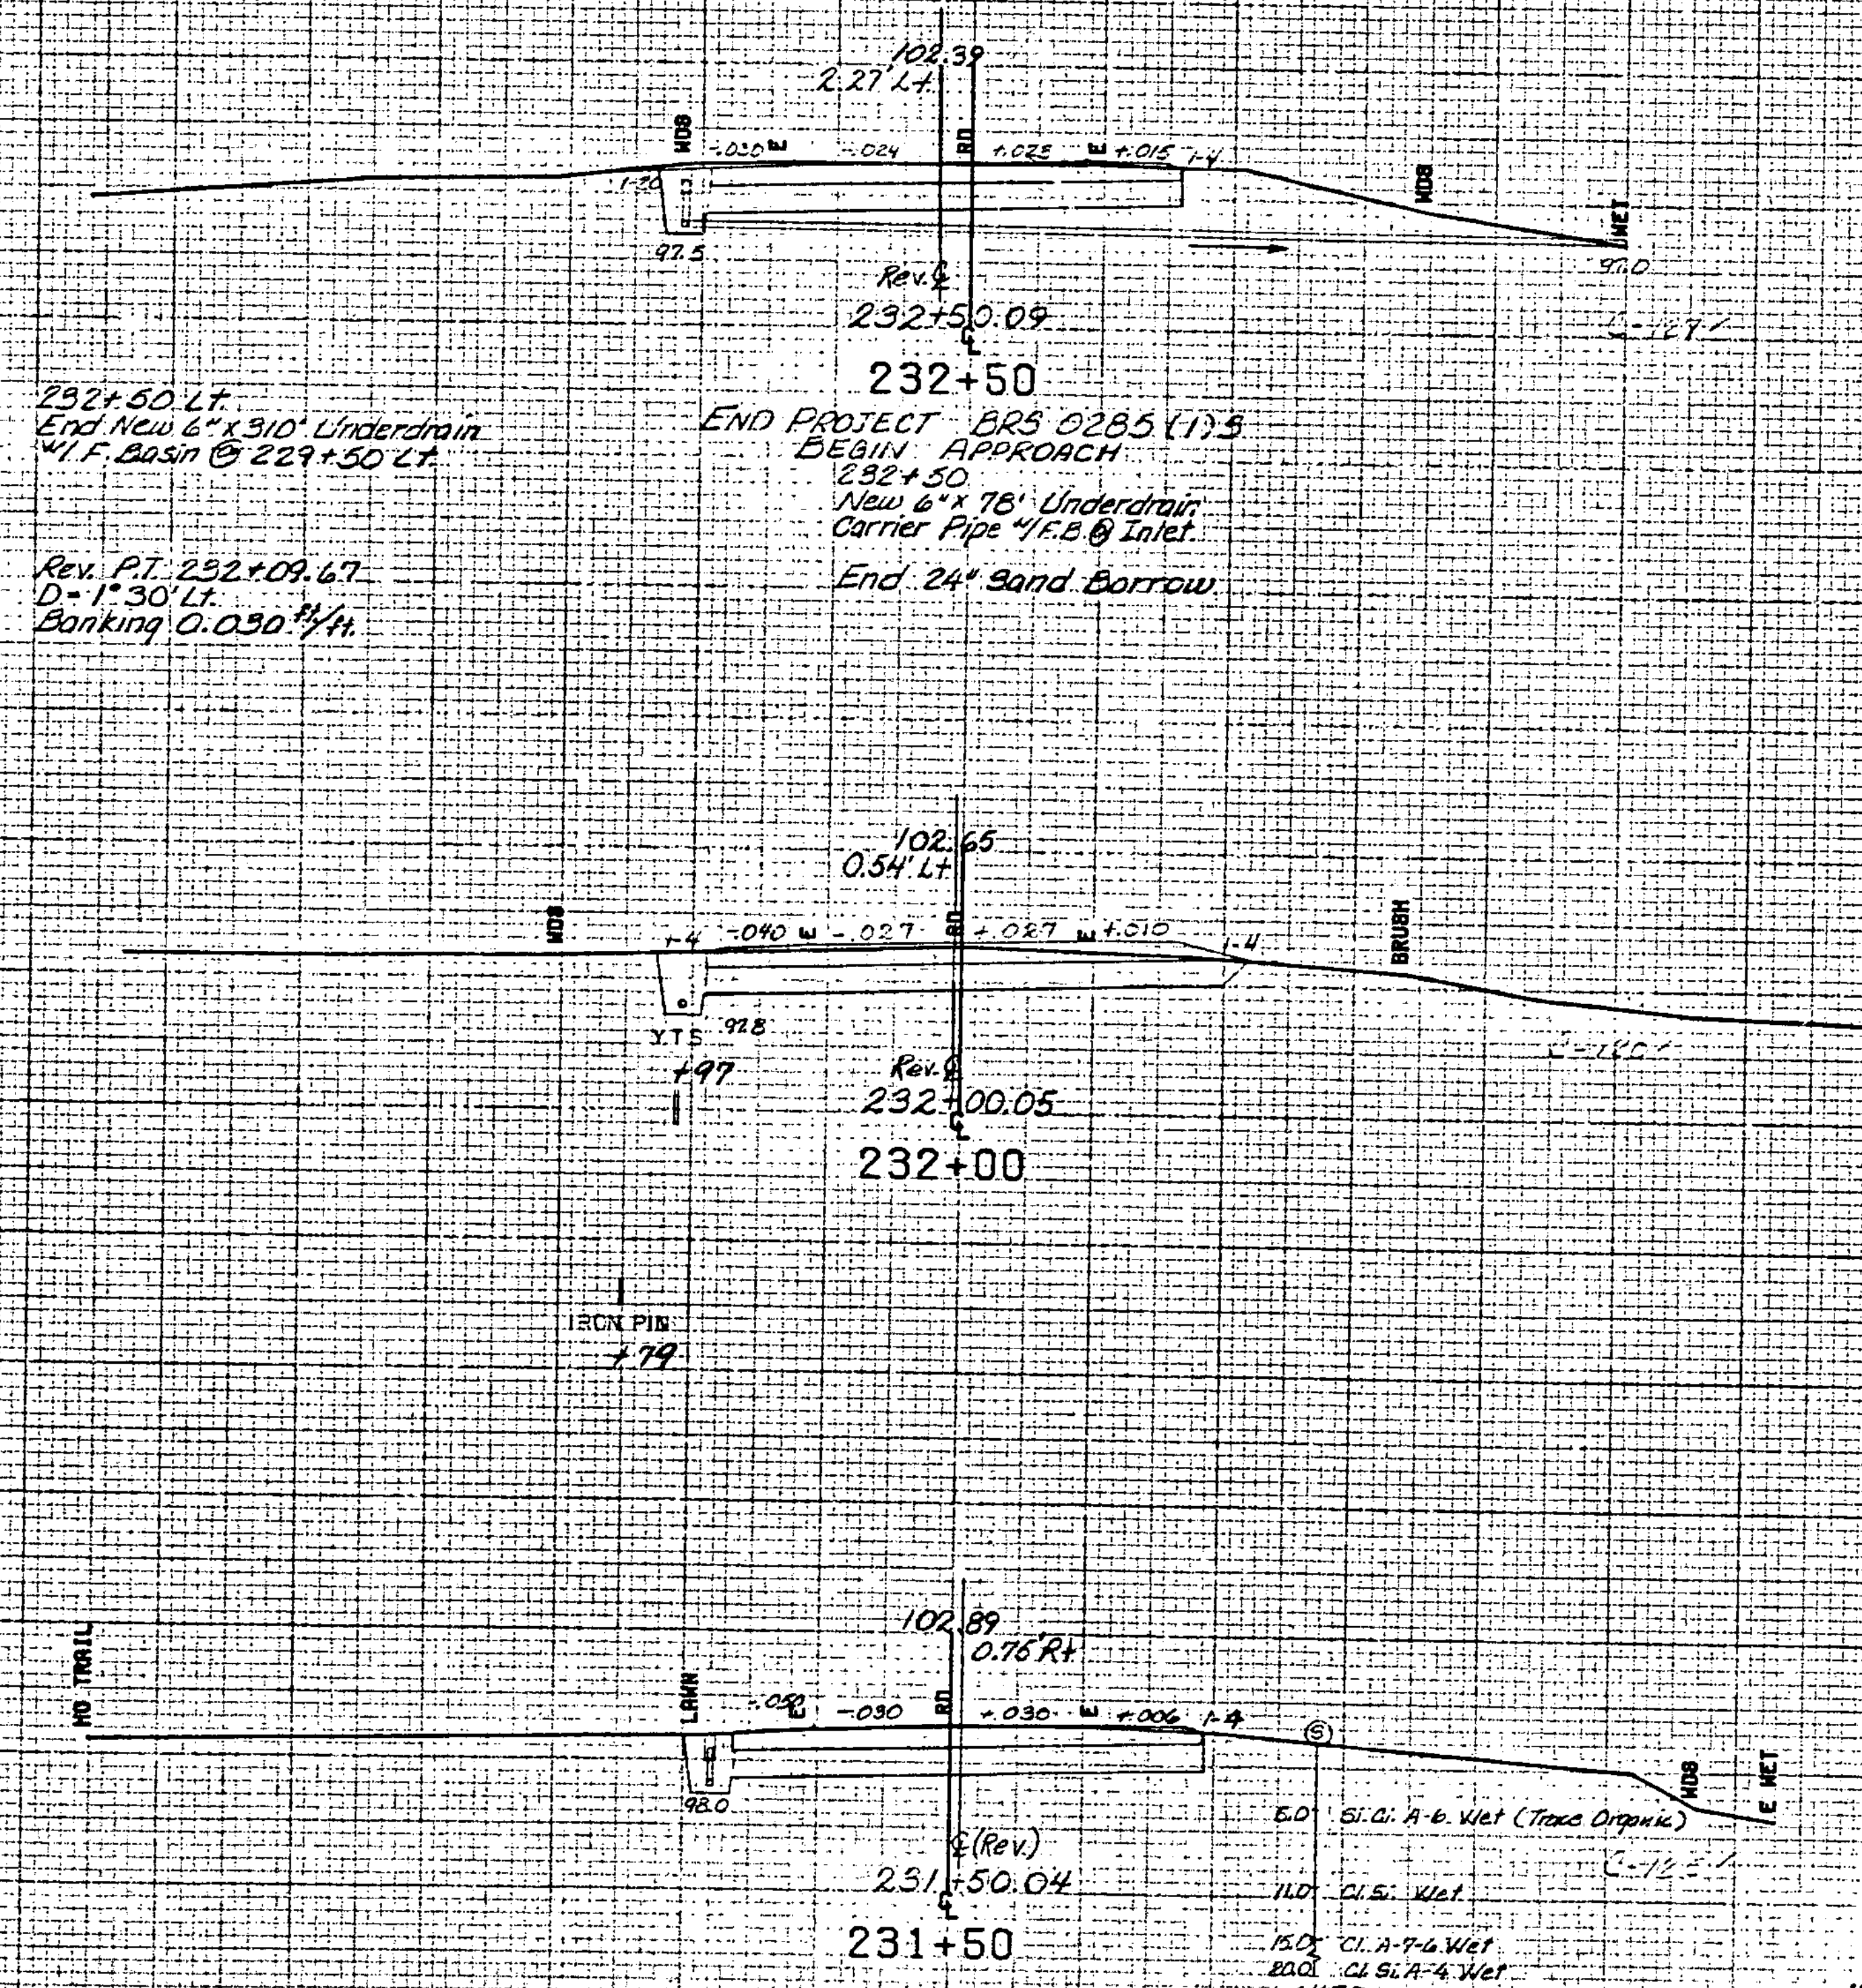

FROM STA. 231+50 TO STA. 232+50
PROJECT NAME HIGHGATE
NO. BR50285(1) 3
SURVEYED BY FANTONI
SHEET 59 OF 64 SHEETS
PLOTTED 11/24/81
SEPT. 1981

SCALE 1" = 10 FEET