VAOT Metric

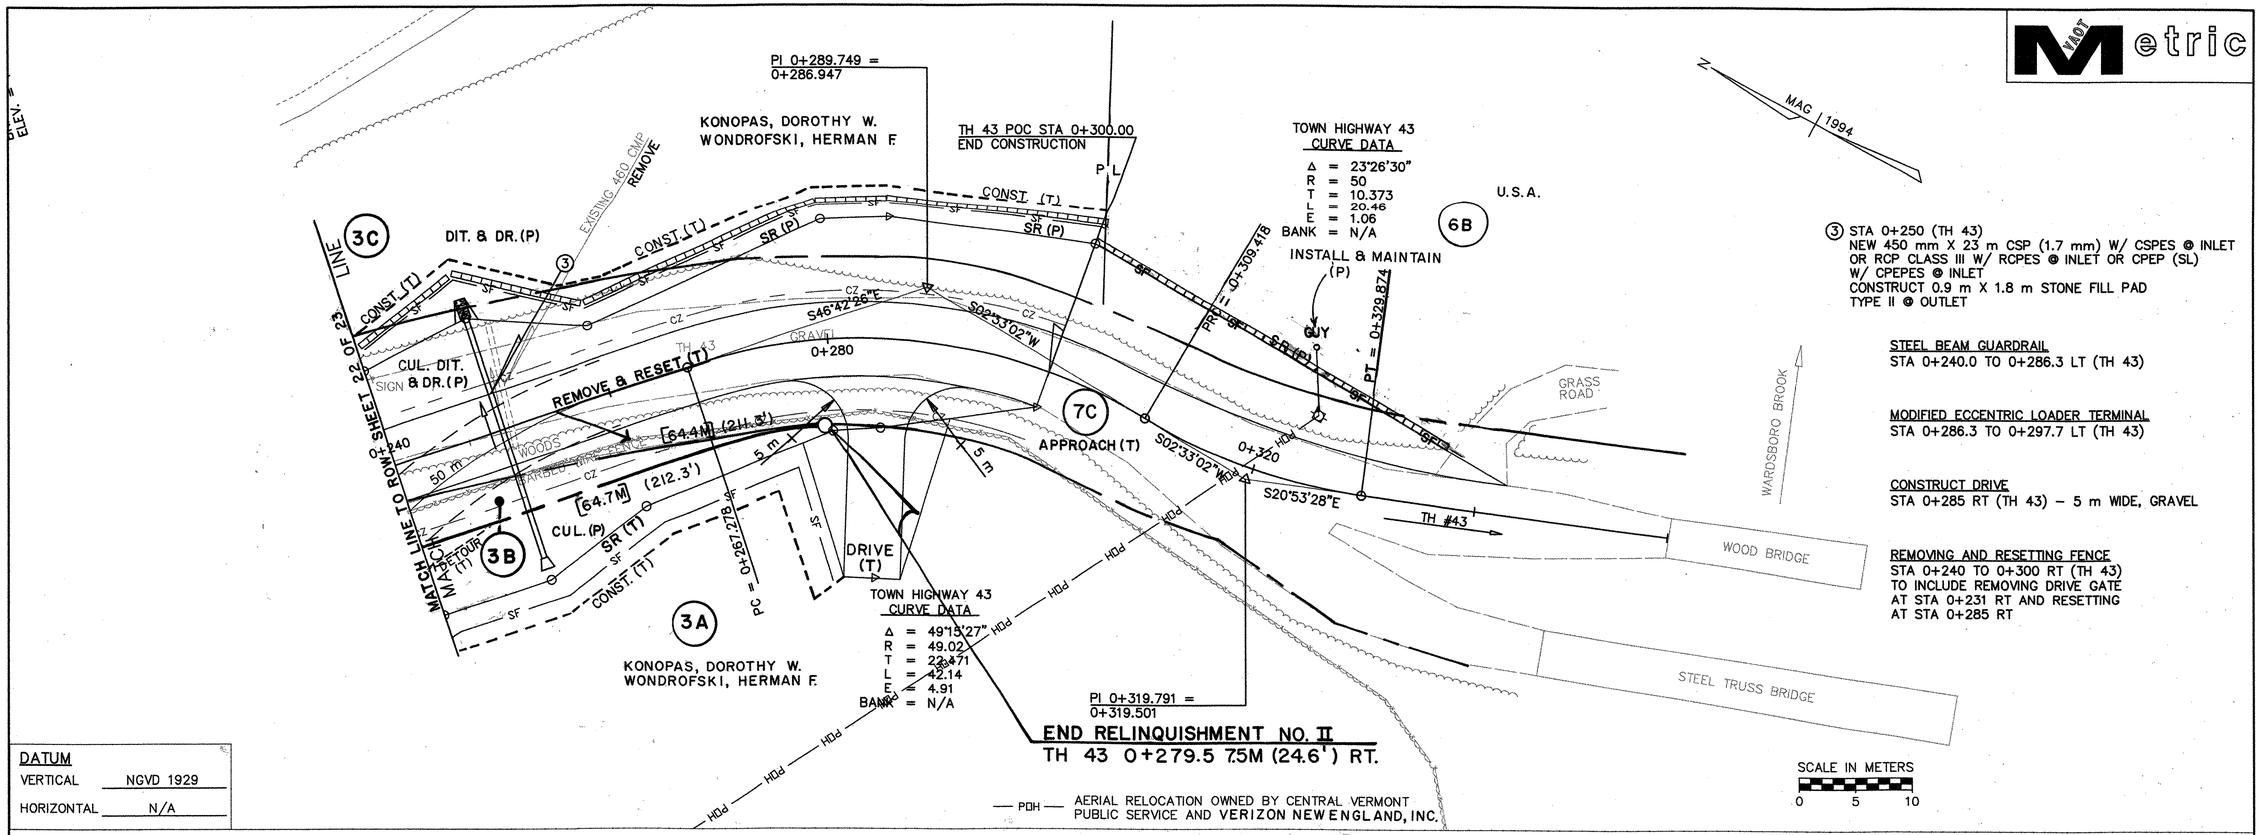

③ STA 0+250 (TH 43)
NEW 450 mm X 23 m CSP (1.7 mm) W/ CSPES @ INLET
OR RCP CLASS III W/ RCPES @ INLET OR CPEP (SL)
W/ CPEPES @ INLET
CONSTRUCT 0.9 m X 1.8 m STONE FILL PAD
TYPE II @ OUTLET

STEEL BEAM GUARDRAIL
STA 0+240.0 TO 0+286.3 LT (TH 43)

MODIFIED ECCENTRIC LOADER TERMINAL
STA 0+286.3 TO 0+297.7 LT (TH 43)

CONSTRUCT DRIVE
STA 0+285 RT (TH 43) – 5 m WIDE, GRAVEL

REMOVING AND RESETTING FENCE
STA 0+240 TO 0+300 RT (TH 43)
TO INCLUDE REMOVING DRIVE GATE
AT STA 0+231 RT AND RESETTING
AT STA 0+285 RT

— PDH — AERIAL RELOCATION OWNED BY CENTRAL VERMONT PUBLIC SERVICE AND VERIZON NEW ENGLAND, INC.

DATUM
VERTICAL NGVD 1929
HORIZONTAL N/A

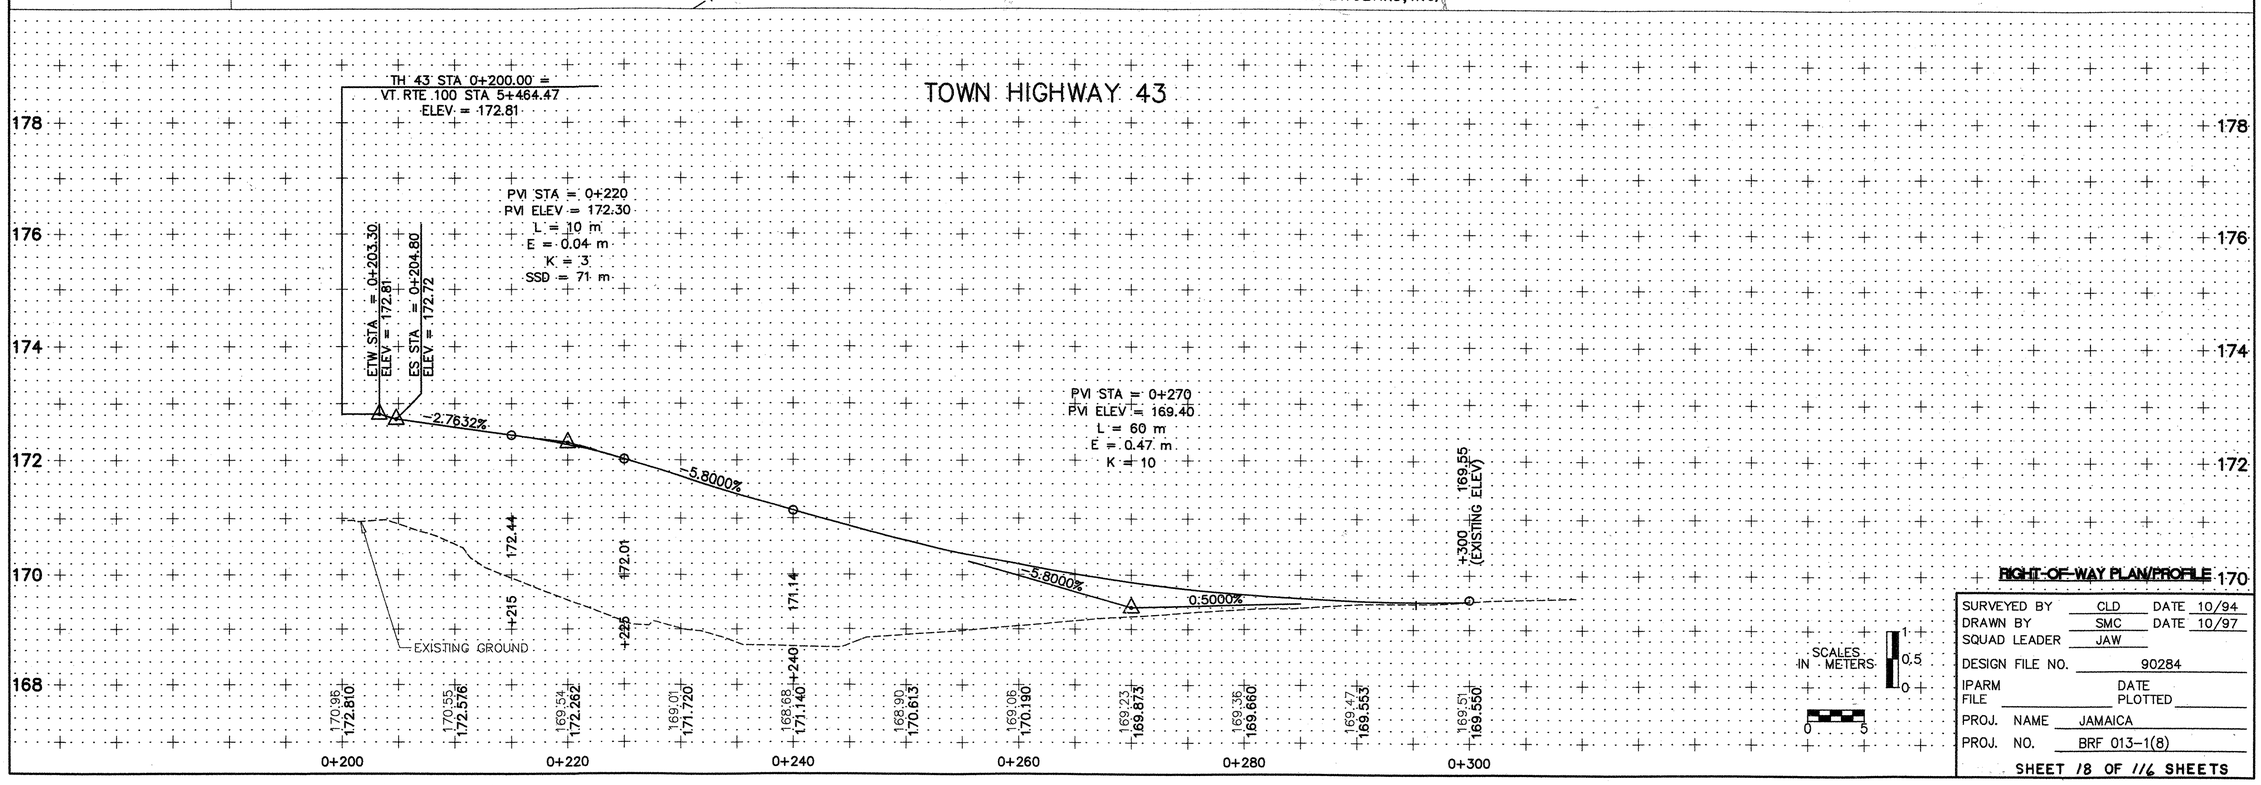

RIGHT-OF-WAY PLAN/PROFILE

SURVEYED BY	CLD	DATE	10/94
DRAWN BY	SMC	DATE	10/97
SQUAD LEADER	JAW		
DESIGN FILE NO.	90284		
IPARM FILE		DATE PLOTTED	
PROJ. NAME	JAMAICA		
PROJ. NO.	BRF 013-1(8)		

SHEET 18 OF 116 SHEETS

90284-PL.dwg 05/18/00 02:50:59 PM PM EDT