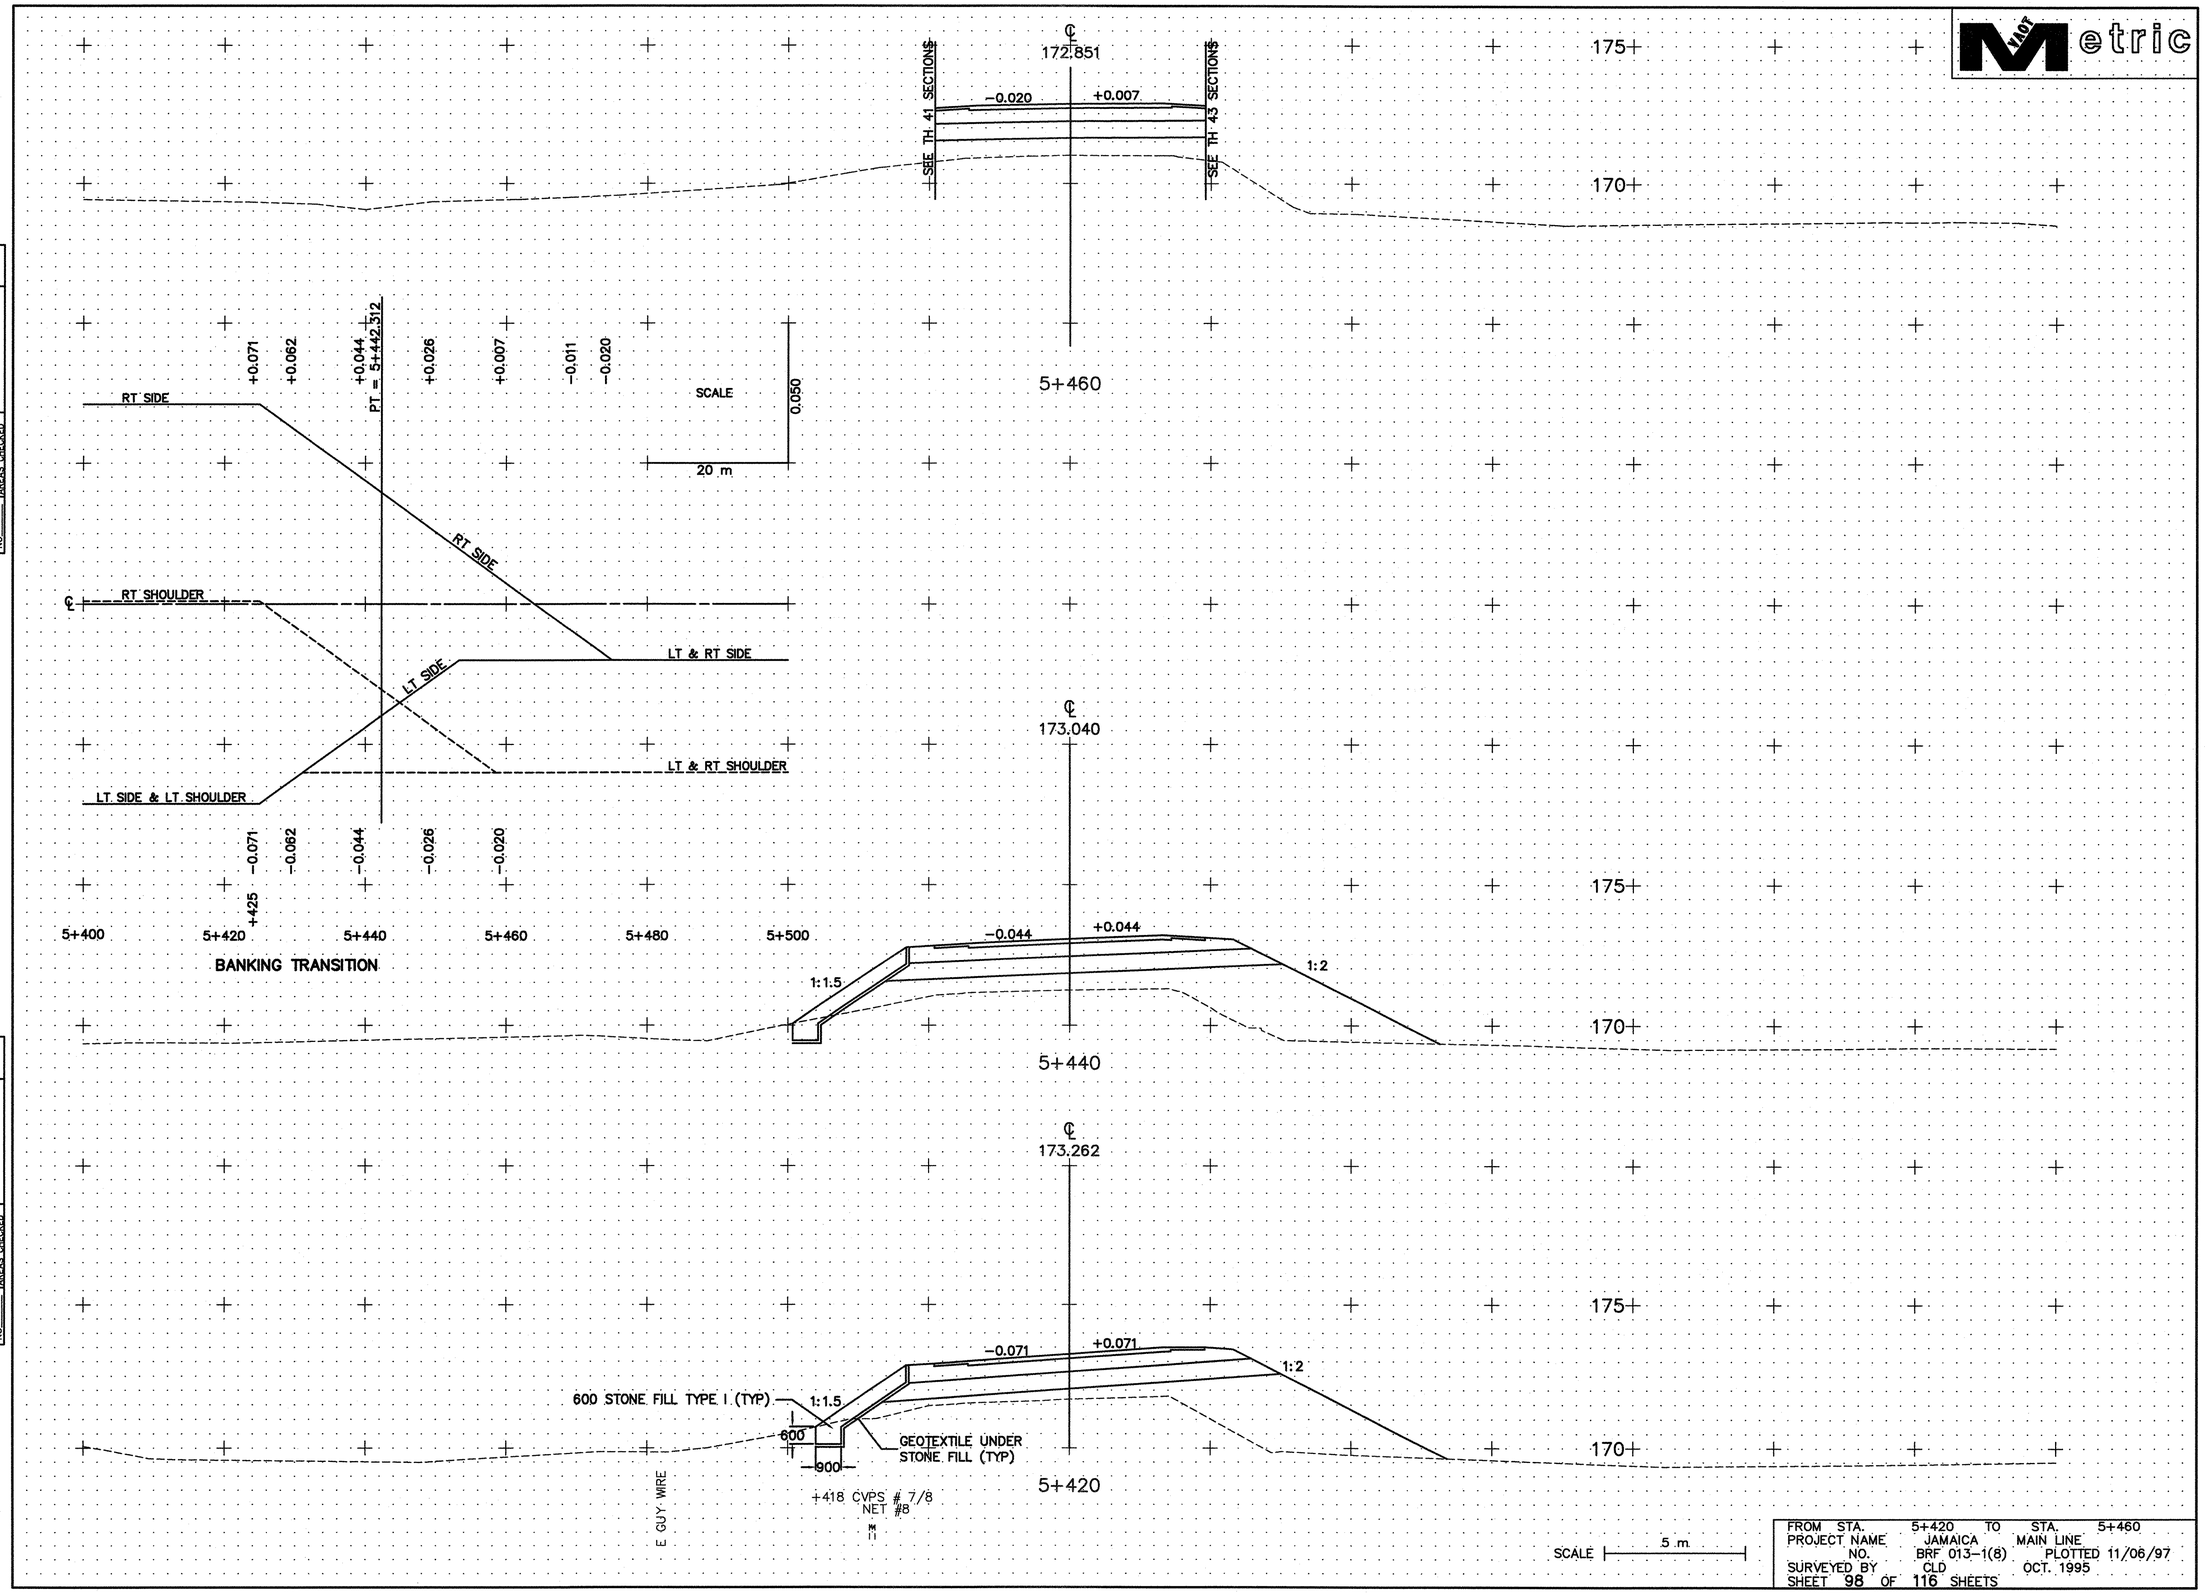

FINAL SURVEY	BY	DATE
NOTEBOOK NO.	SURVEYED PLOTTED TEMPLATE AREAS AREAS CHECKED	

ORIGINAL SURVEY	BY	DATE
NOTEBOOK NO.	SURVEYED PLOTTED TEMPLATE AREAS AREAS CHECKED	