Metric

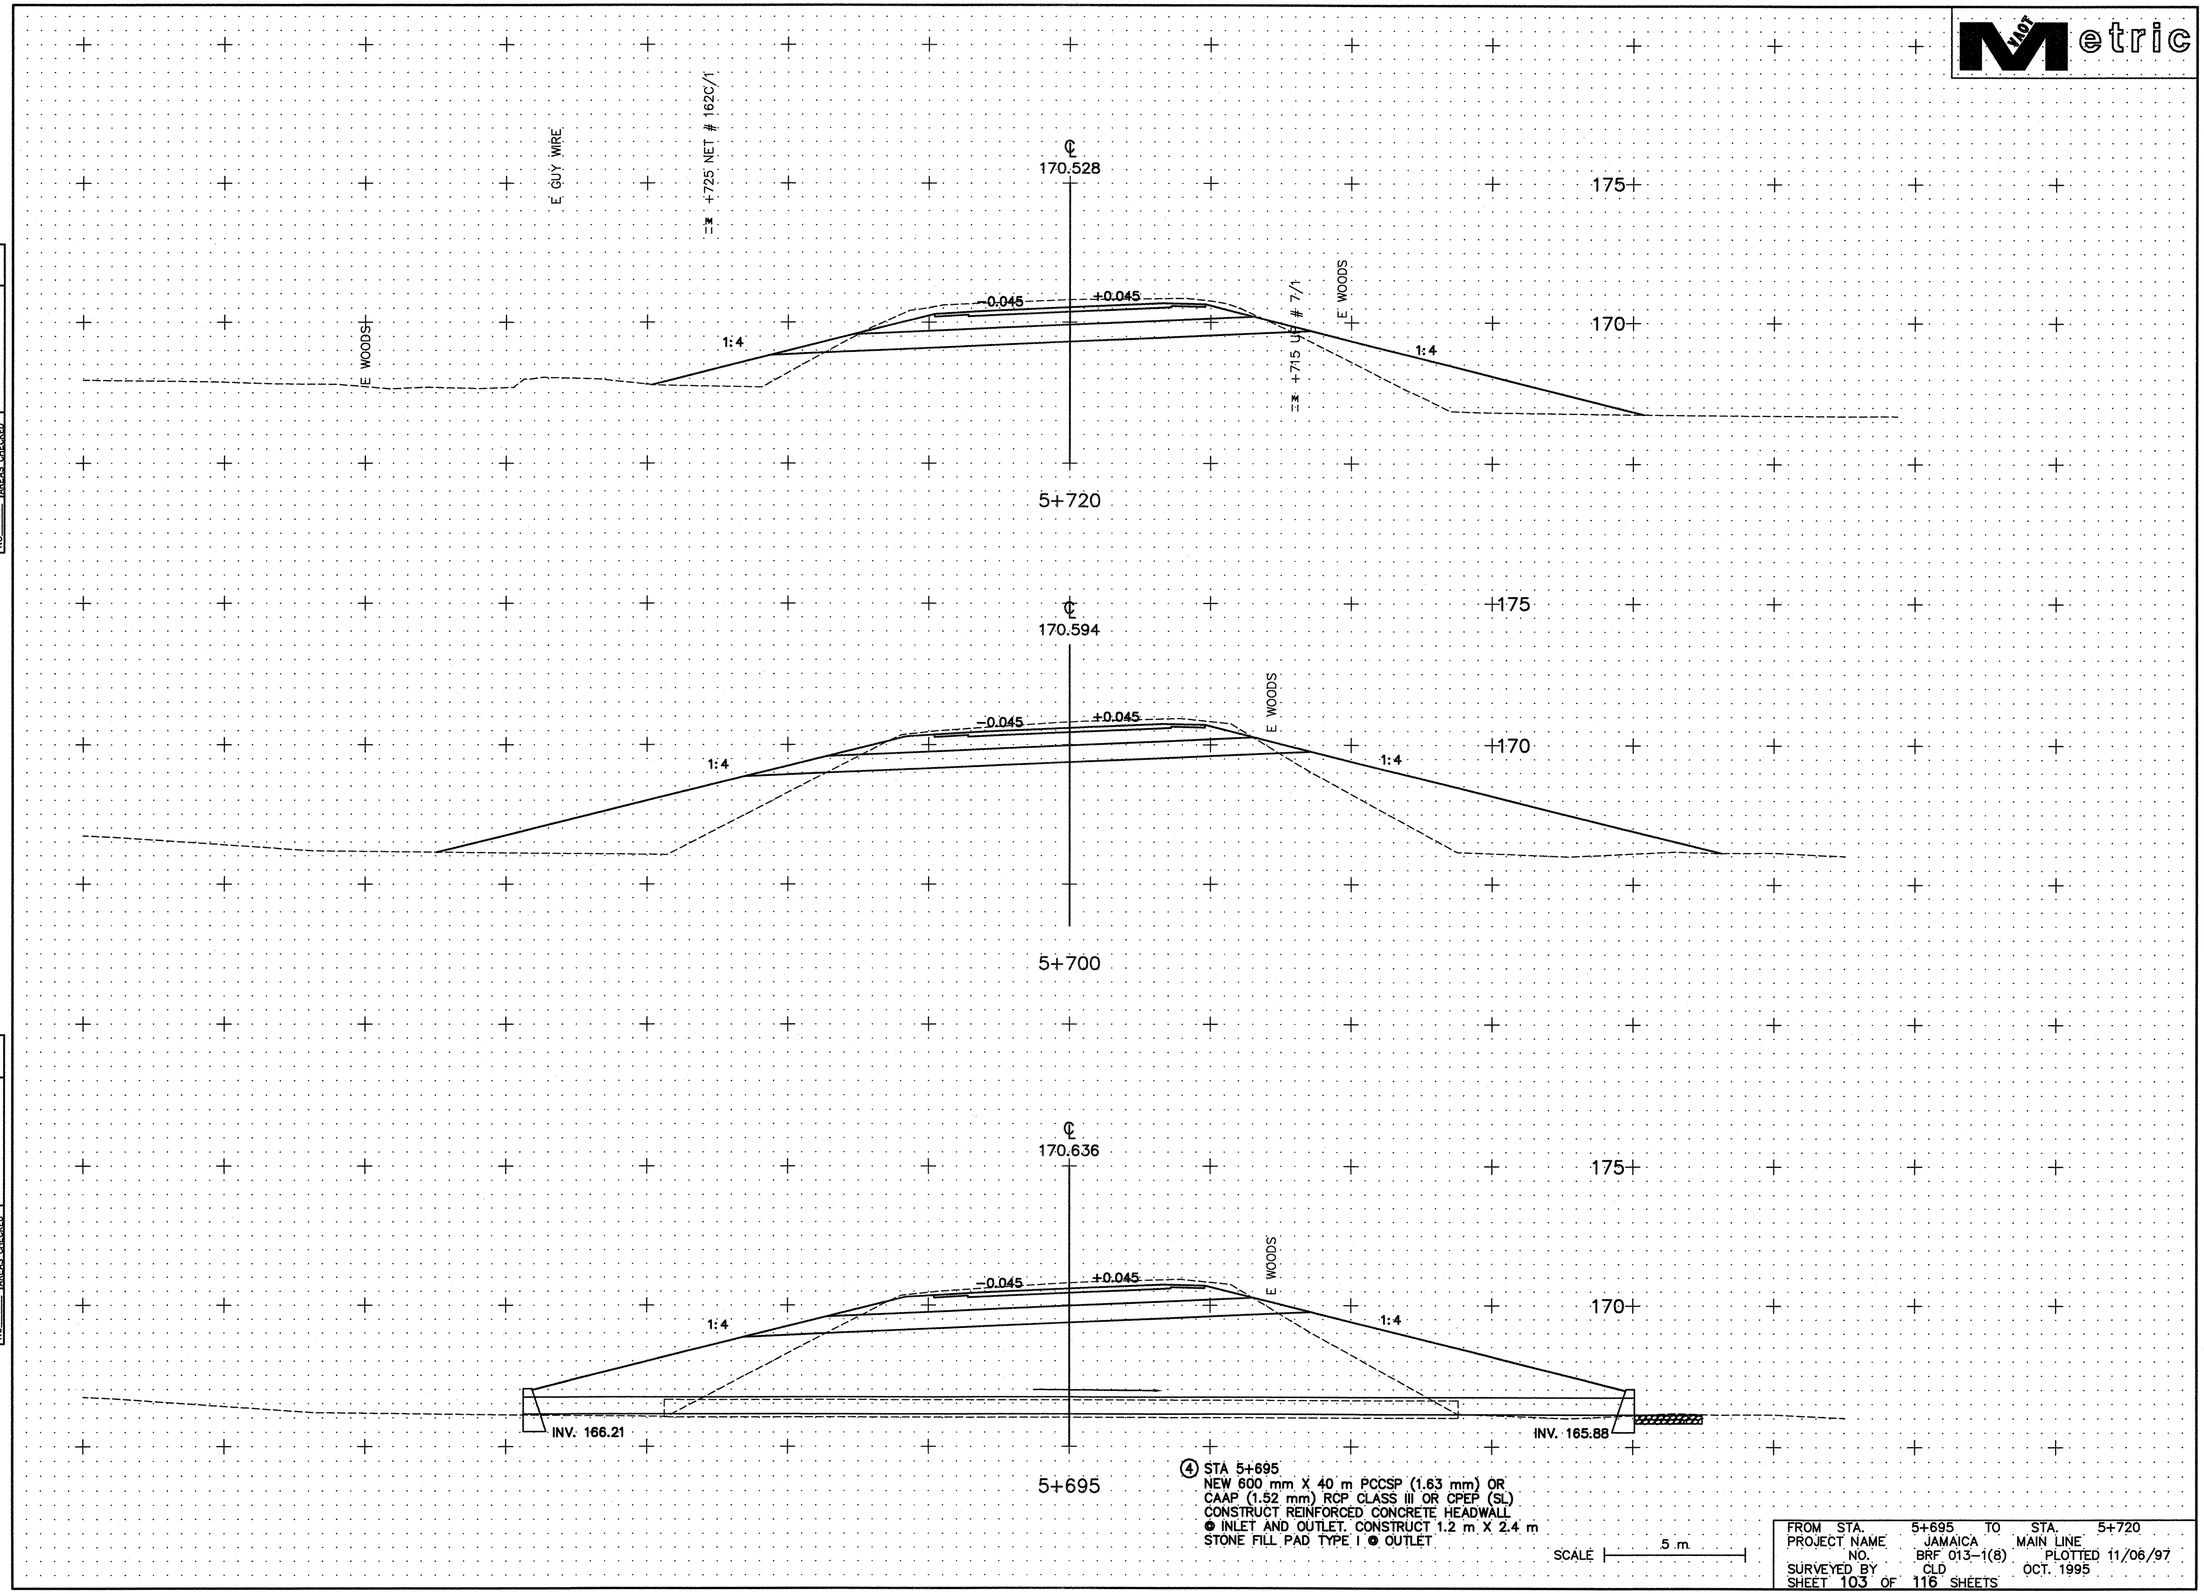

FROM STA.	5+695	TO STA.	5+720
PROJECT NAME	JAMAICA	MAIN LINE	
NO.	BRF 013-1(8)	PLOTTED	11/06/97
SURVEYED BY	CLD	OCT. 1995	
SHEET 103 OF 116 SHEETS			

FINAL SURVEY		BY	DATE
NOTEBOOK NO.	SURVEYED		
	PLOTTED		
	TEMPLATE		
	AREAS CHECKED		

ORIGINAL SURVEY		BY	DATE
NOTEBOOK NO.	SURVEYED		
	PLOTTED		
	TEMPLATE		
	AREAS CHECKED		