Metric

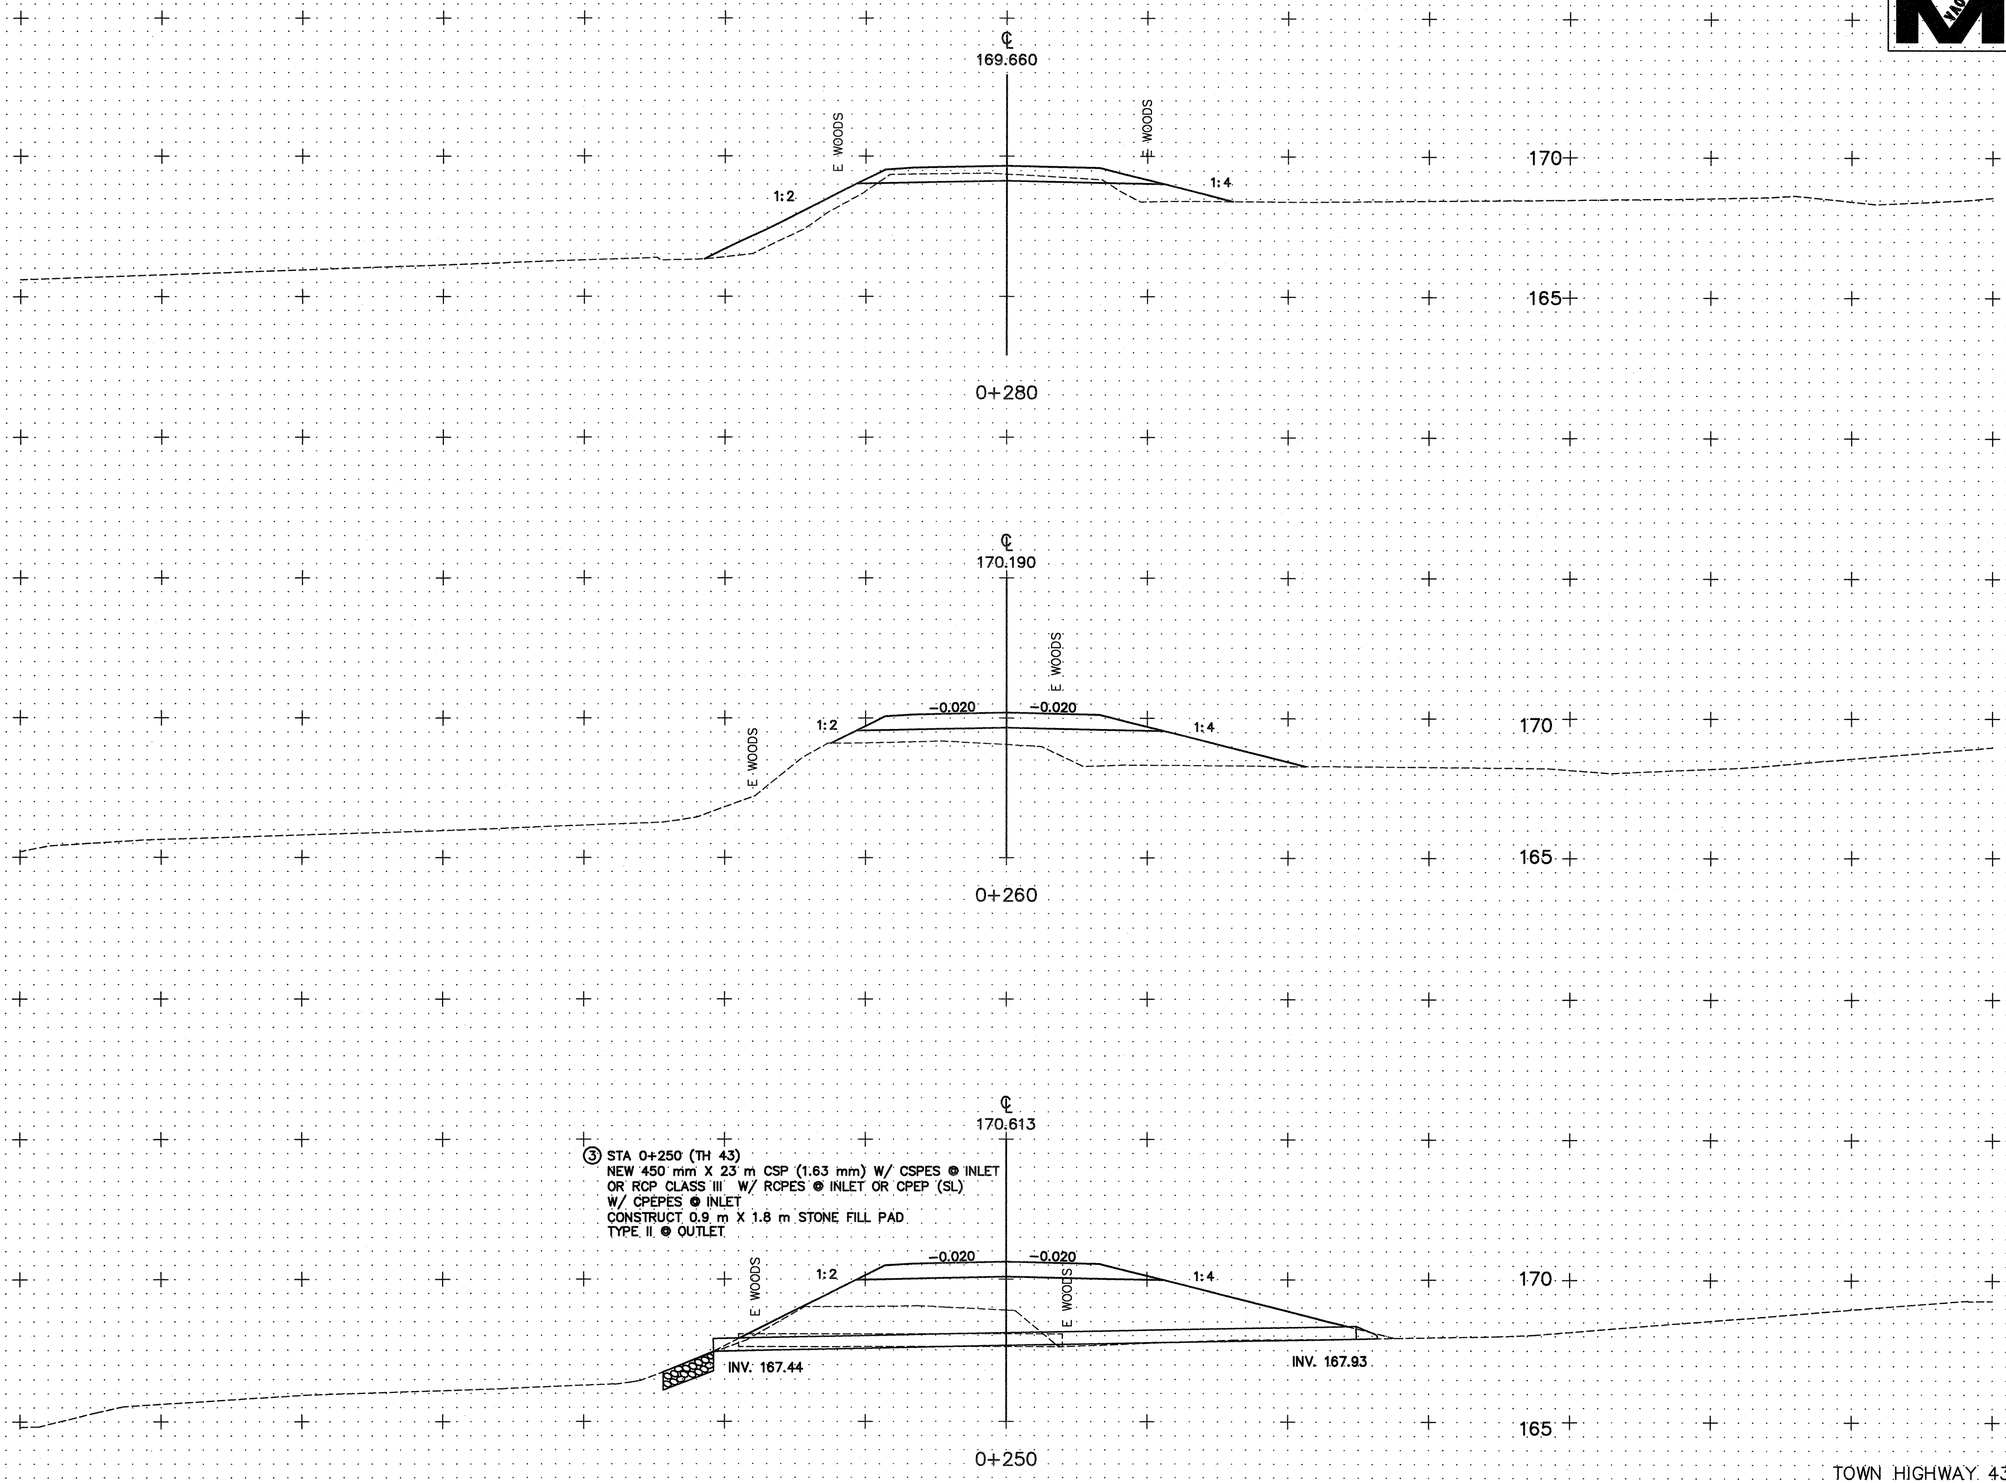

FINAL SURVEY	BY	DATE
NOTEBOOK NO.	SURVEYED PLOTTED TEMPLATE AREAS AREAS CHECKED	

ORIGINAL SURVEY	BY	DATE
NOTEBOOK NO.	SURVEYED PLOTTED TEMPLATE AREAS AREAS CHECKED	

SCALE 5 m

TOWN HIGHWAY 43

FROM STA. 0+260 TO STA. 0+280
PROJECT NAME JAMAICA TH 43
NO. BRF 013-1(8) PLOTTED 11/06/97
SURVEYED BY CLD OCT. 1995
SHEET 112 OF 116 SHEETS