FINAL SURVEY	BY	DATE
SURVEYED		
PLOTTED		
TEMPLATE		
AREAS		
AREAS CHECKED		
NOTEBOOK NO.		

ORIGINAL SURVEY	BY	DATE
SURVEYED		
PLOTTED		
TEMPLATE		
AREAS		
AREAS CHECKED		
NOTEBOOK NO.		

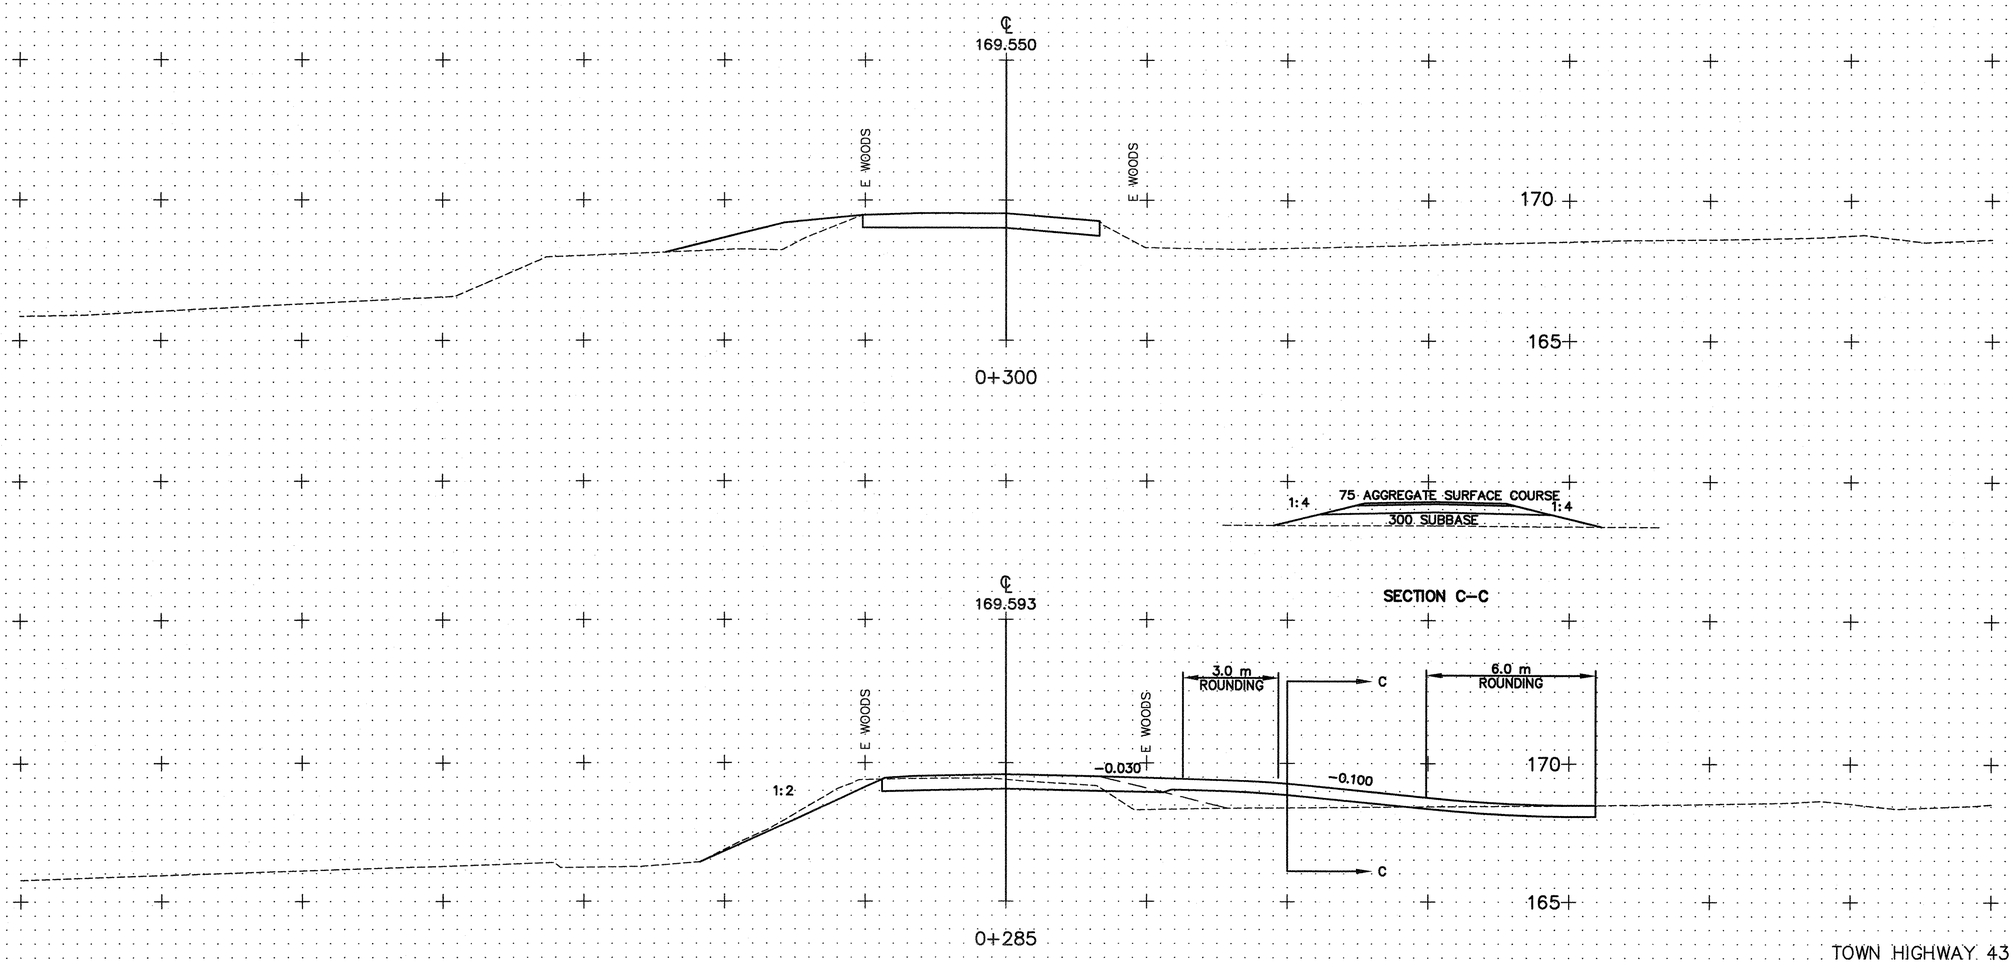

TOWN HIGHWAY 43

FROM STA. 0+285 TO STA. 0+300
PROJECT NAME JAMAICA TH 43
NO. BRF 013-1(8) PLOTTED 11/06/97
SURVEYED BY CLD OCT. 1995
SHEET 113 OF 116 SHEETS