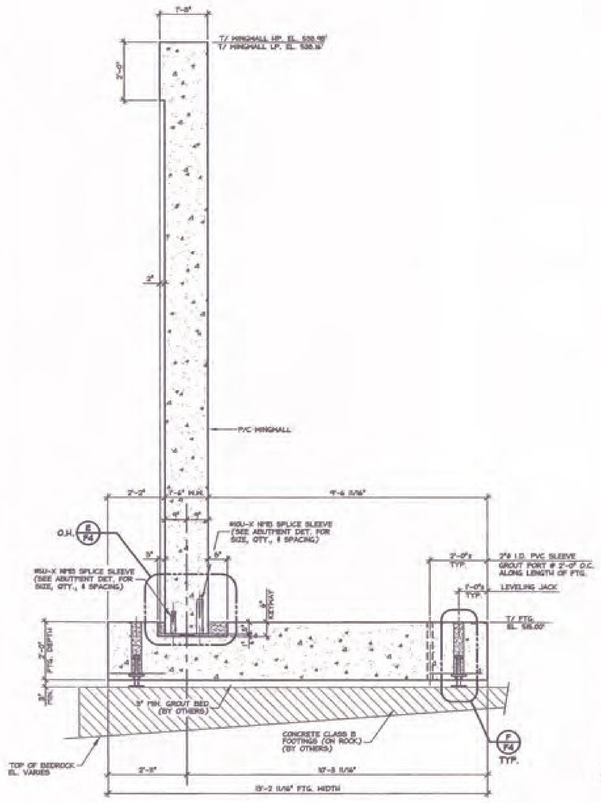

A F3.1 SECTION AT WINGWALL (SH-WW3)
1/2" = 1'-0"

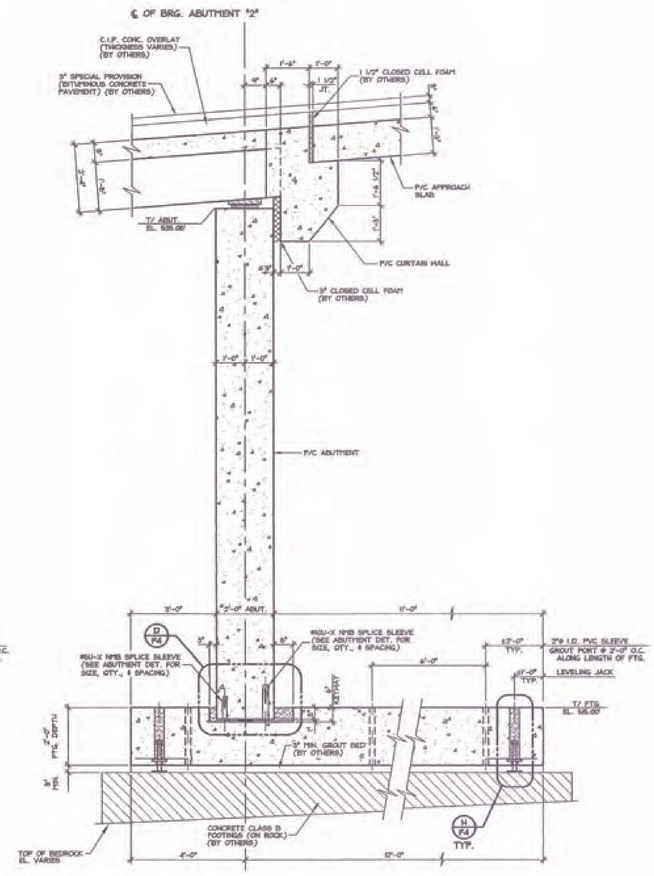

B F3.1 SECTION AT ABUTMENT #2
1/2" = 1'-0"

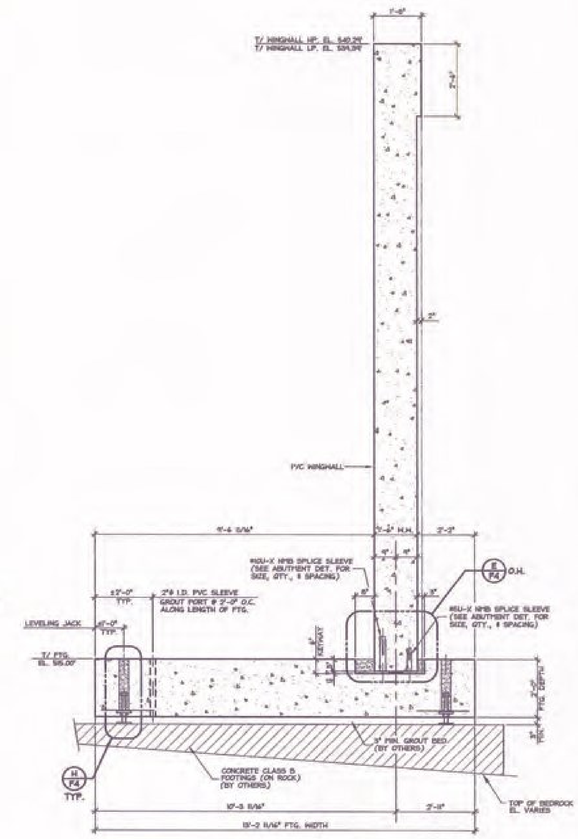

C F3.1 SECTION AT WINGWALL (SH-WW4)
1/2" = 1'-0"

SUBMITTED
JAN 27 2014
J.P. CARRARA & SONS, INC.
MIDDLEBURY, VT 05753

Vermont Agency of Transportation
RECEIVED
ON: January 28, 2014
and Checked for
CONFORMANCE
BY: Jennifer Fitch DATE: 02/04/2014

SHOP DRAWING REVIEW
X REVIEWED AS NOTED BY THE CONSTRUCTION CONTRACT DOCUMENTS AND APPROVED, BUT ONLY FOR CONFORMANCE TO THE DESIGN CONCEPT OF THE WORK, AND SUBJECT TO FURTHER LIMITATIONS AND RESERVATIONS CONTAINED IN THE CONSTRUCTION CONTRACT DOCUMENTS.
☐ REJECTED ☐ REVISED AND RESUBMIT ☐ REVIEWED AS CORRECTED
CONSTRUCTION OF COMMENTS MADE ON THE SHOP DRAWINGS DURING THIS REVIEW DO NOT RELIEVE CONTRACTOR FROM COMPLIANCE WITH REQUIREMENTS OF THE DRAWINGS AND SPECIFICATIONS. THE CHECK IS ONLY FOR REVIEW OF GENERAL CONFORMANCE WITH THE DESIGN CONCEPT OF THE PROJECT AND GENERAL COMPLIANCE WITH THE INFORMATION GIVEN IN THE CONTRACT DRAWINGS. THE CONTRACTOR IS RESPONSIBLE FOR: QUANTITIES AND DIMENSIONS, FABRICATION PROCESSES AND TECHNIQUES OF CONSTRUCTION, COORDINATING THE WORK WITH THAT OF ALL OTHER TRADES, AND PERFORMING HIS WORK IN A SAFE AND SATISFACTORY MANNER.
VHB Vanasse Hangen Brustlin, Inc. Job Number: 57438 Reviewed by: M.J. Moore Date: 1-31-2014
1-27-14 GENERAL REVISION T.D.

APPROVAL STAMP:

J.P. CARRARA & SONS INC. Precast & Prestress Manufacturer 2454 CASE RD., MIDDLEBURY, VERMONT 05753 Phone:(802)388-6381 Fax:(802)388-9016	T. BUCK CONSTRUCTION CONTRACTOR AUBURN, MAINE
STATE OF VERMONT AGENCY OF TRANSPORTATION COUNTY OF ADDISON	DATE: OCT. 4, 2013 / SCALE: NOTED
TOWN OF MIDDLEBURY ROUTE NO. VT 125, EAST MIDDLEBURY GORGE BRIDGE NO.: 15 PROJECT NO.: BRS 0174(8)	CHKD: / DFTM: T.D. / JOB NO: 23411-013
ABUTMENT 2 & WINGWALL SECTIONS	DWG. NO: F3.1