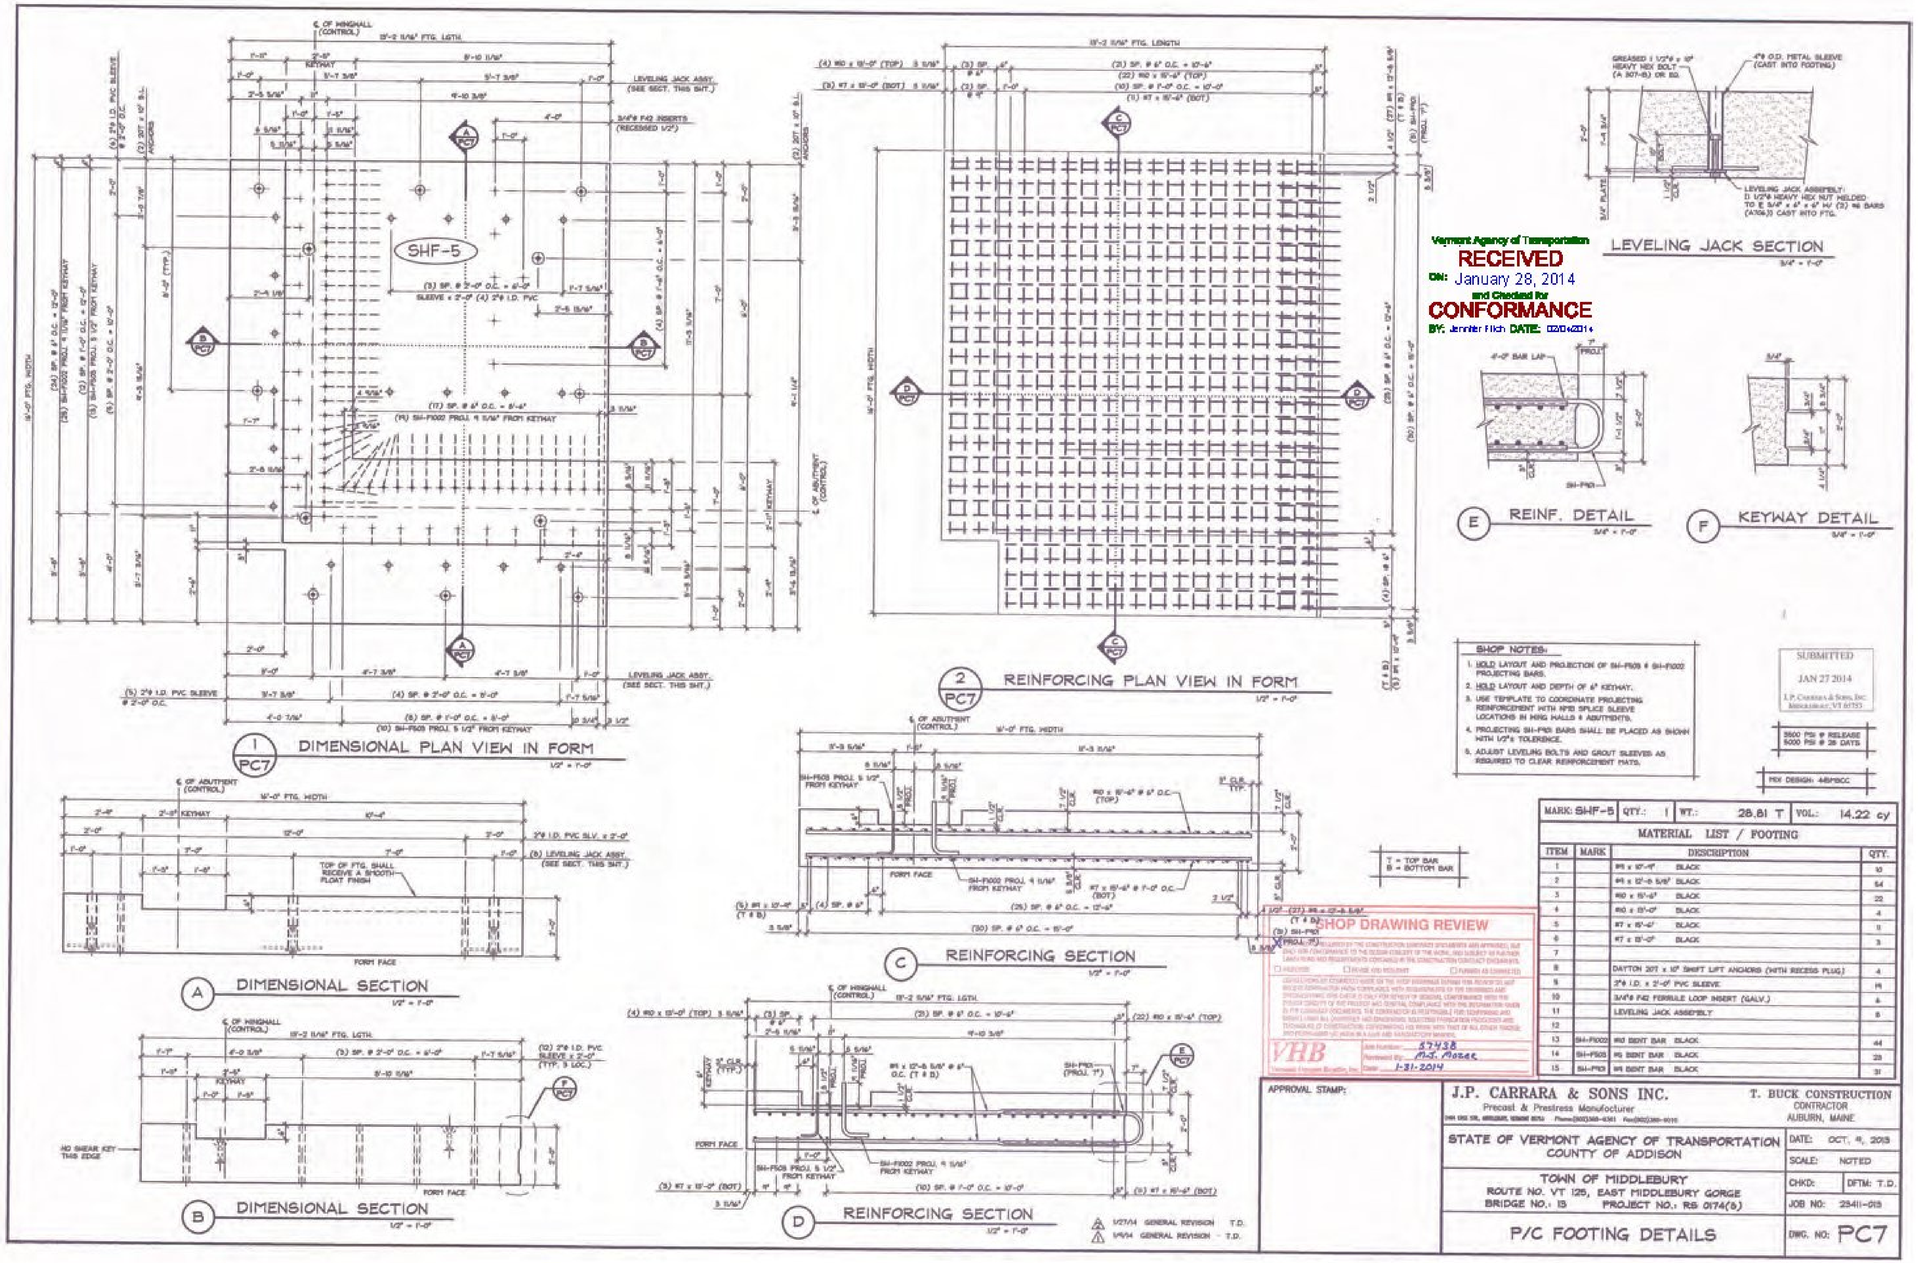

MARK: SHF-5	QTY.: 1	WT.: 28.81 T	VOL.: 14.22 cy

MATERIAL LIST / FOOTING

ITEM	MARK	DESCRIPTION	QTY.
1		#5 x 10'-9" BLACK	10
2		#4 x 12'-6 5/8" BLACK	54
3		#10 x 15'-6" BLACK	22
4		#10 x 13'-0" BLACK	4
5		#7 x 15'-6" BLACK	11
6		#7 x 13'-0" BLACK	3
7			
8		DAYTON 207 x 10" SHIFT LIFT ANCHORS (WITH RECESS PLUG)	4
9		2"ø I.D. x 2'-0" PVC SLEEVE	19
10		3/4"ø F42 FERRULE LOOP INSERT (GALV.)	6
11		LEVELING JACK ASSEMBLY	6
12			
13	SH-P1002	#10 BENT BAR BLACK	44
14	SH-P505	#5 BENT BAR BLACK	23
15	SH-P101	#4 BENT BAR BLACK	31

APPROVAL STAMP:

J.P. CARRARA & SONS INC.
Precast & Prestress Manufacturer
594 VT Rte. 30B, Middlebury, Vermont 05753 Phone:(802)388-6361 Fax:(802)388-6110

T. BUCK CONSTRUCTION
CONTRACTOR
AUBURN, MAINE

STATE OF VERMONT AGENCY OF TRANSPORTATION
COUNTY OF ADDISON

TOWN OF MIDDLEBURY
ROUTE NO. VT 125, EAST MIDDLEBURY GORGE
BRIDGE NO.: 13 PROJECT NO.: BRS 0174(5)

P/C FOOTING DETAILS

DATE: OCT. 4, 2013
SCALE: NOTED
CHKD: DFTM: T.D.
JOB NO: 23411-013
DWG. NO: PC7

1/27/14 GENERAL REVISION T.D.
1/9/14 GENERAL REVISION T.D.