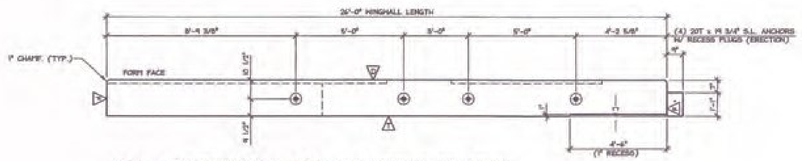

1 DIMENSIONAL TOP ELEVATION IN FORM
3/8" = 1'-0"

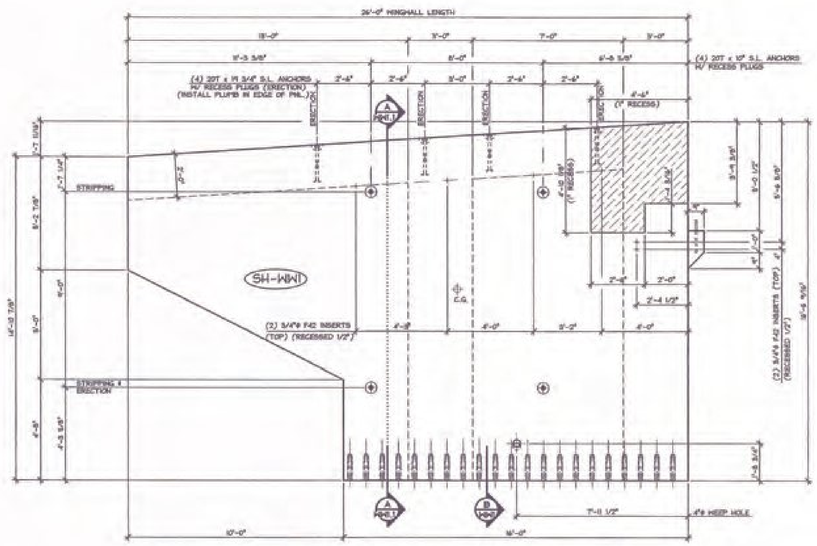

2 DIMENSIONAL PLAN VIEW IN FORM
3/8" = 1'-0"

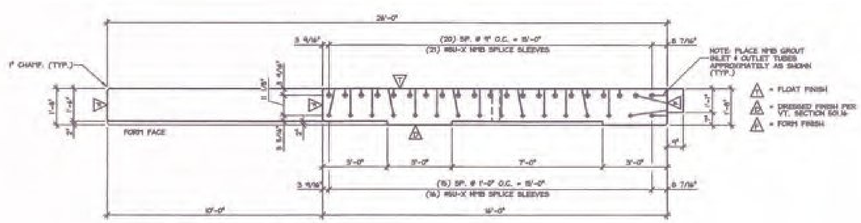

3 DIMENSIONAL BOT. ELEVATION IN FORM
3/8" = 1'-0"

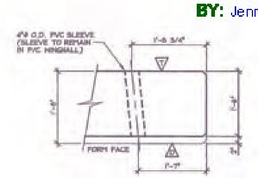

B WEEP HOLE DETAIL
1" = 1'-0"

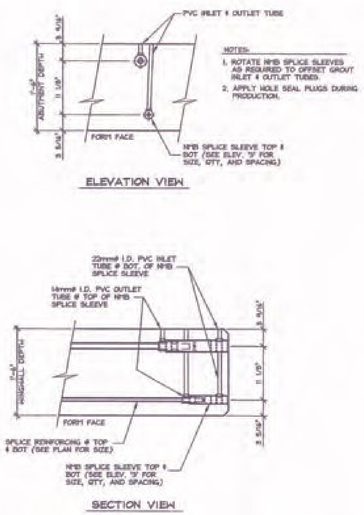

C NMB SPLICE SLEEVE DETAILS
1" = 1'-0"

Vermont Agency of Transportation
RECEIVED
ON: January 28, 2014
and Checked for
CONFORMANCE
BY: Jennifer Fitch DATE: 02/04/2014

SUBMITTED
JAN 27 2014
J.P. CARRARA & SONS, INC.
MIDDLEBURY, VT 05753

NOTE: SEE DRAWING WW1.1 FOR REINFORCEMENT

5000 PSI @ RELEASE
5000 PSI @ 28 DAYS

MIX DESIGN: 44SPSCC

MARK: SH-WW1	QTY.: 1	WT.: 39.5 T	VOL.: 19.51 cy

MATERIAL LIST / WINGWALL

ITEM	MARK	DESCRIPTION	QTY.
1			
2			
3			
4			
5		3/4"ø F42 INSERT (GALV.)	6
6			
7		#6U-X NMB SPLICE SLEEVE (EPOXY COATED)	16
8		#6U-X NMB SPLICE SLEEVE (EPOXY COATED)	21
9			
10		DAYTON 20T x 10" SHIFT LIFT (BLACK) (WITH RECESS PLUG)	4
11		DAYTON 20T x 1" 3/4" SHIFT LIFT (BLACK) (WITH RECESS PLUG)	4
12			
13			
14			
15			

SHOP DRAWING REVIEW

X REVIEWED AS REQUIRED BY THE CONSTRUCTION CONTRACT DOCUMENTS AND APPROVED. NOT ONLY FOR CONFORMANCE TO THE DESIGN CONCEPT OF THE WORK, AND IMPACT ITS INSTALLATION ON OTHER WORK AND REQUIREMENTS CONTAINED IN THE CONSTRUCTION CONTRACT DOCUMENTS.

☐ REJECTED ☐ REVISE AND RESUBMIT ☐ MARKED UP CORRECTED

EXCEPTIONS OR COMMENTS MADE ON THE SHOP DRAWING DURING THIS REVIEW DO NOT RELIEVE CONTRACTOR FROM COMPLIANCE WITH REQUIREMENTS OF THE WRITTEN AND PICTORIAL CONTRACT DOCUMENTS. THIS CHECK IS ONLY FOR REVIEW OF GENERAL CONFORMANCE WITH THE DESIGN CONCEPT OF THE PROJECT AND GENERAL COMPLIANCE WITH THE INFORMATION GIVEN IN THE CONTRACT DOCUMENTS. THE CONTRACTOR IS RESPONSIBLE FOR: CONFIRMING AND CORRELATING ALL QUANTITIES AND DIMENSIONS; SELECTING FABRICATION PROCESSES AND TECHNIQUES OF CONSTRUCTION; COORDINATING WORK WITH that OF ALL OTHER TRADES; AND PERFORMING THE WORK IN A SAFE AND SATISFACTORY MANNER.

VHB Vanasse Hangen Brustlin, Inc. Job Number: 57458 Reviewed by: N.A. Date: 1-31-2014

△1 1/27/14 GENERAL REVISION T.D.

APPROVAL STAMP:

J.P. CARRARA & SONS INC.
Precast & Prestress Manufacturer
1969 OLD CHU, MIDDLEBURY, VERMONT 05753 Phone:(802)388-6261 Fax:(802)388-0930

T. BUCK CONSTRUCTION
CONTRACTOR
AUBURN, MAINE

STATE OF VERMONT AGENCY OF TRANSPORTATION
COUNTY OF ADDISON

TOWN OF MIDDLEBURY
ROUTE NO. VT 125, EAST MIDDLEBURY GORGE
BRIDGE NO.: 13 PROJECT NO.: RS 0174(6)

P/C WINGWALL DETAILS

DATE:	OCT. 9, 2013
SCALE:	NOTED
CHKD:	DFTM: T.D.
JOB NO:	23411-013
DWG. NO:	WW1